



WOOD GUARD RAIL REQUIRED  
LEFT  
STA 47+38 TO 47+62 LENGTH 24 FT.  
STA 52+38 TO 52+62 " 24 FT.  
STA 55+38 TO 55+62 " 24 FT.  
TOTAL THIS SHEET 72 FT.

CABLE GUARD RAIL REQUIRED  
RIGHT  
STA 42+00 TO 58+00 LENGTH 1600 FT.  
TOTAL THIS SHEET 1600 FT.

NEW CULVERTS REQUIRED  
STA 47+50 24" REINF CONCRETE PIPE LENGTH 44 FT.  
CONCRETE CLASS A (1-2-4) 26 C.Y.  
REINFORCING STEEL 60 LB.  
STA 52+50 15" REINF CONCRETE PIPE LENGTH 32 FT.  
CONCRETE CLASS B (1-2 1/2-5) 21 C.Y.  
REINFORCING STEEL 33 LB.  
STA 55+50 18" REINF CONCRETE PIPE LENGTH 48 FT.  
CONCRETE CLASS A (1-2-4) 29 C.Y.  
REINFORCING STEEL 60 LB.

FED. ROAD DIST. NO.	STATE	FED. AID PROJ. NO.	FISCAL YEAR	SHEET NO.	TOTAL SHEETS
9	VT	608	1957	7	88

PLAN  
NOTES  
1. SEE SHEET 6 FOR GENERAL NOTES  
2. SEE SHEET 7 FOR GENERAL NOTES  
3. SEE SHEET 8 FOR GENERAL NOTES  
95. SEE SHEET 100 FOR GENERAL NOTES

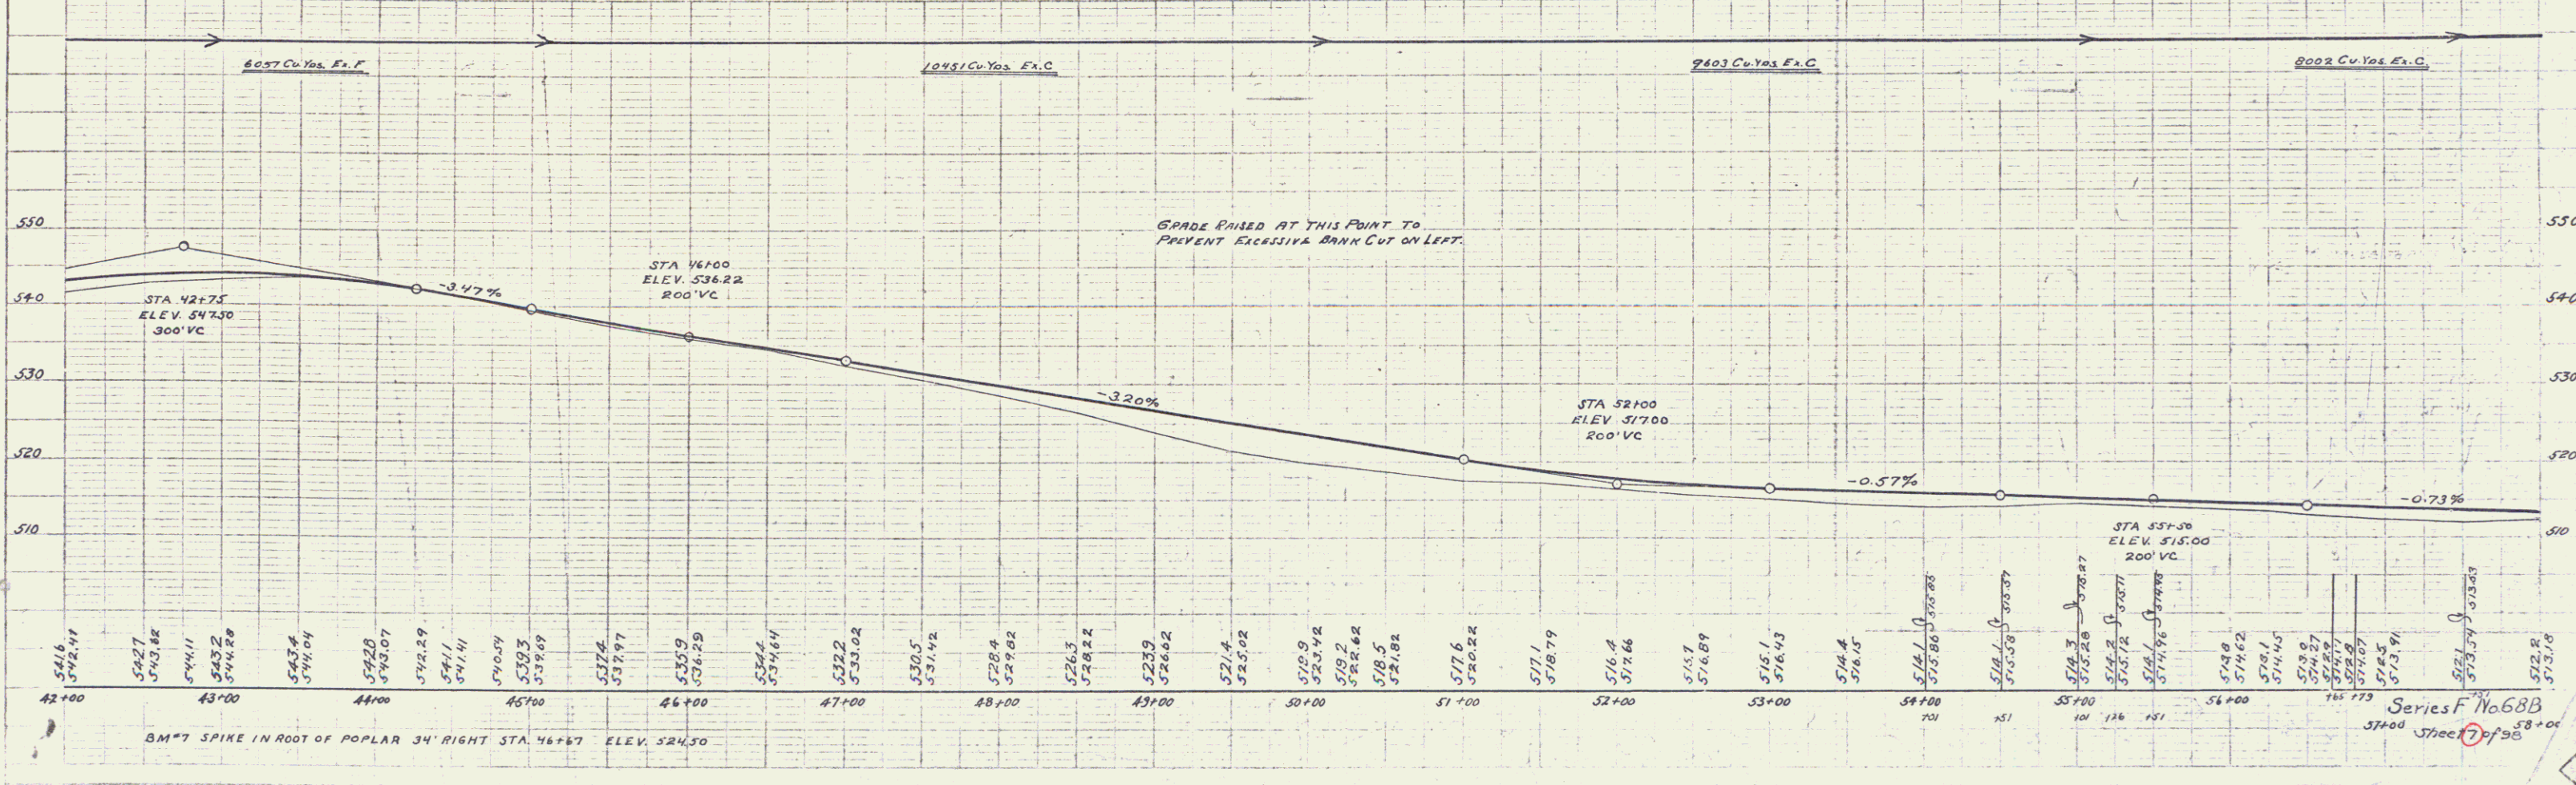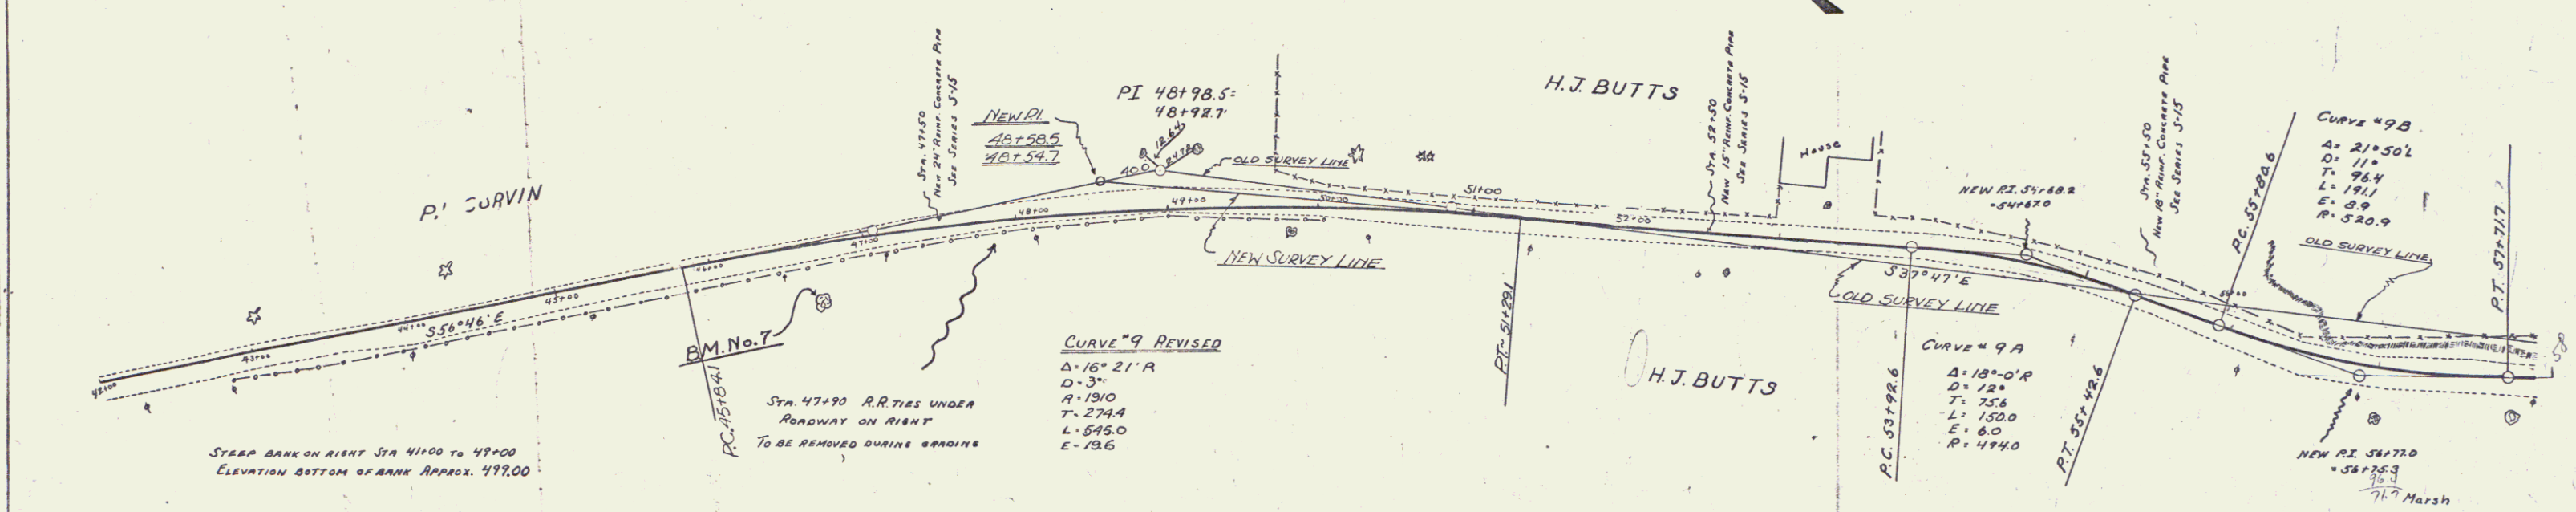

Series F No. 68B  
STA 42+00 STree 7-f-98