

FED. ROAD DIST. NO.	STATE	FED. AID PROJ. NO.	FISCAL YEAR	SHEET NO.	TOTAL SHEETS
9	VT	680	1927	68	98

WOOD GUARD RAIL REQUIRED RIGHT
 STA 62+00 TO 63+12 LENGTH 24 FT.
 LEFT
 STA 59+39 TO 59+63 LENGTH 24 FT.
 TOTAL THIS SHEET 48 FT.


CABLE GUARD RAIL REQUIRED RIGHT
 STA 58+00 TO 60+30 LENGTH 230 FT.
 LEFT
 STA 61+04 TO 63+12 LENGTH 208 FT.
 TOTAL THIS SHEET 438 FT.

NEW CULVERTS REQUIRED
 STA 59+51 15" REIN. CONC. PIPE LENGTH 38 FT.
 CONCRETE CLASS B (1-2 1/2-5) 2,7 C.Y.
 REINFORCING STEEL 33 LB.
 STA 61+13 2 1/2" REIN. CONC. BOX
 CONCRETE CLASS A (1-2-4) 15.2 C.Y.
 REINFORCING STEEL 104 LB.
 STA 63+00 18" REIN. CONC. PIPE LENGTH 32 FT.
 CONCRETE CLASS A (1-2-4) 4.9 C.Y.
 REINFORCING STEEL 60 LB.

NEW CULVERTS REQUIRED FOR DRIVE
 LEFT STA 60+25 12" CORR GALV. METAL PIPE LENGTH 32 FT.
 CONCRETE CLASS B (1-2 1/2-5) 1.5 C.Y.
 REINFORCING STEEL 33 LB.

PLAN
 A.A. DOE
 A.A. DOE

PROFILE
 H. McGibbon
 W.D. McAlister

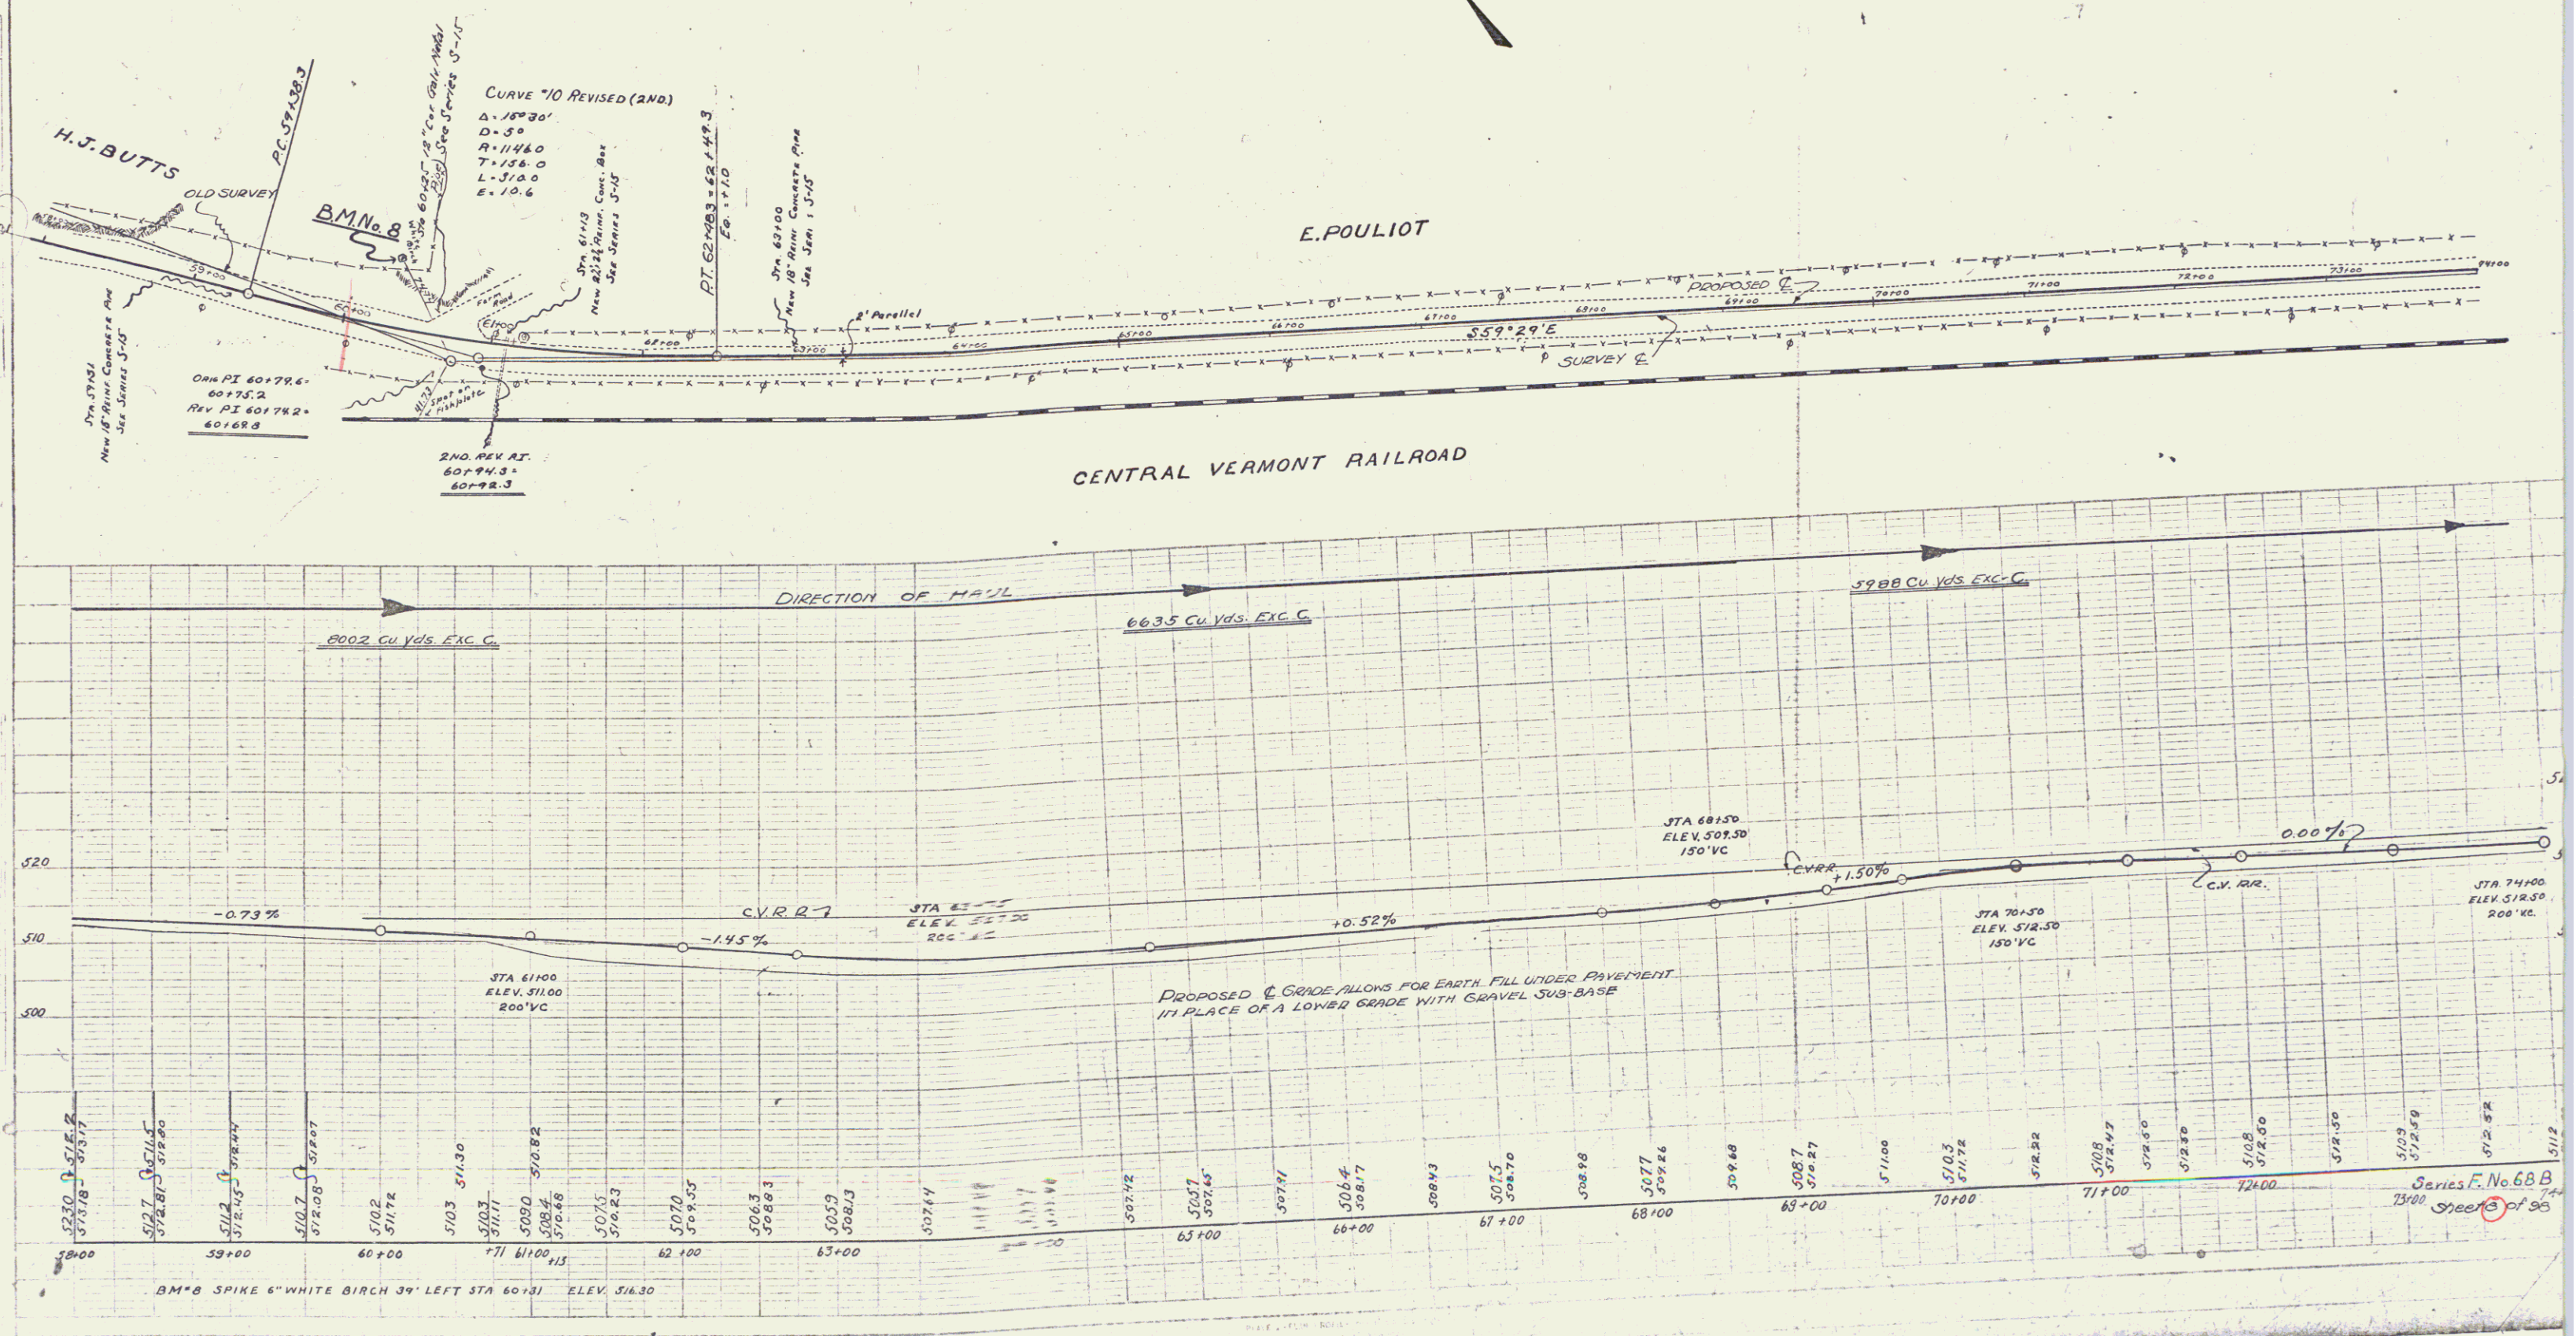

Series F. No. 68B
 13400 Sheets of 98