

WOOD GUARD RAIL REQUIRED
RIGHT
LEFT
STA. 81491 TO 81465 LENGTH 24 FT.
TOTAL THIS SHEET 24 FT.

CABLE GUARD RAIL REQUIRED
RIGHT
LEFT
STA. 85125 TO 87125 LENGTH 200 FT.
STA. 81100 TO 82160 " 160 "
LEFT
STA. 85180 TO 87100 LENGTH 120 FT.
TOTAL THIS SHEET 480 FT.


NEW CULVERTS REQUIRED
STA. 81153 2'x2' REINF. CONCRETE BOX
CONCRETE CLASS A(1-2-4)
REINFORCING STEEL 13.4 C.Y.
879 LB.

SUBBASE OF GRAVEL REQUIRED
STA. 83115 TO 85125 LENGTH 210 FT. 6" THICKNESS THRU ROCK CUT

FED. ROAD DIST. NO.	STATE	FED. AID PROJ. NO.	FISCAL YEAR	SHEET NO.	TOTAL SHEETS
4	VT	608	1927	9	98

PLAN
DATE: 7/25/27
BY: A.A. BOB
CHECKED: W.B. GARDNER
SCALE: AS SHOWN

PROFILE
DATE: 7-25-27
BY: A.A. BOB
CHECKED: W.B. GARDNER
SCALE: AS SHOWN

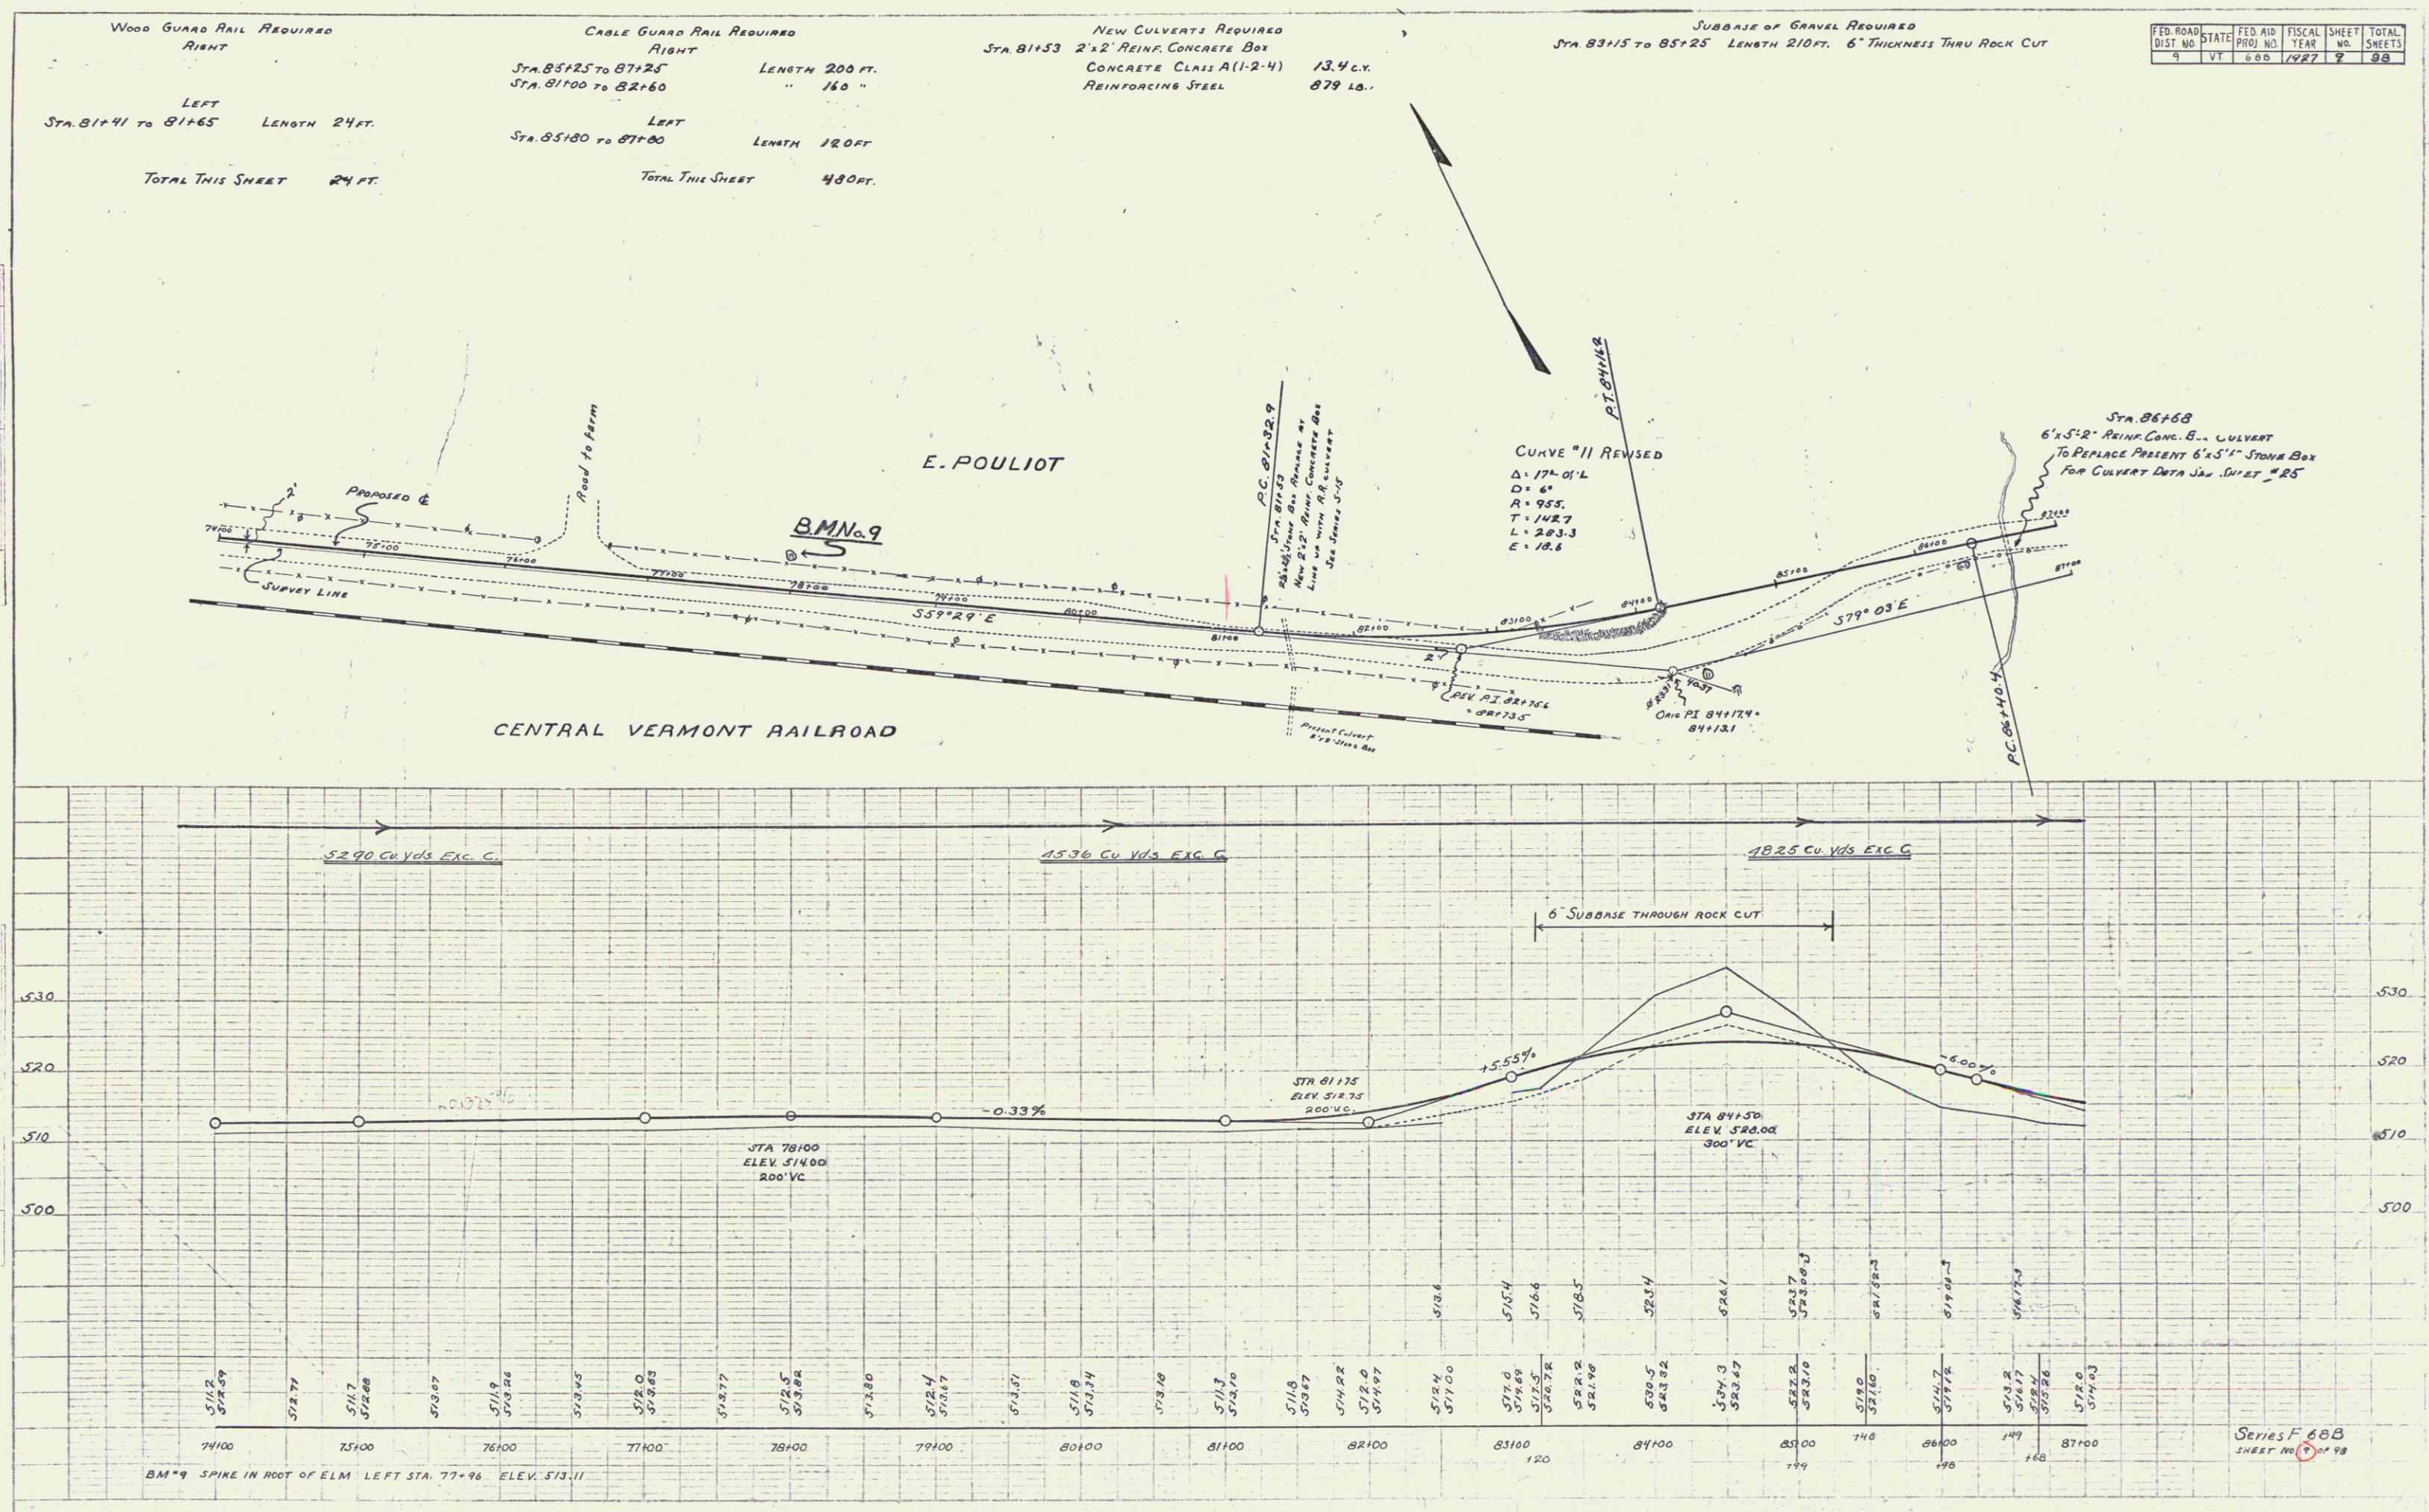

SERIES F 608
SHEET NO. 9 OF 98