

FED. ROAD DIST. NO.	STATE	FED. AID PROJ. NO.	FISCAL YEAR	SHEET NO.	TOTAL SHEETS
9	VI.	6578	1967	77	98

CABLE GUARD RAIL REQUIRED

RIGHT

STA. 104+30 TO 105+90 LENGTH 160 FT.

105+50 TO 113+26 " 536 "

115+90 TO 117+74 " 184 "

LEFT

STA. 110+00 TO 117+76 LENGTH 776 FT.

TOTAL THIS SHEET 1656 FT

NEW CULVERTS REQUIRED


STA. 113+75 41/4" REINFORCED CONCRETE BOX

CONCRETE CLASS A(1-2-4) 21.8 Cu. Yds.


REINFORCING STEEL 1409 Lbs.

SUBBASE OF GRAVEL REQUIRED

STA. 103+08 TO 119+00 6" SUBBASE OF GRAVEL

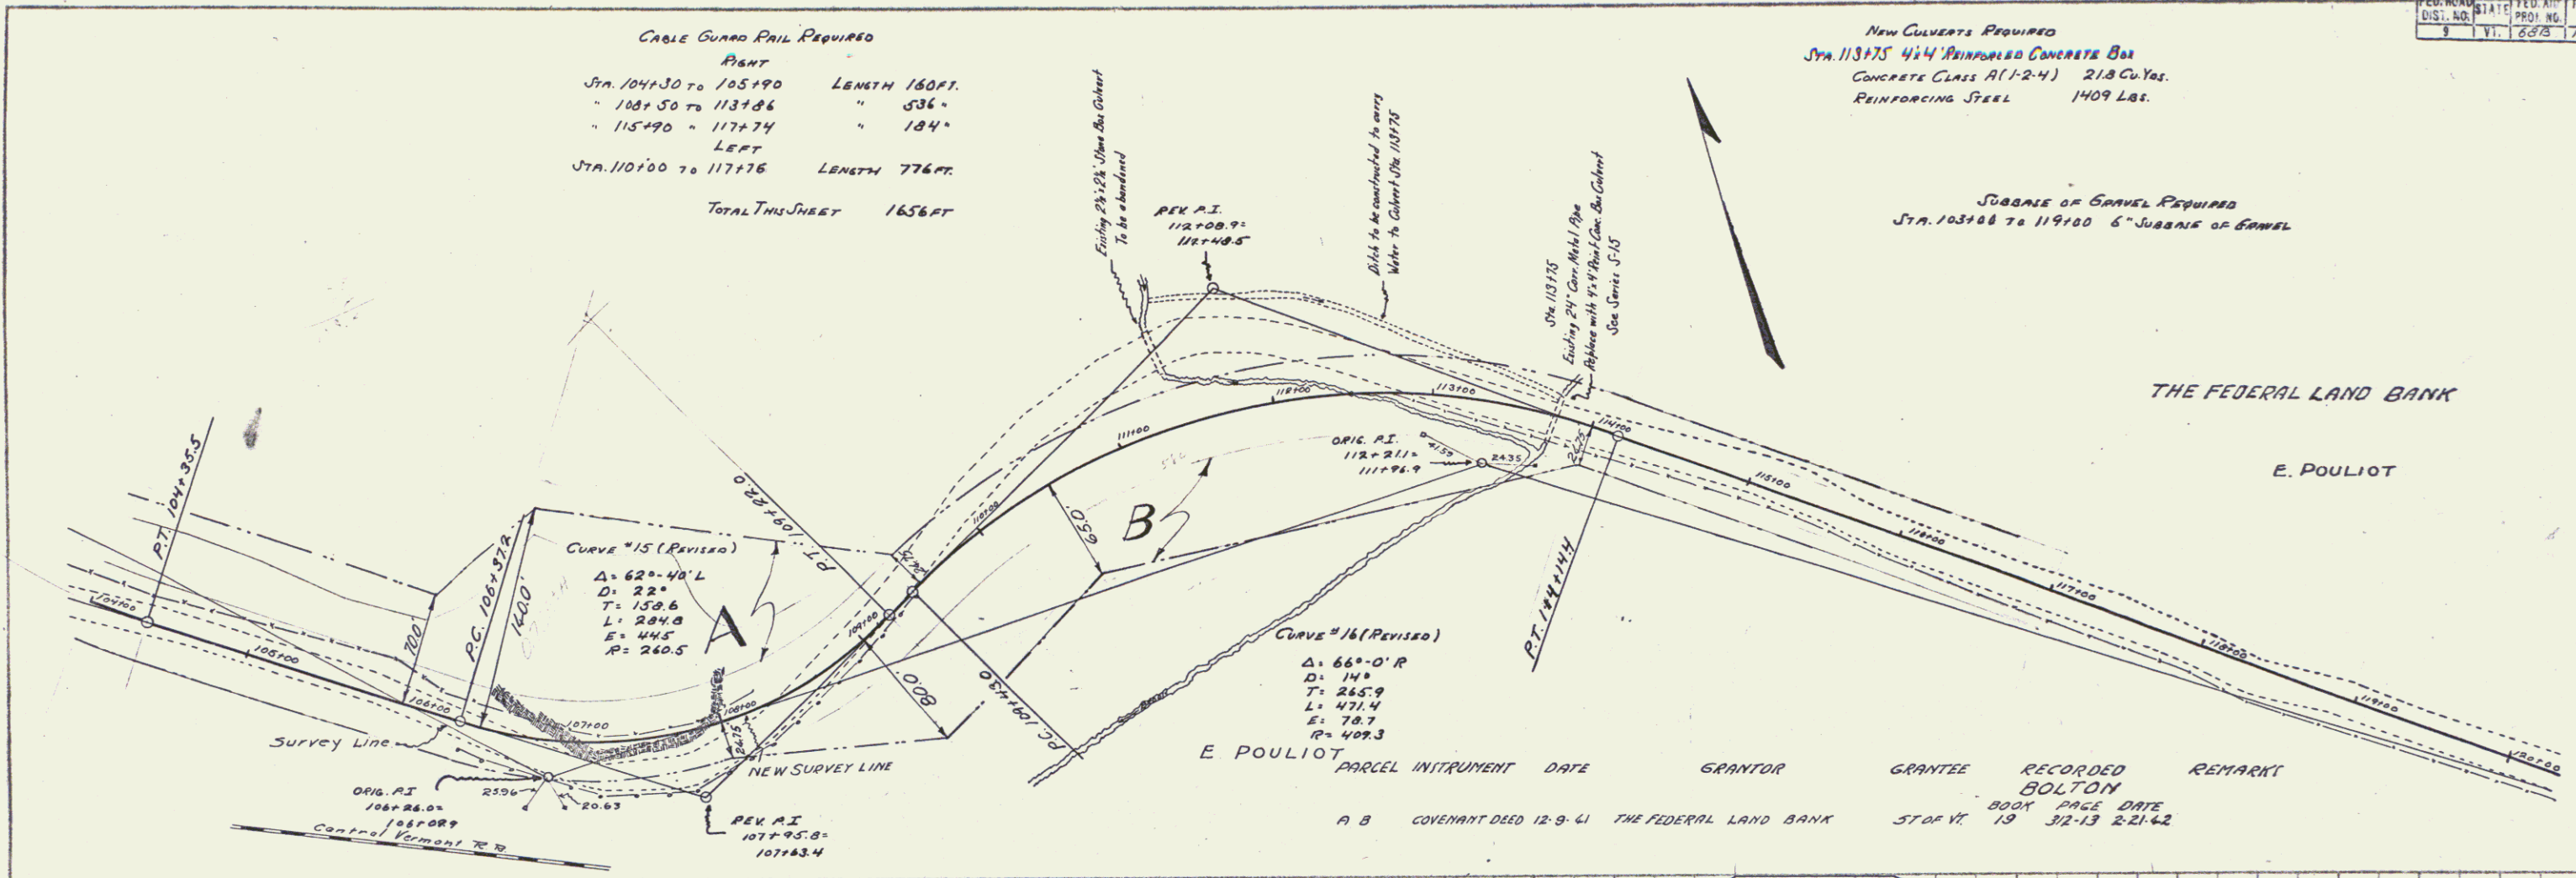

PARCEL	INSTRUMENT	DATE	GRANTOR	GRANTEE	RECORDED	REMARK
A B	COVENANT DEED	12-9-41	THE FEDERAL LAND BANK	BOLTON	BOOK PAGE DATE	STA. 19 32-13 2-21-62

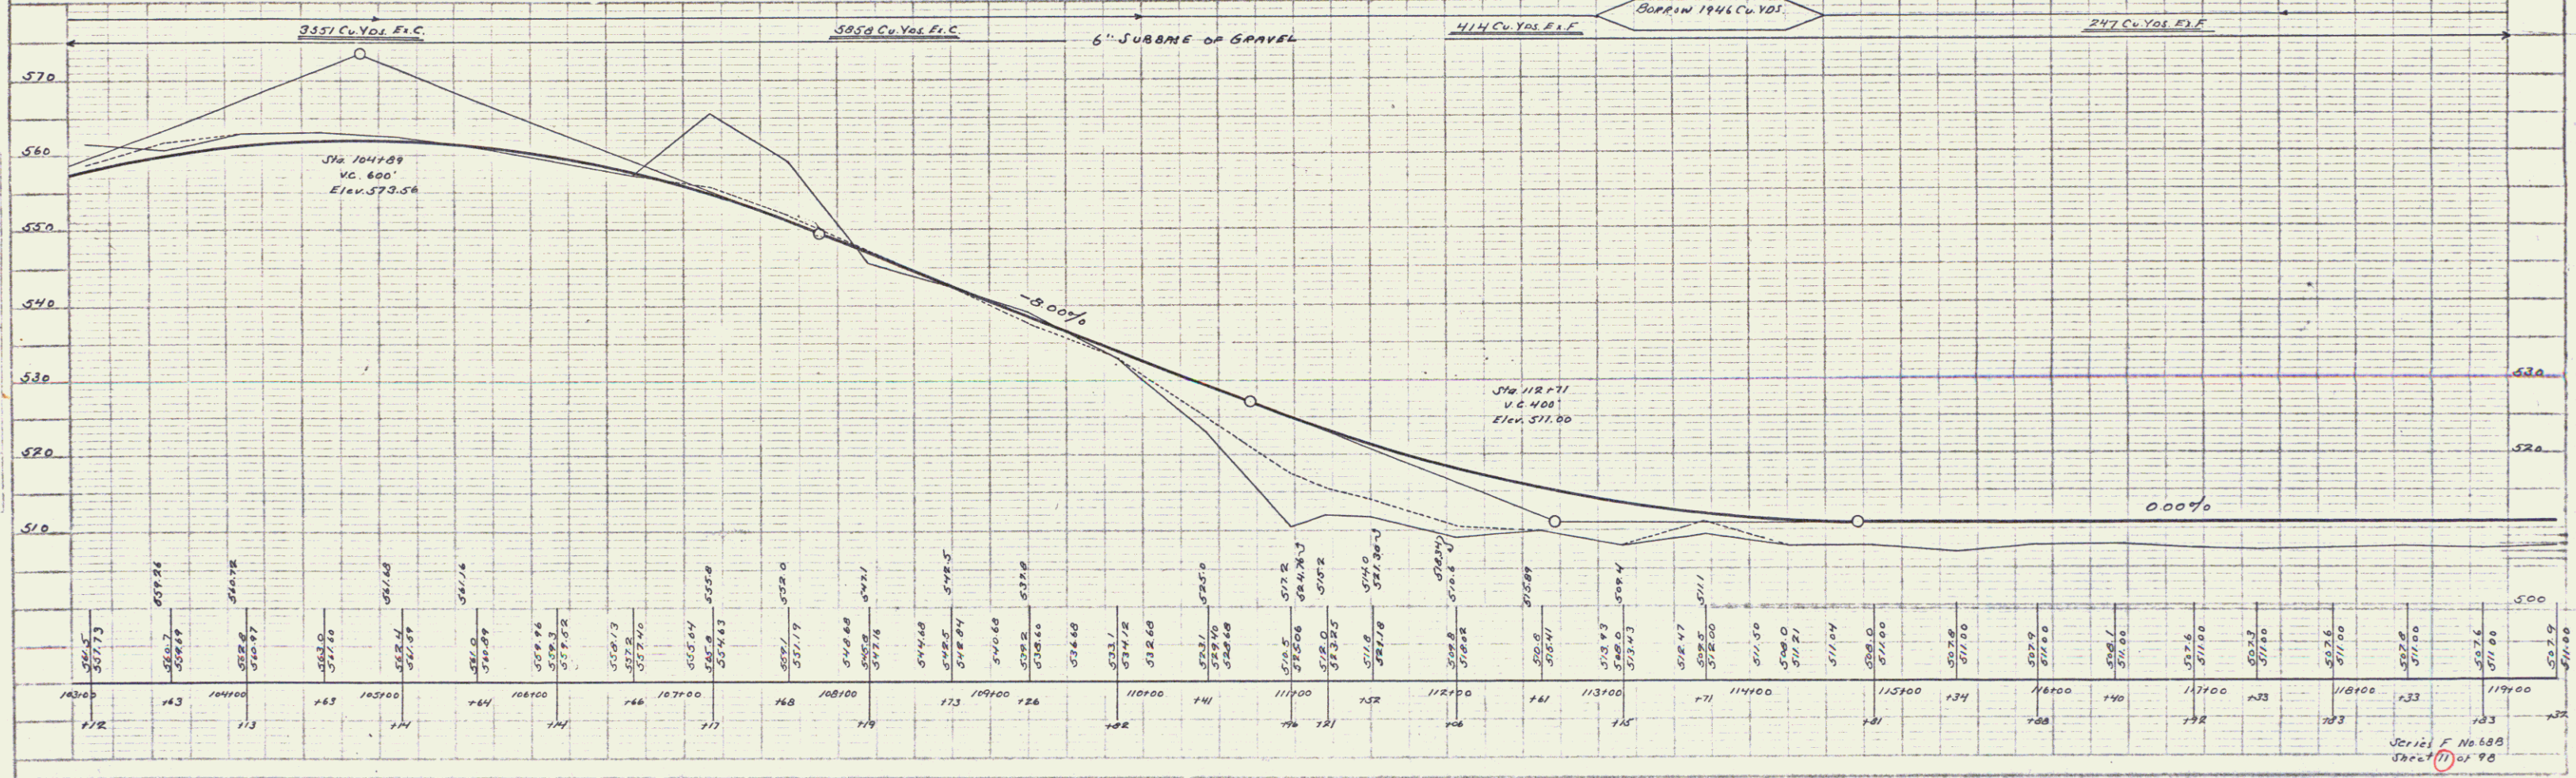

PLAN
SCALE 1" = 40'

PROFILE
SCALE 1" = 10'