


FED. ROAD DIST. NO. STATE FEL. PRO. 9 VT. 6

PLAN
 DATE 9/24 9/25
 A.A. DOUGLAS
 W.B. MILLER
 W.B. M.

PROFILE
 DATE 9-26 9-28
 A.A. DOUGLAS
 W.B. MILLER
 W.B. M.

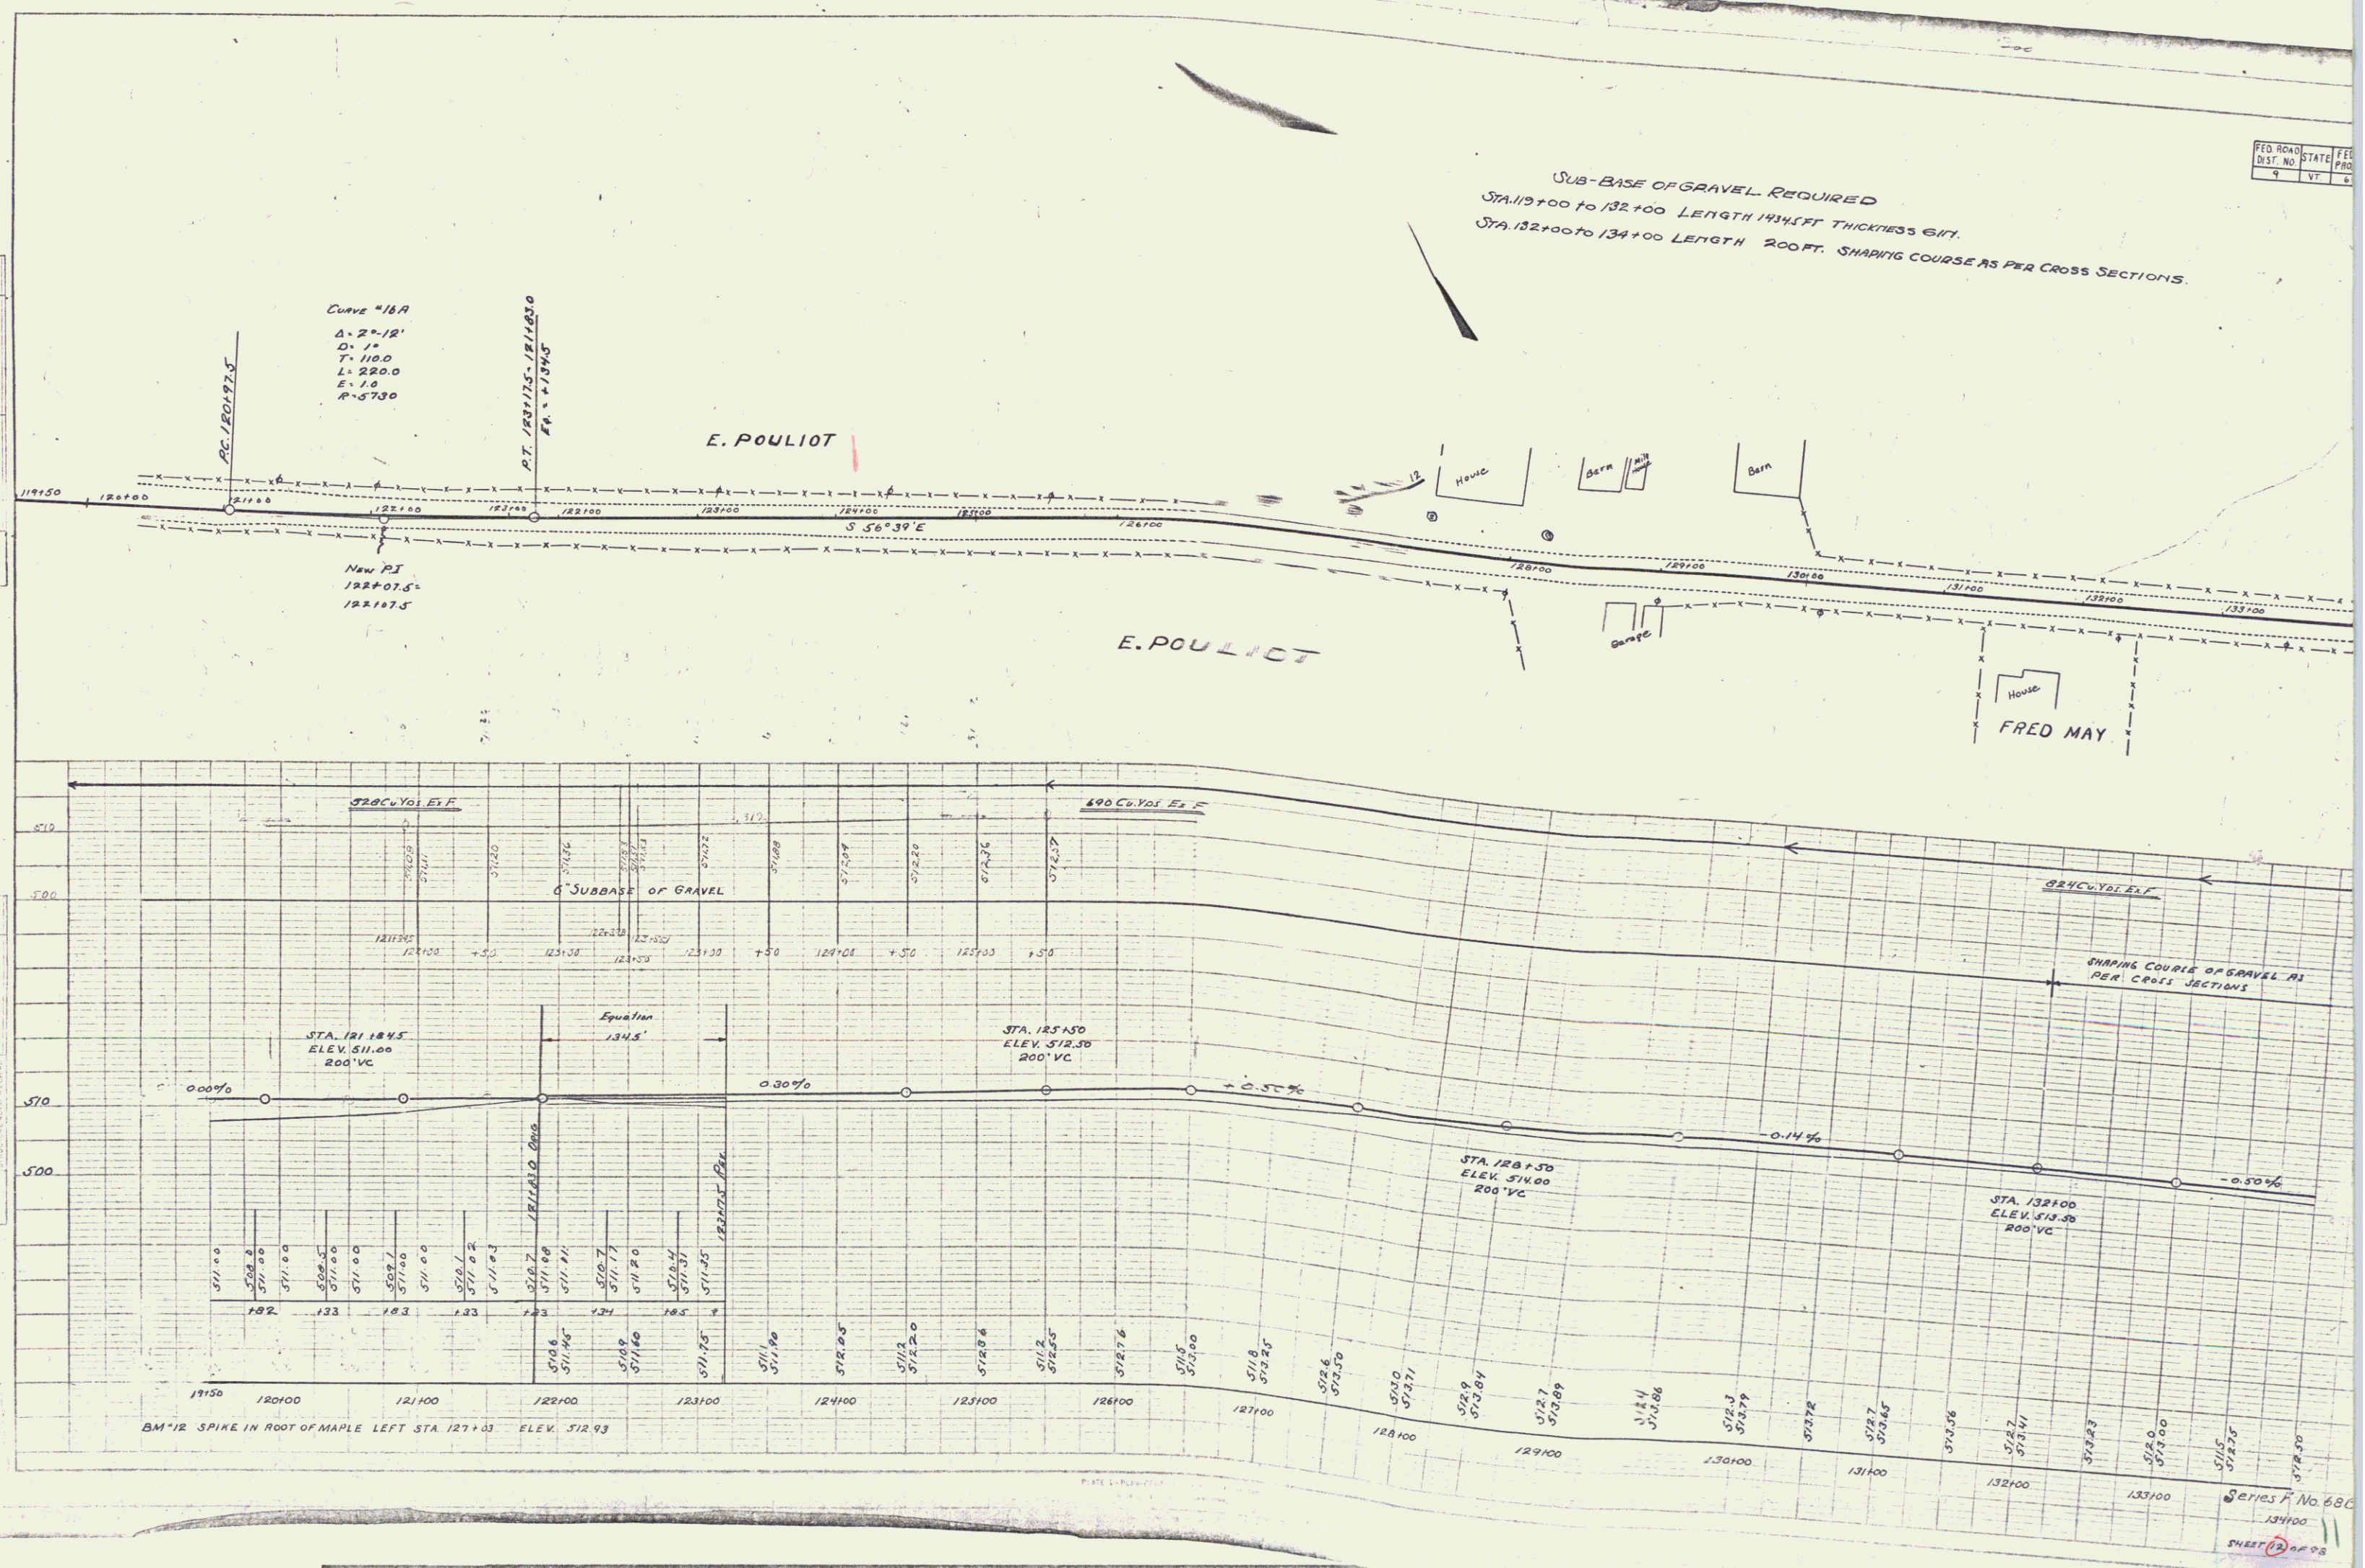

SERIES No 680
 SHEET 12 OF 28