



PLAN
 PROJECT: BOLTON REGION
 DATE: 8-15-50
 DRAWN BY: [unclear]
 CHECKED BY: [unclear]
 SCALE: AS SHOWN
 SHEET NO.: 13

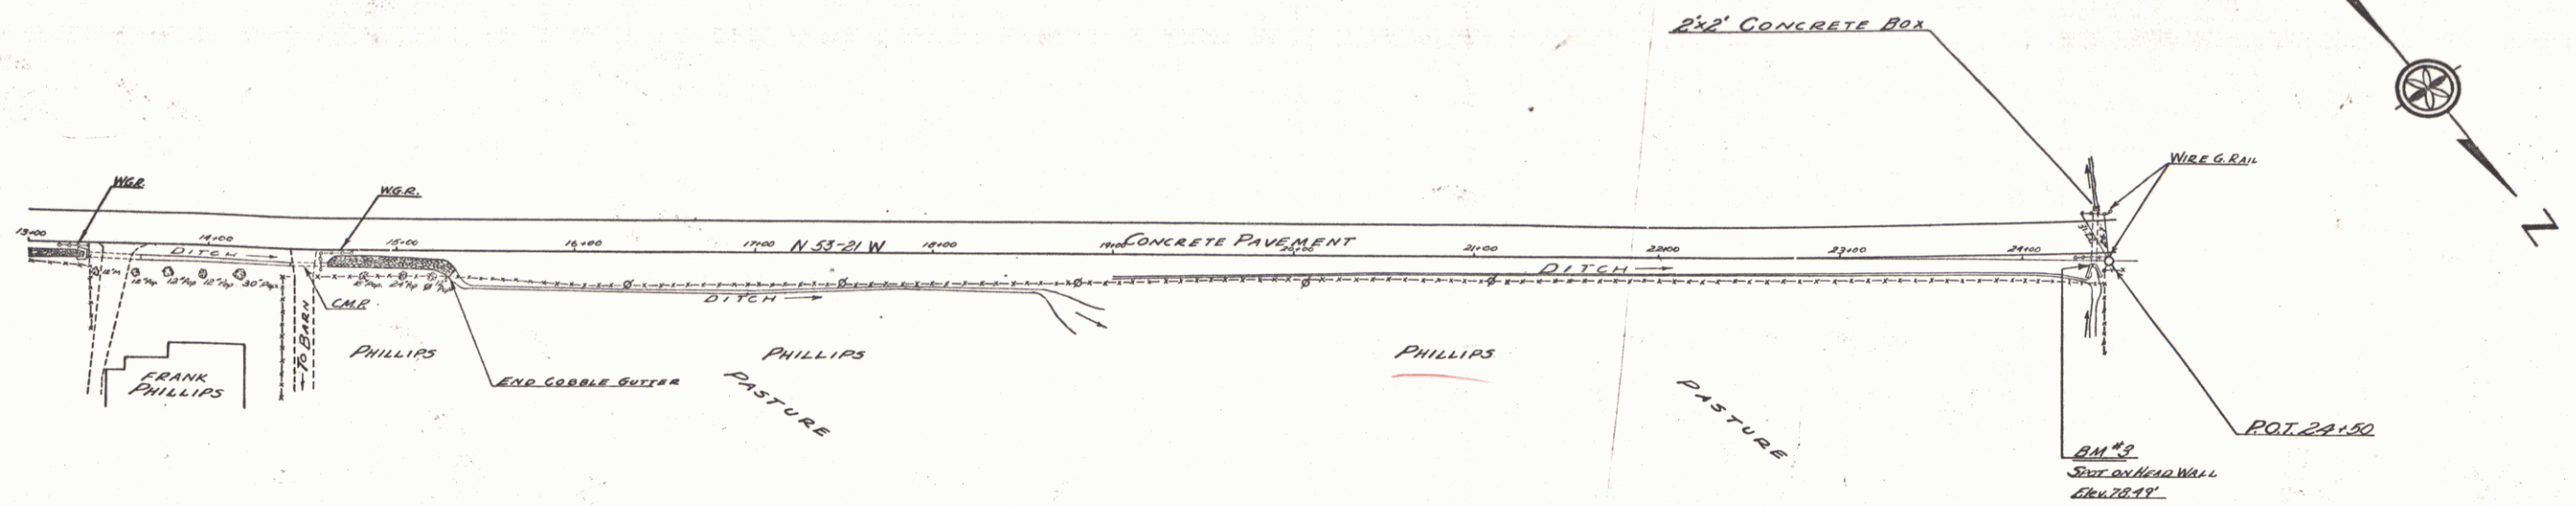

PROFILE
 PROJECT: BOLTON REGION
 DATE: 8-15-50
 DRAWN BY: [unclear]
 CHECKED BY: [unclear]
 SCALE: AS SHOWN
 SHEET NO.: 13

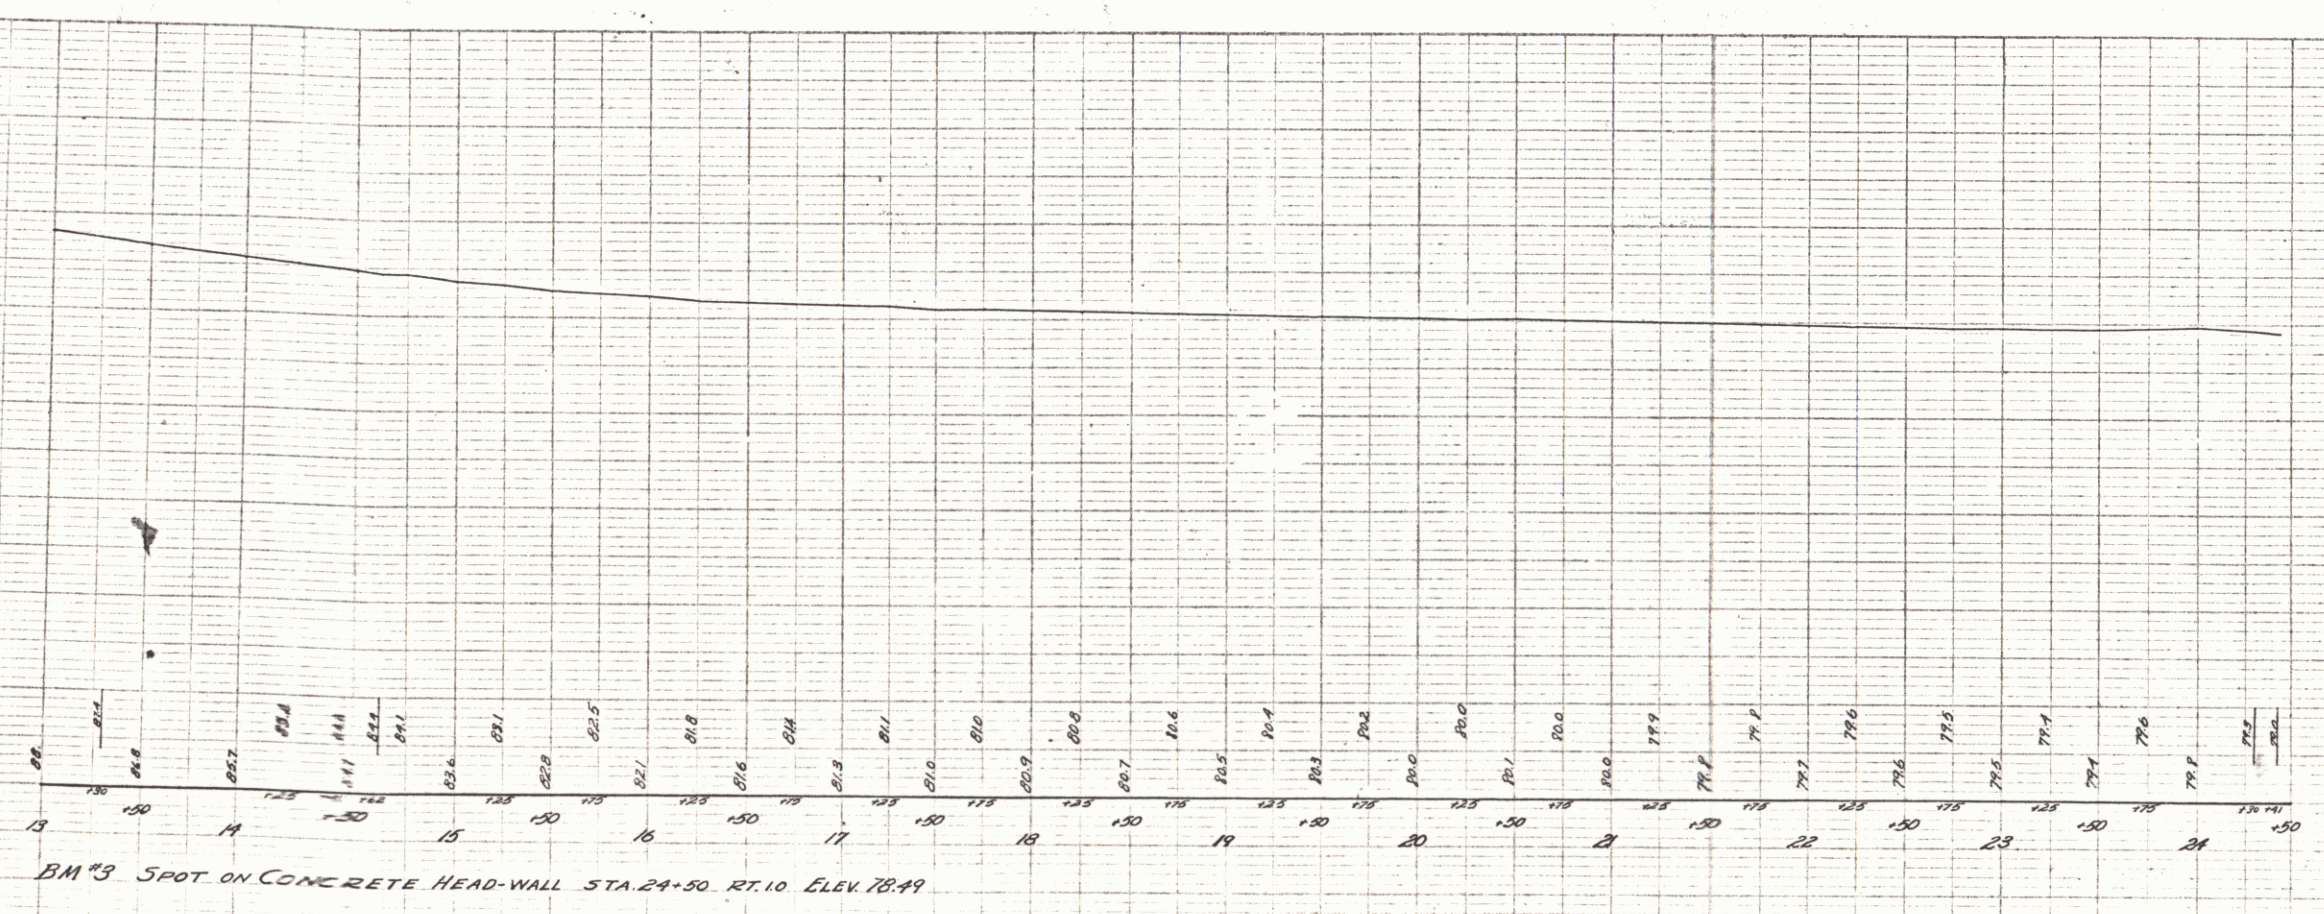

BOLTON - PHILLIPS FARM
 13A