



PLAN
 DATE: 10/9/35
 BY: PUTNAM POLSON
 CHECKED: [Signature]
 SCALE: AS SHOWN

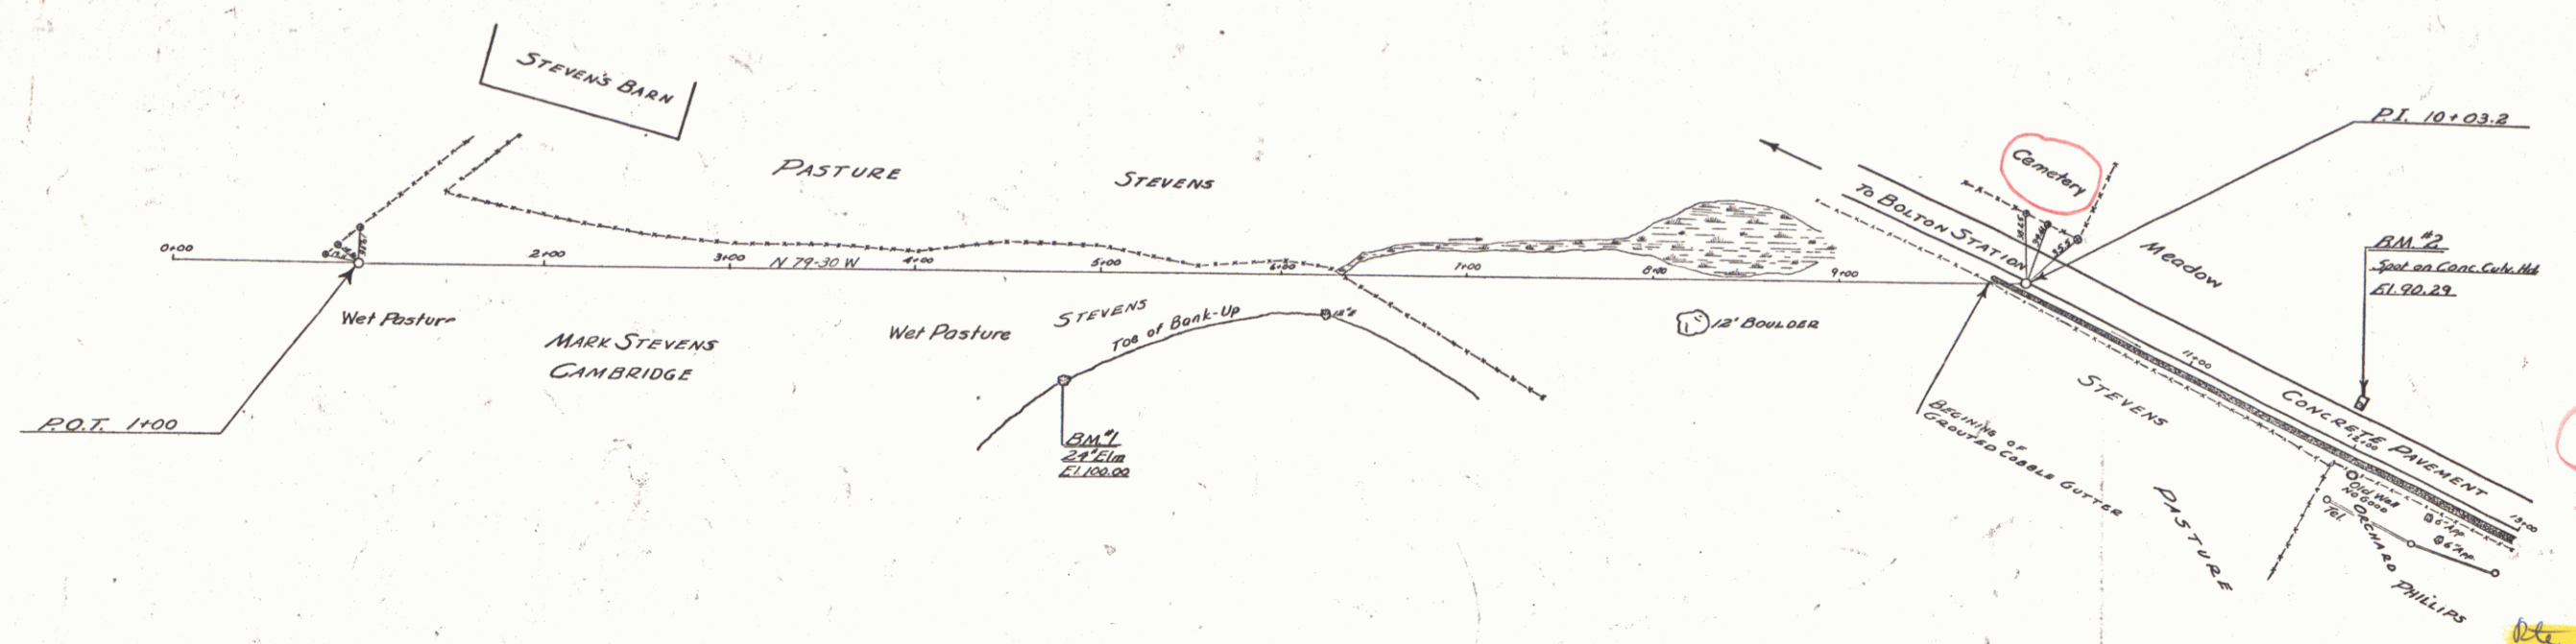

Project No.
 MP 2.6 ±
 RIGHT-OF-WAY DIVISION
 TOWN FILE
 PERPETUAL
 Town of US 2
 (To Be Returned To R.O.W. Division)

PROFILE
 DATE: 10/9/35
 BY: PUTNAM POLSON
 CHECKED: [Signature]
 SCALE: AS SHOWN

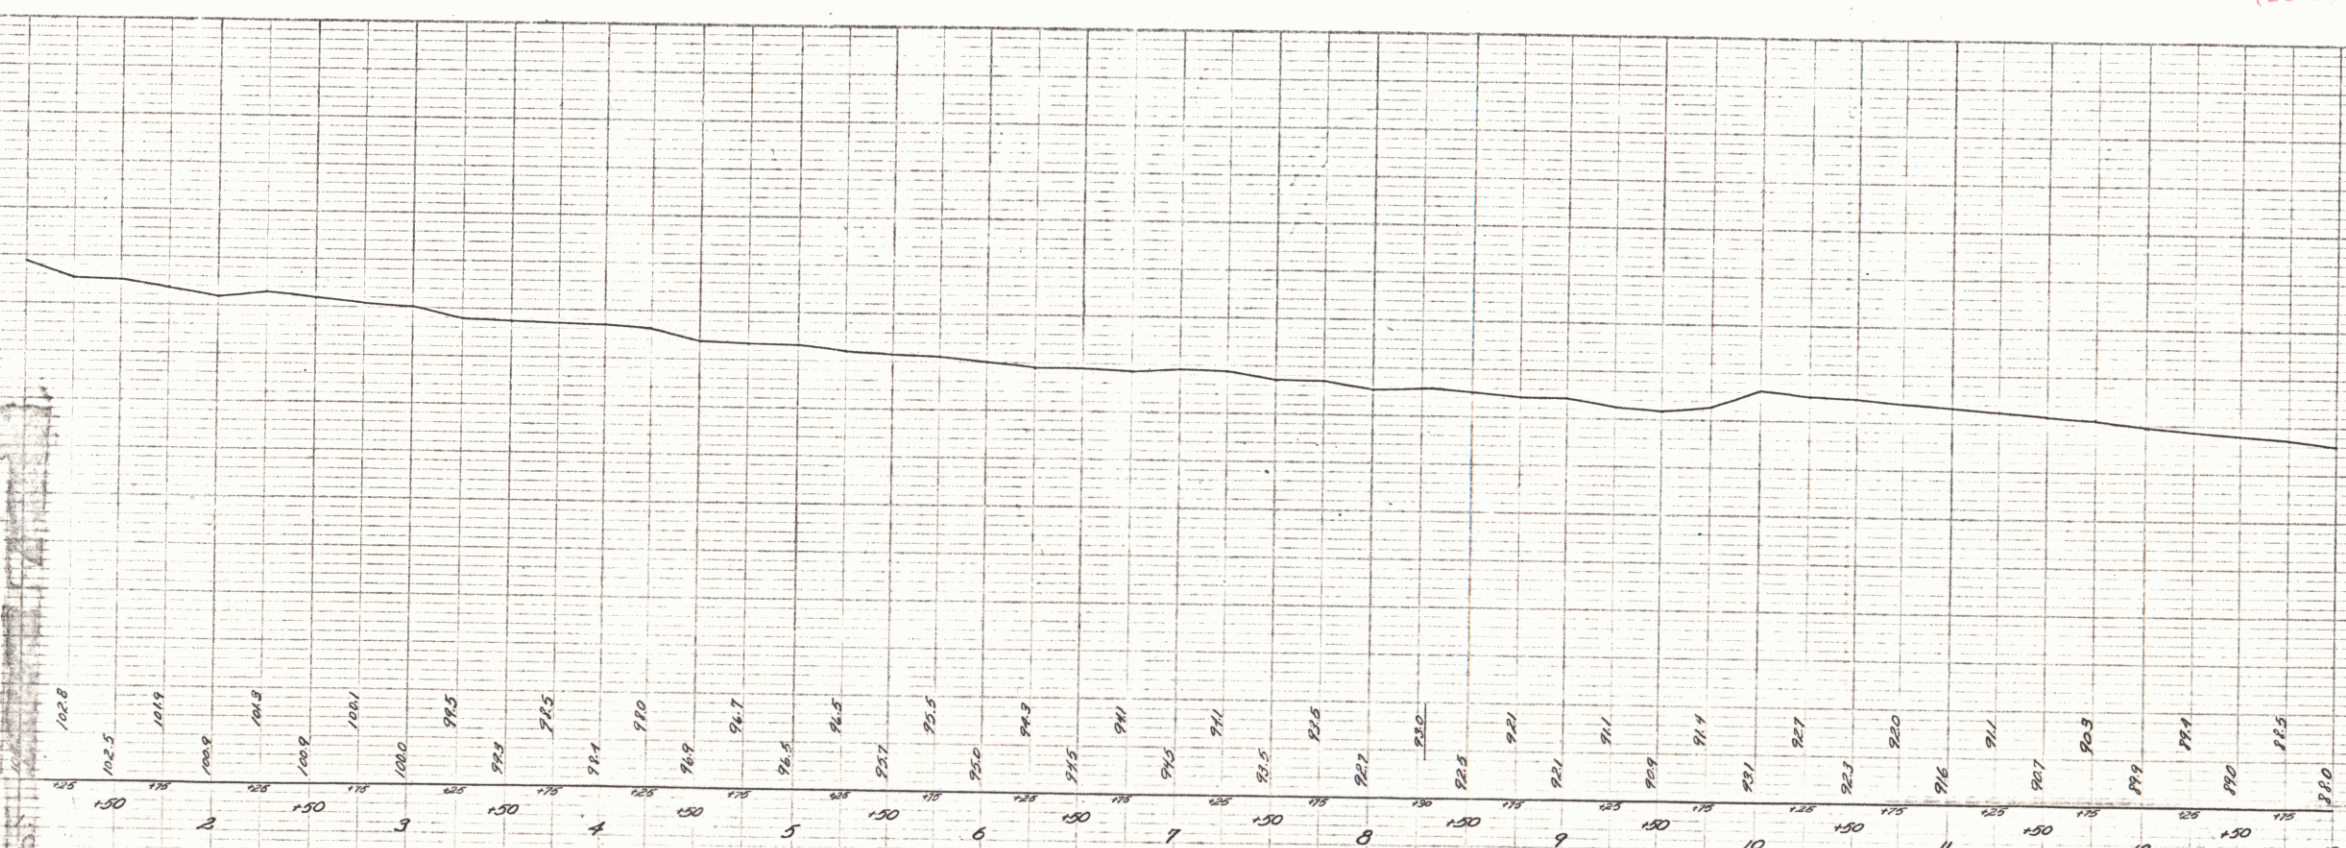

1935 Bolton
 2"x2' Conc. Box
 and Conc. Pavement

#1 SPIKE IN ROOT 24" ELM STA 4+80 RT 60' ELEV. 100.00
 #2 SPOT ON CONCRETE CULV. HEAD STA. 11+92 LT. 23.0 ELEV. 90.29

10/9/35
 Town of: BOLTON-PHILLIPS FARM
 DIST # 5 PLANS 133