

INDEX OF SHEETS		
SHEET NO.	TITLE PAGE	
2	TYPICAL CROSS-SECTION OF IMPROVEMENTS	
3	PLAN AND PROFILE STA. 0+00 - 12+00	
4	" " " 12+00 - 26+00	
5	" " " 26+00 - 40+00	
6	" " " 40+00 - 56+00	
7	" " " 56+00 - 68+00	
8	" " " 68+00 - 84+00	
9	" " " 84+00 - 91+00	
10	C ULVERT	
11	26 CROSS SECTIONS	

FEDERAL AID PROJECT NO.	STATE PROJECT NO.
9	Vt. 68A 1923

STATE OF VERMONT
STATE HIGHWAY DEPARTMENT


PLAN AND PROFILE OF PROPOSED
STATE HIGHWAY

FEDERAL AID PROJECT


Plan # 99R081

TOWNS OF BOLTON-WATERBURY

BOLTON FALLS ROAD
FROM 250 FT. EASTERLY W. MARTIN FARM
TO M. MOODY FARM

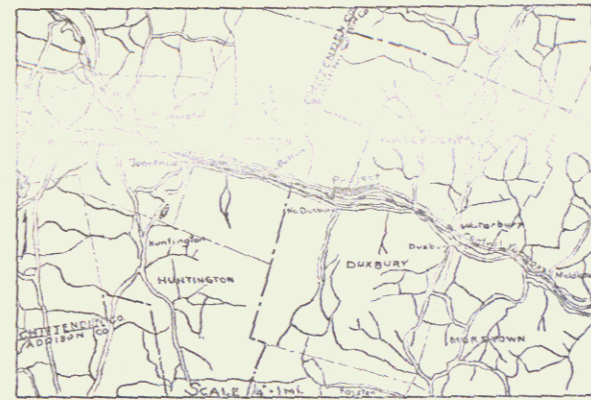


SCALES { PLAN 1 IN = 50 FT
PROFILE HORIZ. 1 IN = 50 FT VERT. 1 IN = 10 FT
CROSS SECTION 1 IN = 5 FT

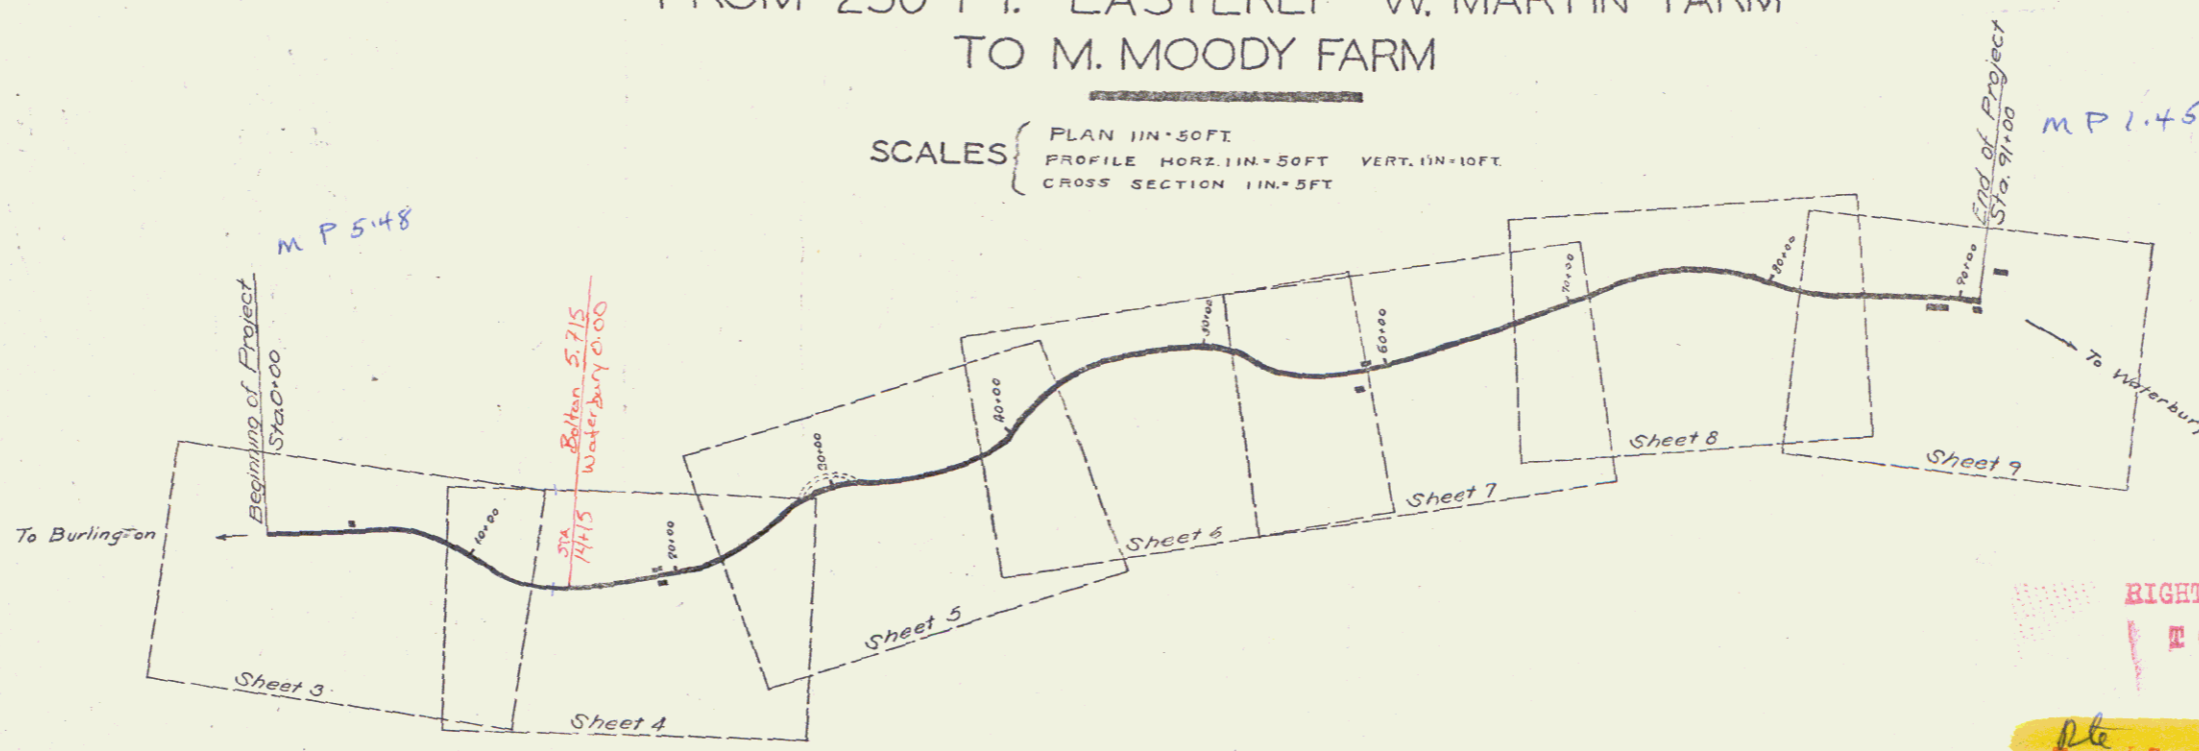

LAYOUT 1 IN. = 500 FT.

RIGHT-OF-WAY DIVISION
TOWN FILE
PERPETUAL
Town of US2
(To Be Returned To R.O.W. DIVISION)

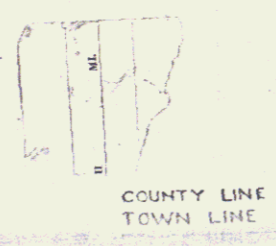

CONVENTIONAL SIGNS

100	Town of Bolton	Plan 68-A
101	Town of Bolton	1923 - Plan
102	Waterbury	1925 - Log
103	Bolton Falls Rd from 250 ft.	
104	Station W. Martin Farm to M. Moody Farm	

DEFLECTION ANGLE	Δ
DEGREE OF CURVE	D.
RADIUS OF CURVE	R.
TANGENT DISTANCE	T.
LENGTH OF CURVE	L.
EXTERNAL DISTANCE	E.
POINT OF INTERSECTION	P.I.
POINT OF CURVE	P.C.
POINT OF TANGENT	P.T.

1/23/24

Project NO. F 68A

DIST. # 5 PLANS

SERIES F HOGSFILE
SHEET 1 OF 20