


GUARD RAIL REQUIRED
 On Left Sta 44.49 to Sta 44.73 Length 24ft
 On Right Sta 40.00 to Sta 42.22 Length 22ft
 " 43.88 " " 44.36 " " 28"
 " 46.48 " " 56.00 " " 222"
 Total this sheet 1286"

NEW CULVERTS REQUIRED
 Sta 44.60 2.2 E21 Concrete 5.8 Cuyds.
 " 44.60 " " 6.9 " " 6.9 " "
 " 44.60 " " 148 " " 148 " "
 Rein Steel 148"

SUB-BASE REQUIRED
 Sta 40.00 to Sta 40.75 Length 75ft
 " 51.00 " " 56.00 " " 300"
 Total this sheet 515"

REG. NO. STATE (F.D. & J.) FISCAL SHEET NO.
 1684 1929 6 2

1/10/20
 1/10/20

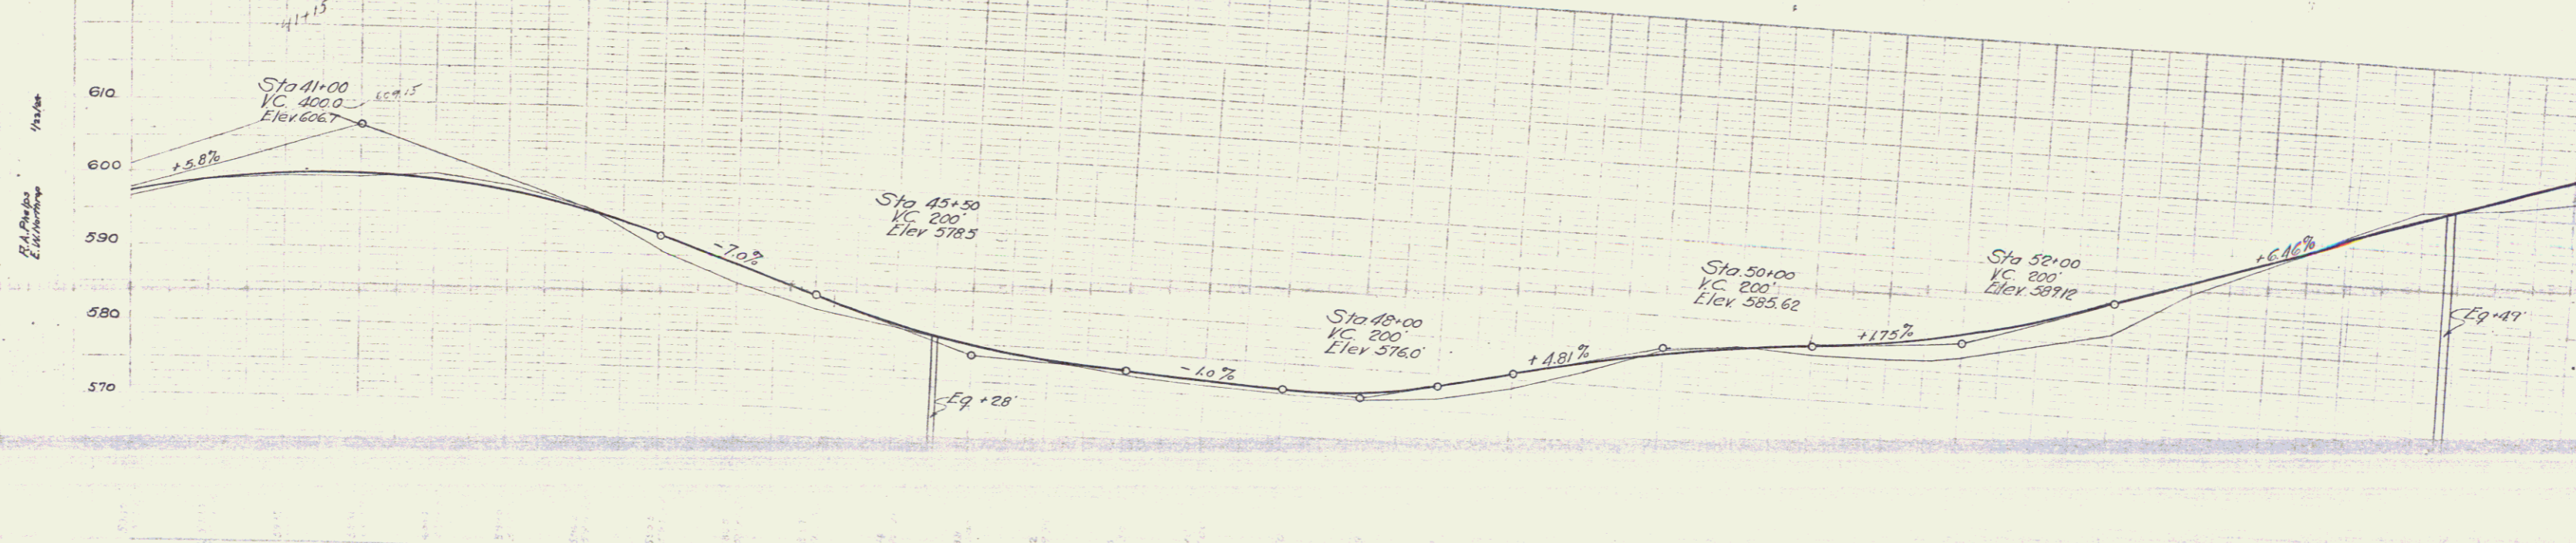

B.M. 10 Boulder Left Sta 44+04 Elev 591.51
 " " " " 51+07 " 590.65

40	41	42	43	44	45	46	47	48	49	50	51	52	53	54	55	56	57	58
591.51	590.65	589.15	587.15	585.15	583.15	581.15	579.15	577.15	575.15	573.15	571.15	569.15	567.15	565.15	563.15	561.15	559.15	557.15