
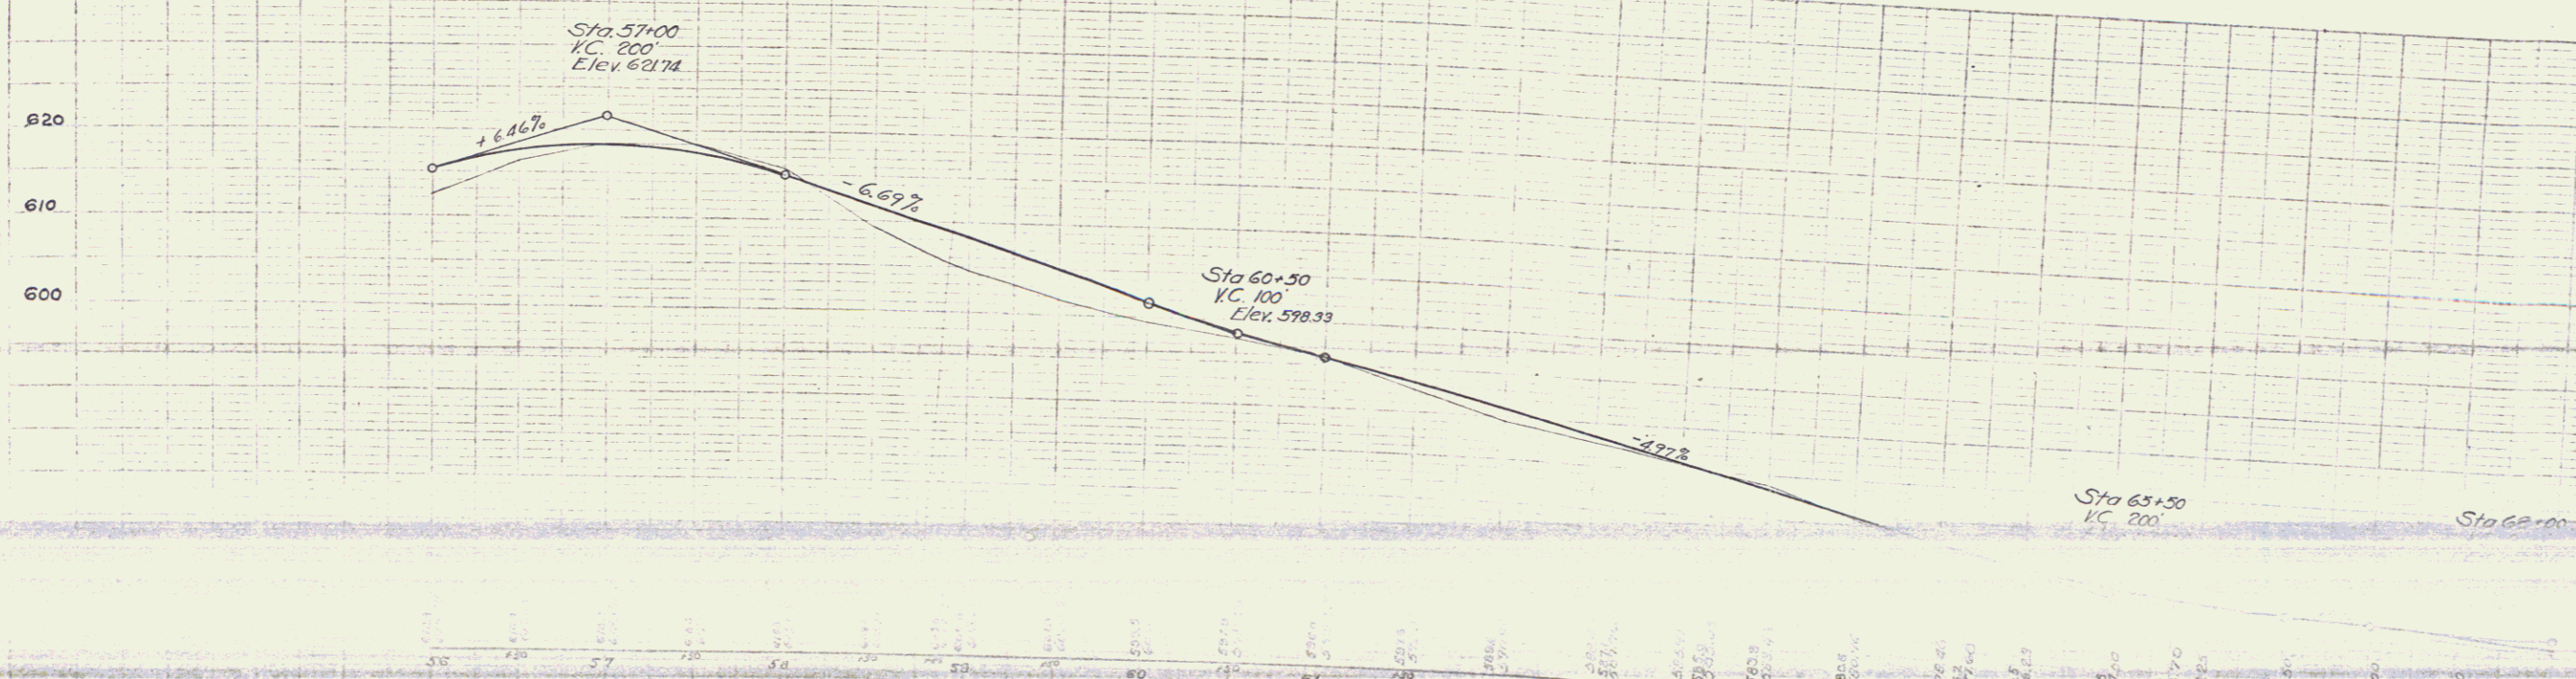


GUARD RAIL REQUIRED  
 ON LEFT  
 Sta 59+38 to Sta 59+62 Length 24 ft  
 ON RIGHT  
 Sta 56+00 to Sta 56+64 Length 64 ft  
 " 59+38 " 59+62 " 24 "  
 Total this sheet 112 ft

NEW CULVERTS REQUIRED  
 Sta 59+50 3x2 Rein. Concrete  
 1-2'4" " 42 Cuyds  
 1-2'4" " 77 " "  
 Rein Steel 216"

PER. NO.	DATE	PROJ. NO.	FISCAL YEAR	SHEET NO.	TOTAL SHEETS
68A	1923	7	26		

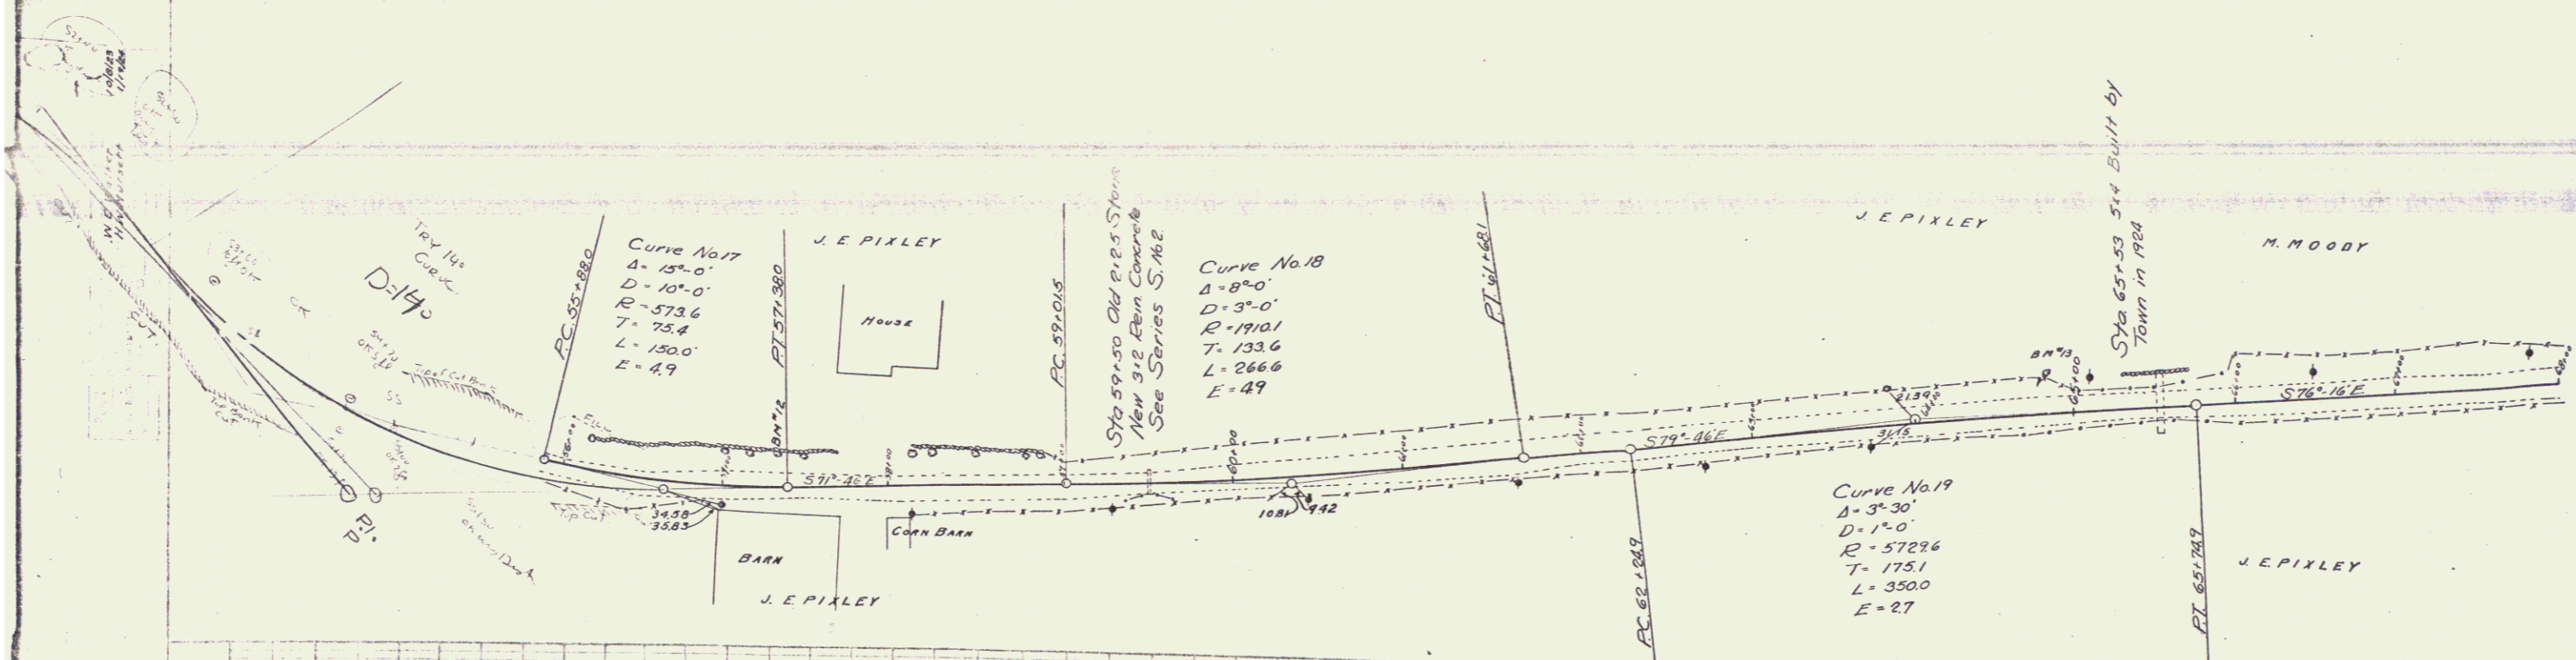

B.M. 12 Spike in 16" Elm Left Sta 57+32 Elev 620.21  
 " 13 " " 14 " " 65+84 " 576.74

Series F  
 Sheet 6

6