
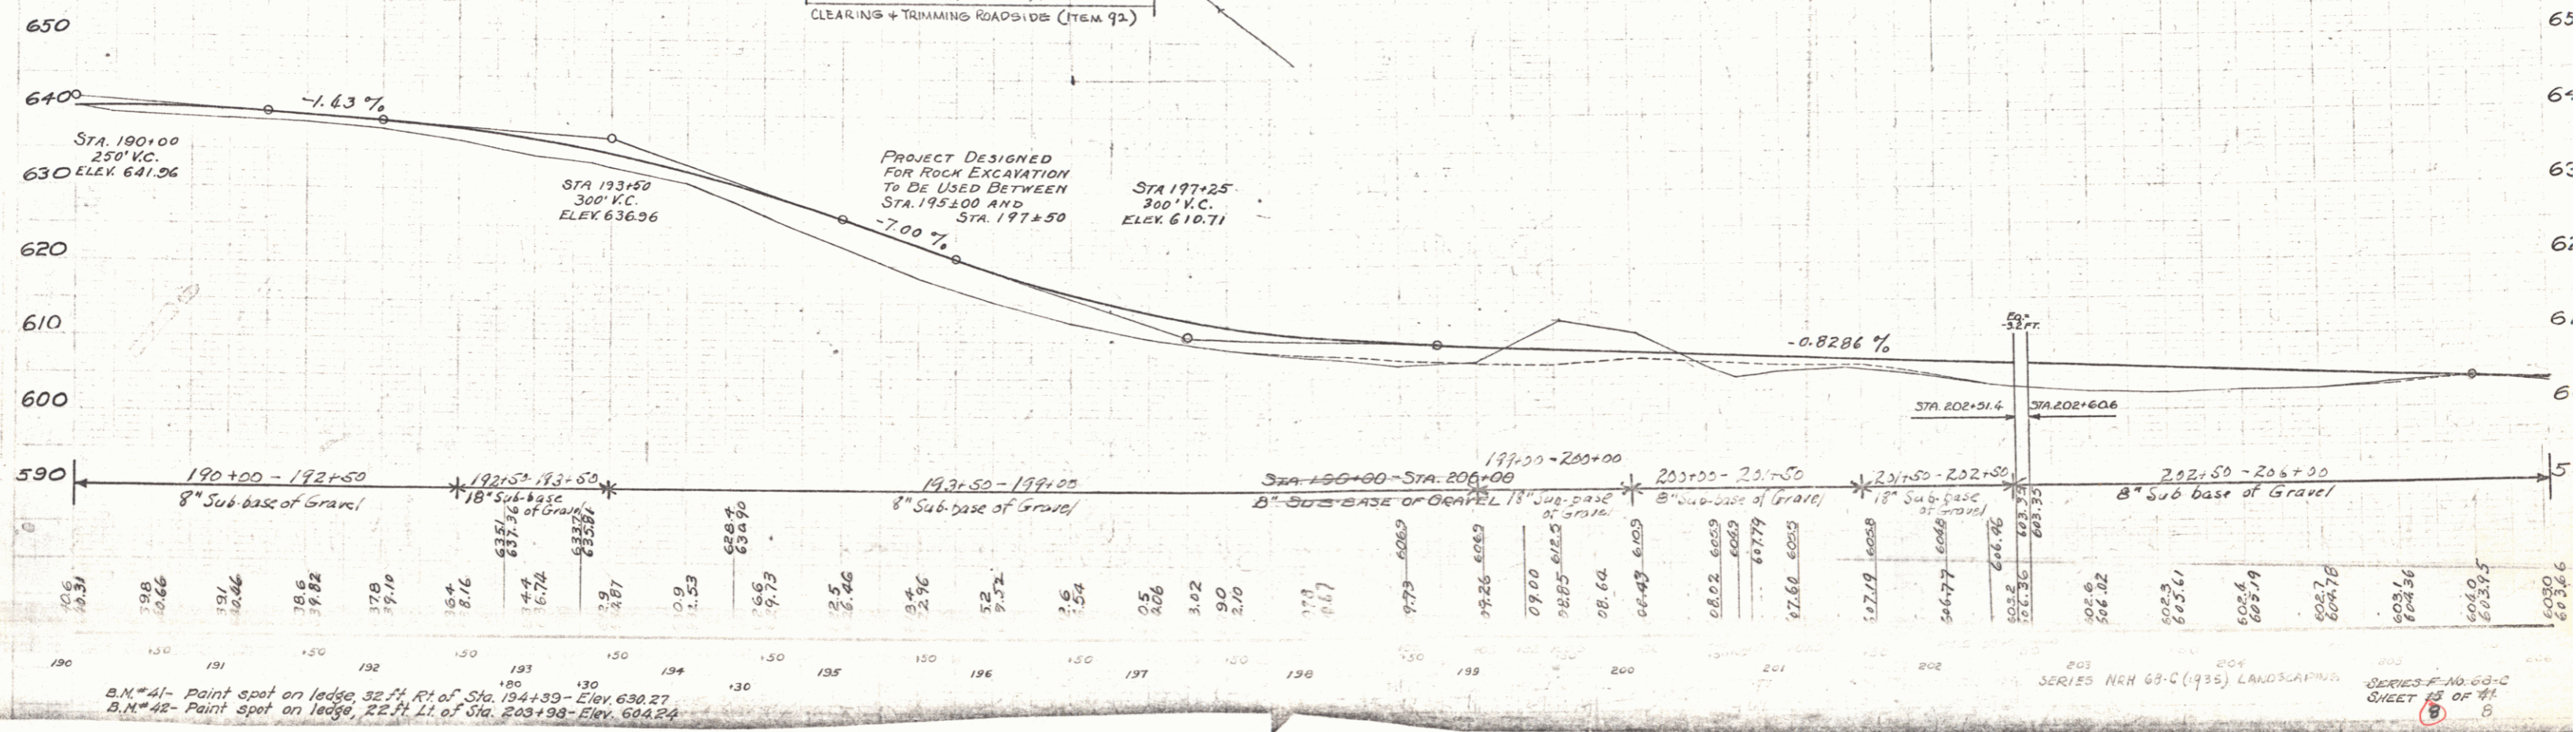


NEW REINF. CONC. PIPE CULVERTS REQUIRED				WOOD GUARD RAIL REQUIRED				CABLE GUARD RAIL REQUIRED			
Station	Diam	Len	Conc. A. Conc. B. Steel	Culv. Station	Left	Right		Station	Left	Right	
198+50	18"	44'	33#	192+50	24'			191+02-192+62	160'		
198+100	18"	44'	33#	198+00	24'	24'		194+70-196+30	160'		
200+76	24"	64'	54#	200+76	24'	24'		202+12-203+00	208'		
203+50	24"	64'	54#	203+00	24'						

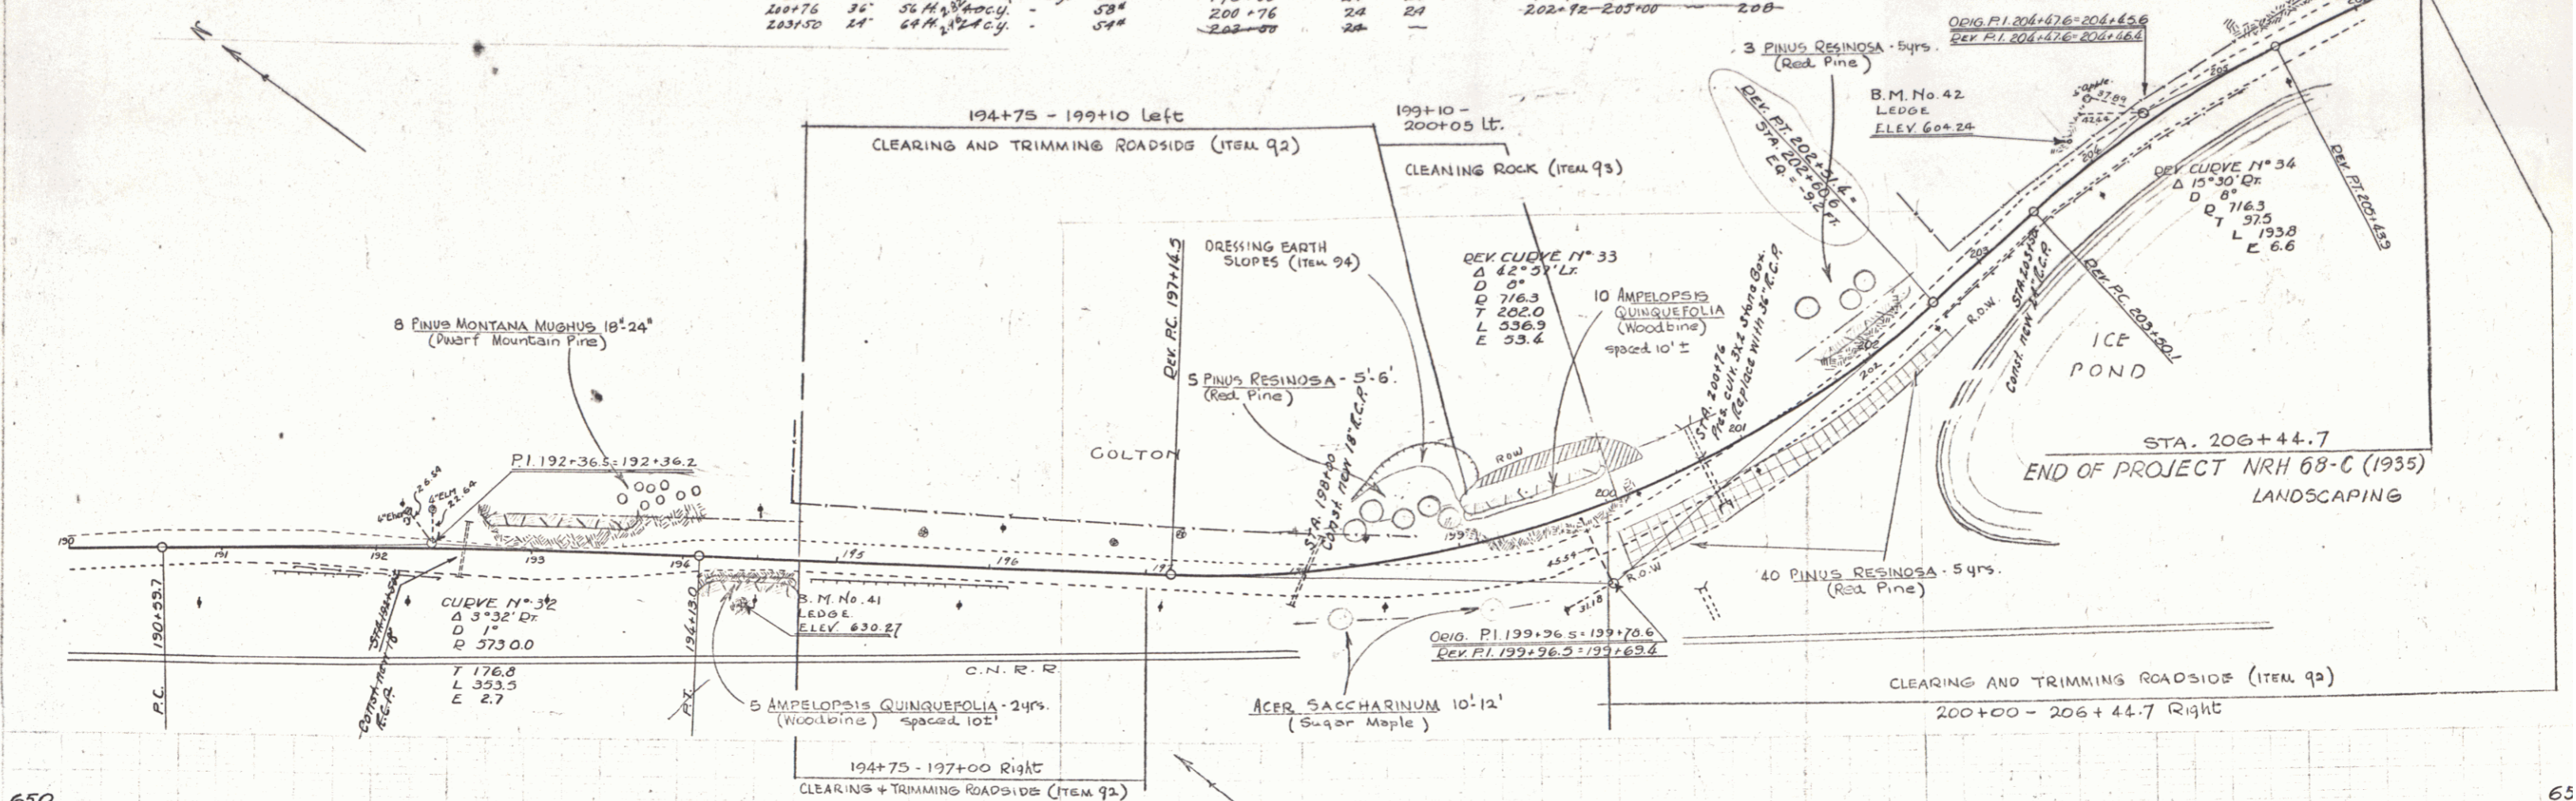

B.M. #41 - Point spot on ledge, 32 ft. Rl. of Sta. 194+39 - Elev. 630.27
 B.M. #42 - Point spot on ledge, 22 ft. Ll. of Sta. 203+98 - Elev. 604.24