


CURVE #3
 Δ - 2° 41' 11"
 D - 0' 00"
 R - 114.072
 T - 24.80
 L - 3367'
 E - 32

CURVE #4
 Δ - 4° 40' 11"
 D - 1' 30"
 R - 3016.0
 T - 155.6
 L - 3111'
 E - 32

KEELER'S BAY

POOR ORIGINAL COPY

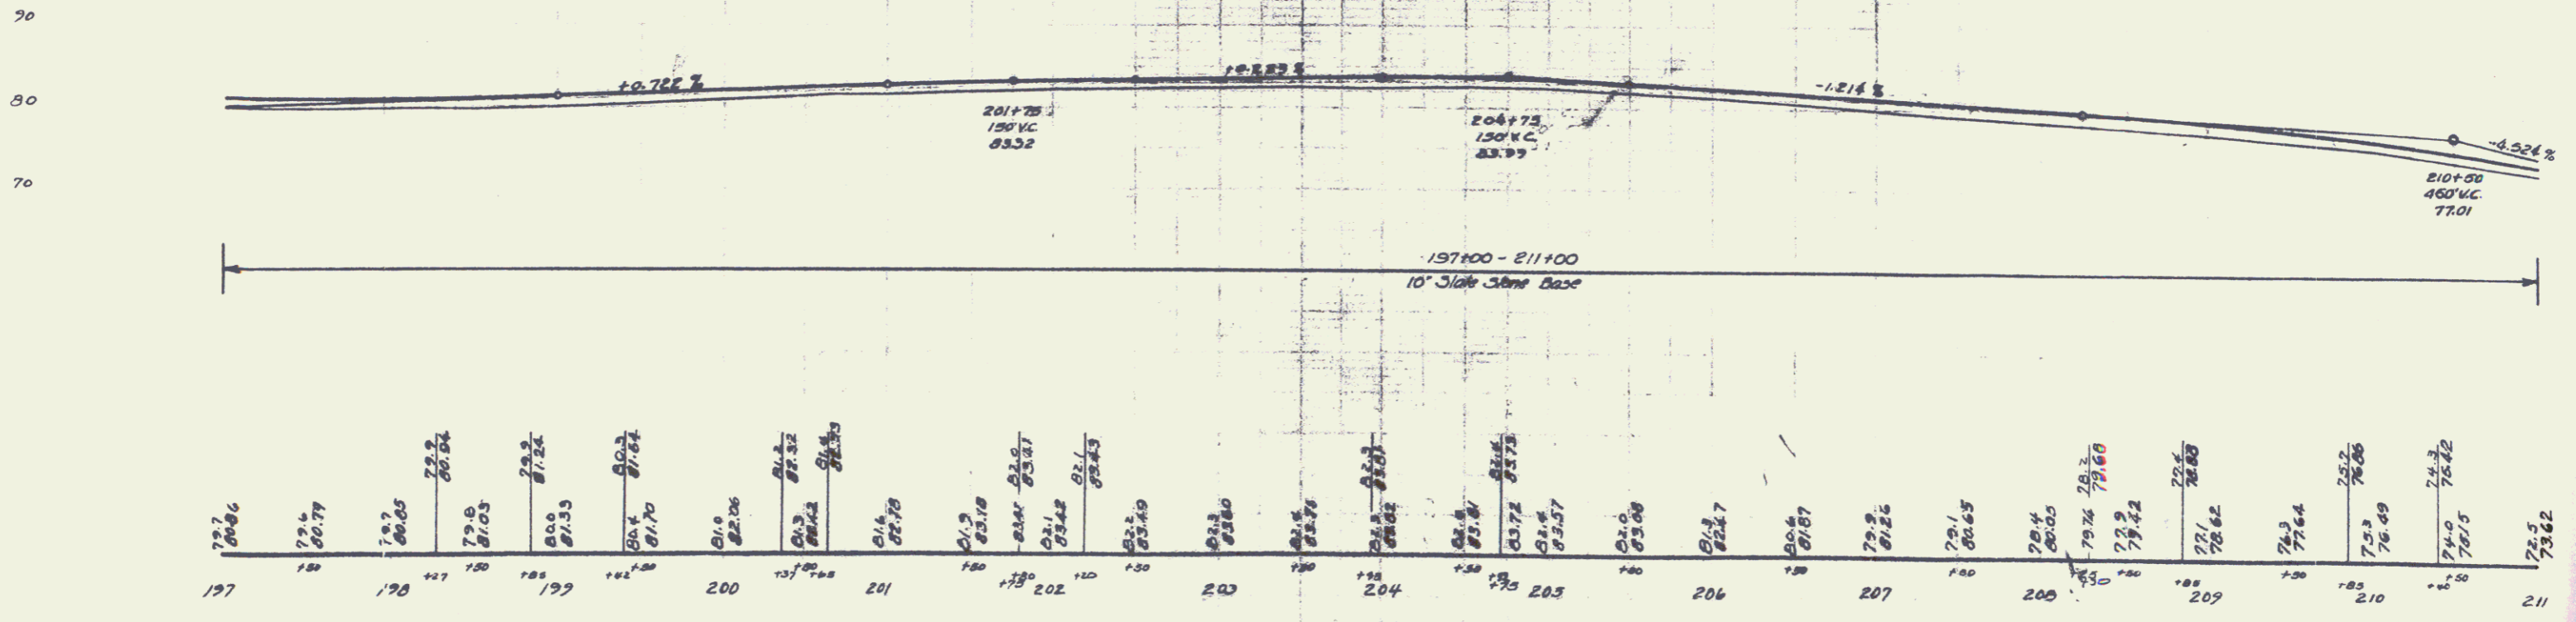

B.M. #83 CONC. GAS PUMP FIDW 43507. 3 1/4" DIA. ELEV. 81.75
 B.M. #80 CONC. GAS PUMP FIDW 43507. 3 1/4" DIA. ELEV. 72.28

SERIES 8 No. 120-M
 SHEET 5 OF 30
 3