



| Parcel | Aid of Instrument | Date of Instrument | Grantor          | Grantee   | Recorded South Here | Remarks      |
|--------|-------------------|--------------------|------------------|-----------|---------------------|--------------|
| A      | Q.C.D.            | 8-16-32            | Levis E. Blaw    | St. of Yk | 15                  | 87-83 114632 |
| A'     | "                 | 8-16-32            | Edwin H. Jansdgn | "         | 16                  | 81-88 114632 |

CURVE NO. 5  
 A 1° 25' 24"  
 D 0' 30"  
 R 1145.382  
 T 144.7  
 L 233.3  
 E 0.0

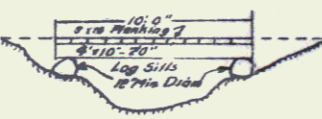


128-M-1932

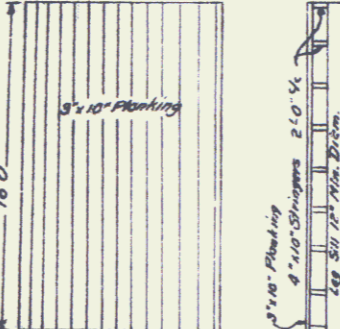


DETAILS OF CONSTRUCT FOR TIMBER BRIDGE  
 STA. 221+00 LI TO 228+00 LI

TIMBER BRIDGES TO BE PAID FOR ON A COST PLUS 15% BASIS

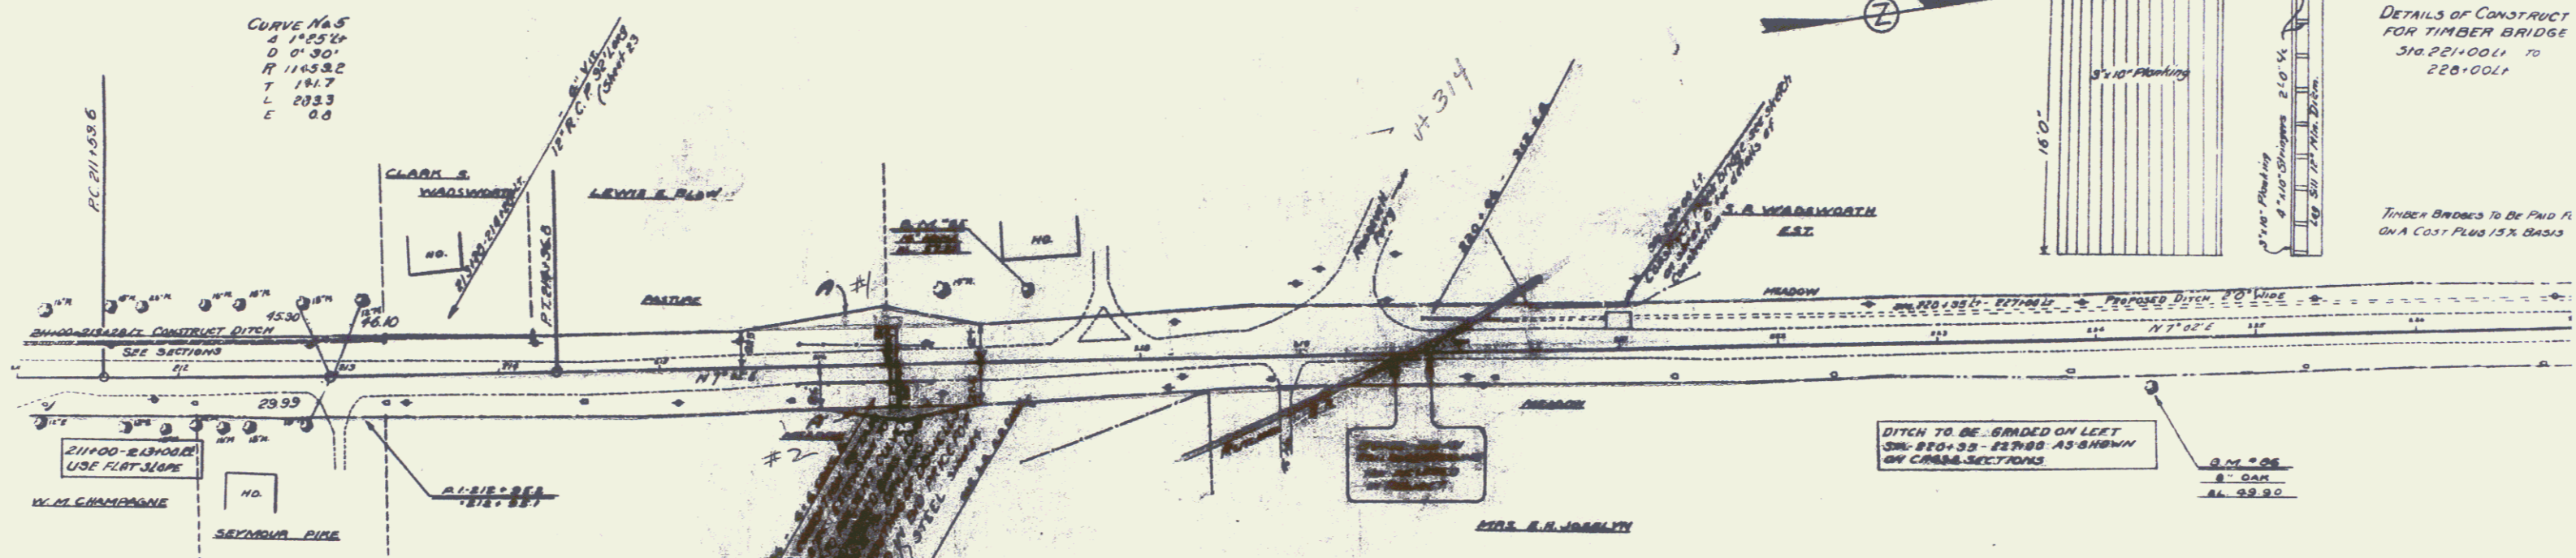

POOR ORIGINAL COPY

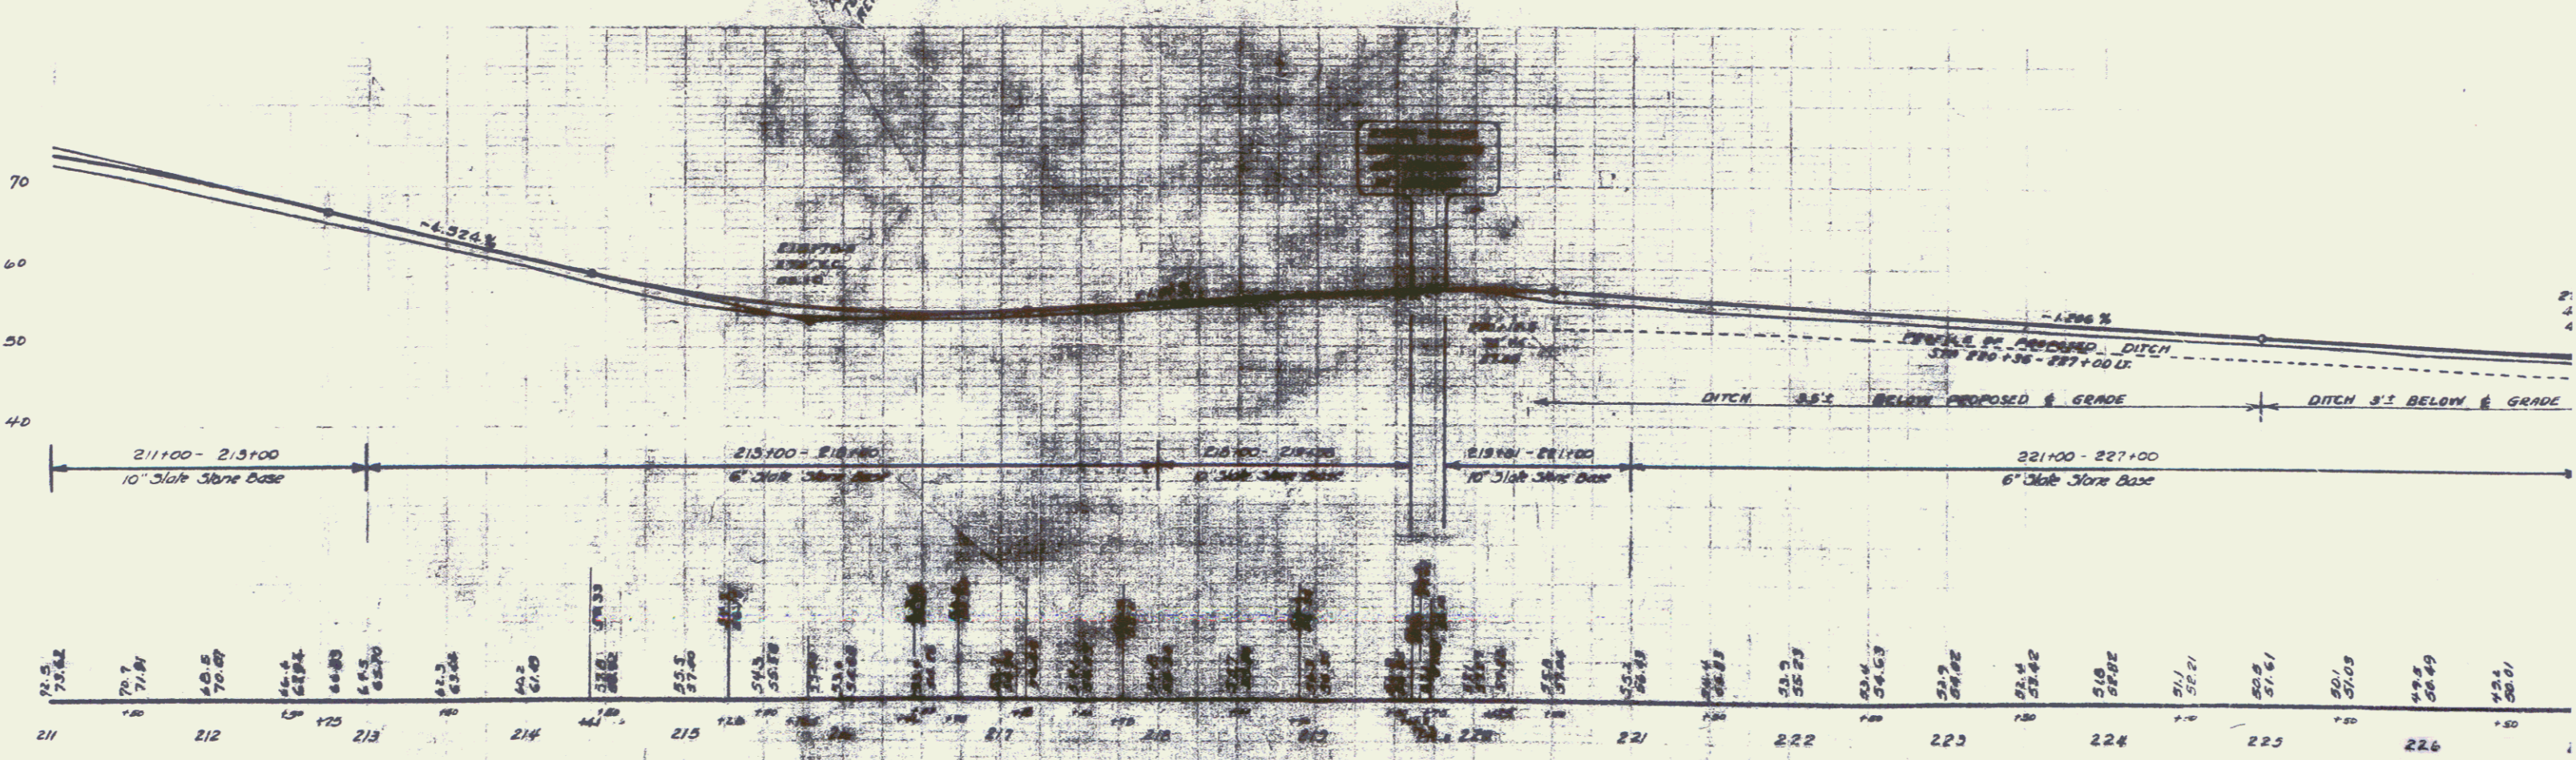

8" M. 85 SPIRE IN ROOT 16" MAPLE 40' LT. STA. 217+34 ELEV. 47.88  
 8" M. 86 SPIRE IN ROOT 8" OAK 2' RT. STA. 224+32 ELEV. 48.90

SERIES No 128-S  
 SHEET 6 OF 30