



Parcel	Kind of	Date of	Grantor	Grantee	Recorded	Remarks
B'	GC.D	0-12-32	Ellen W. Jesselyn	Sleafth	Book Page Date	
					15 01-02 11-24-32	

12071932

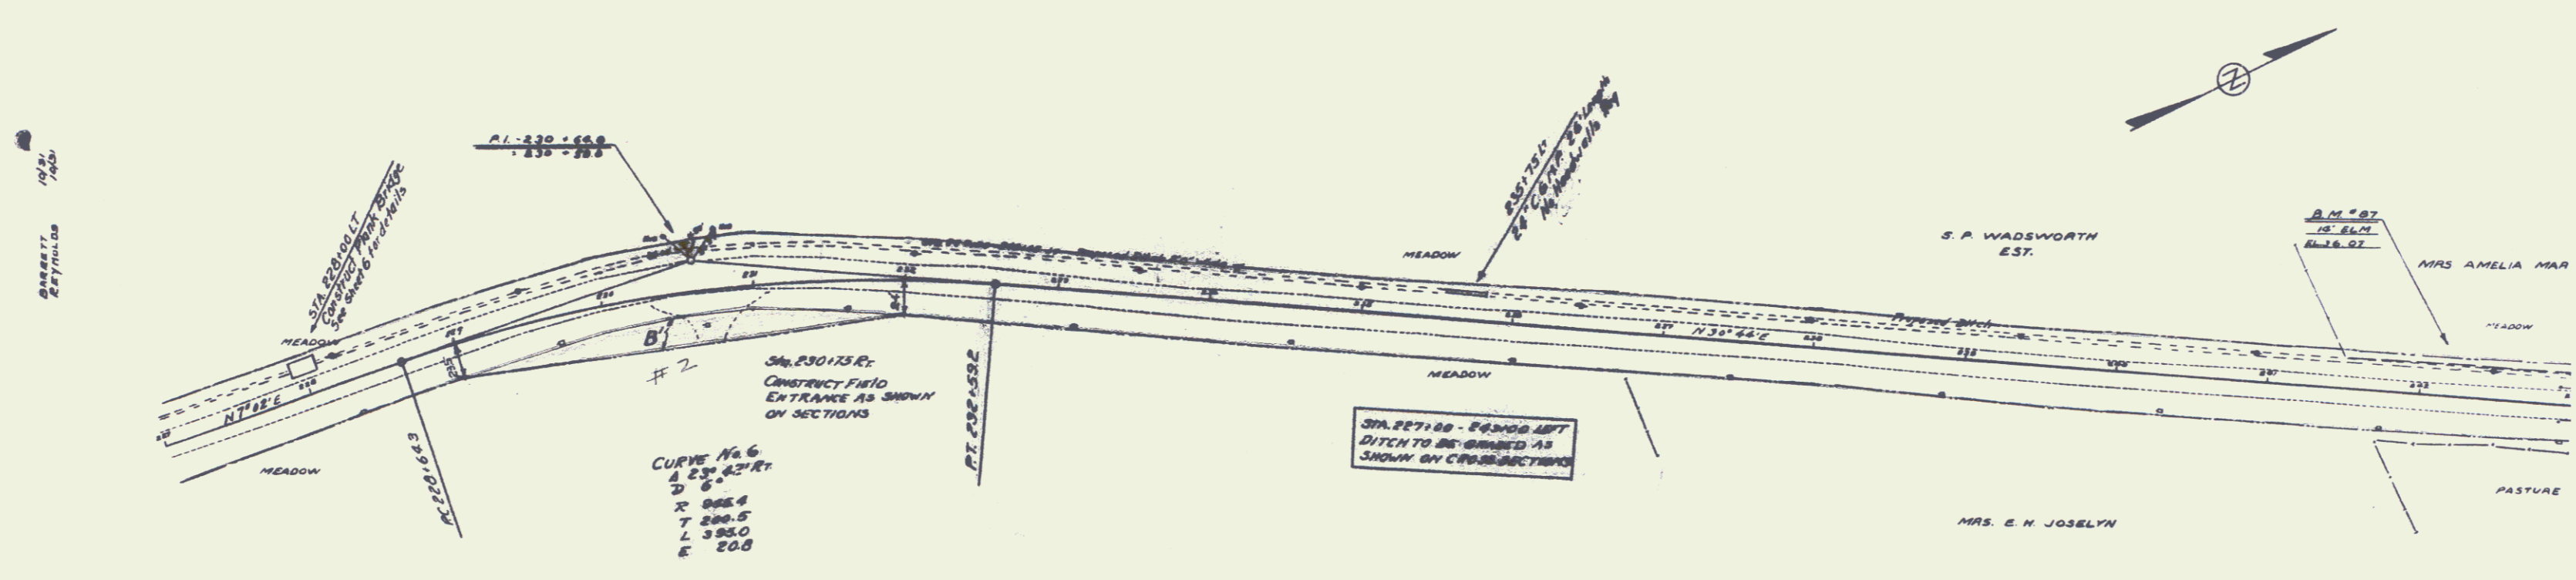

POOR ORIGINAL COPY

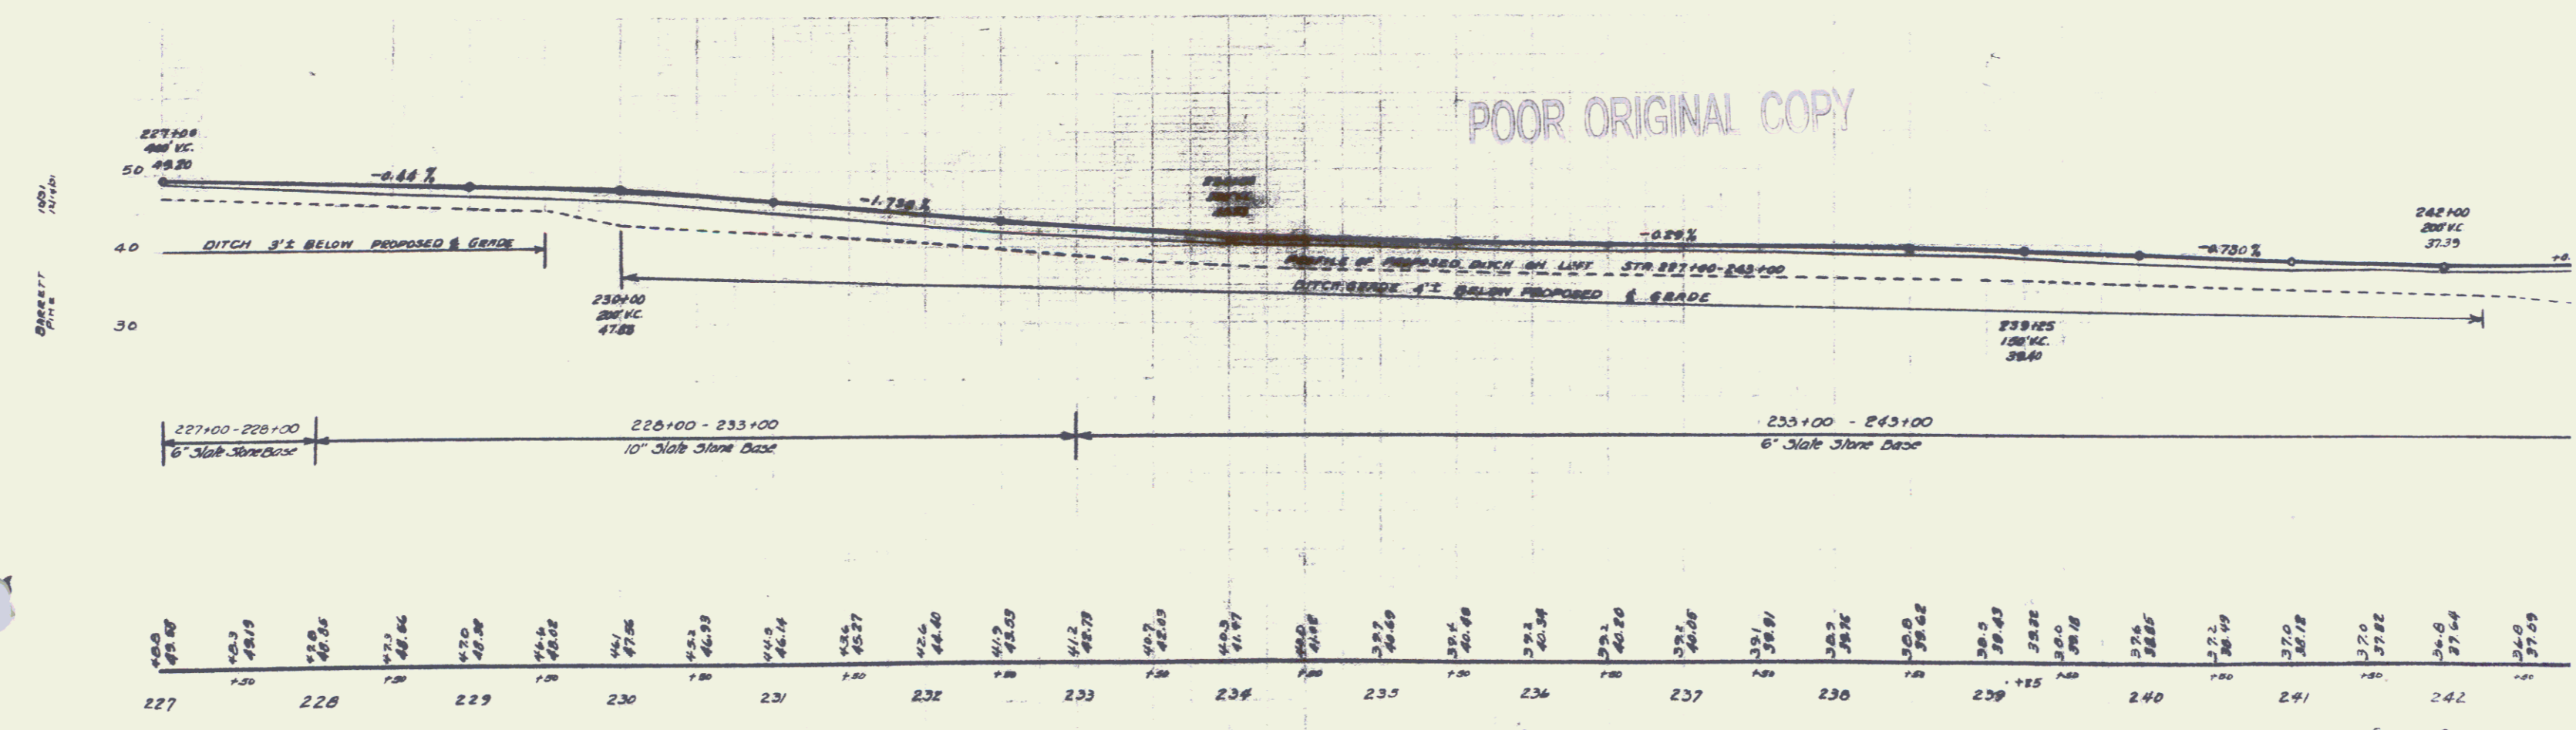

B.M. # 87 SPIKE IN ROOT 14' 8 1/2" 237 FT. LT. STA 242+17 ELEV 36.07

SERIES # 70 120-M  
SHEET 7 OF 50