



Parcel	Kind of Instrument	Date of Grant	Grantor	Grantee	Recorded Book Page	Remarks
Col. #1	Q.C.D.	8-18-38	Edw. Martel & wife	St. off. H.	11 345	8-18-38 Cont. 56, 32, 11, 50

12-B-M 1932 13

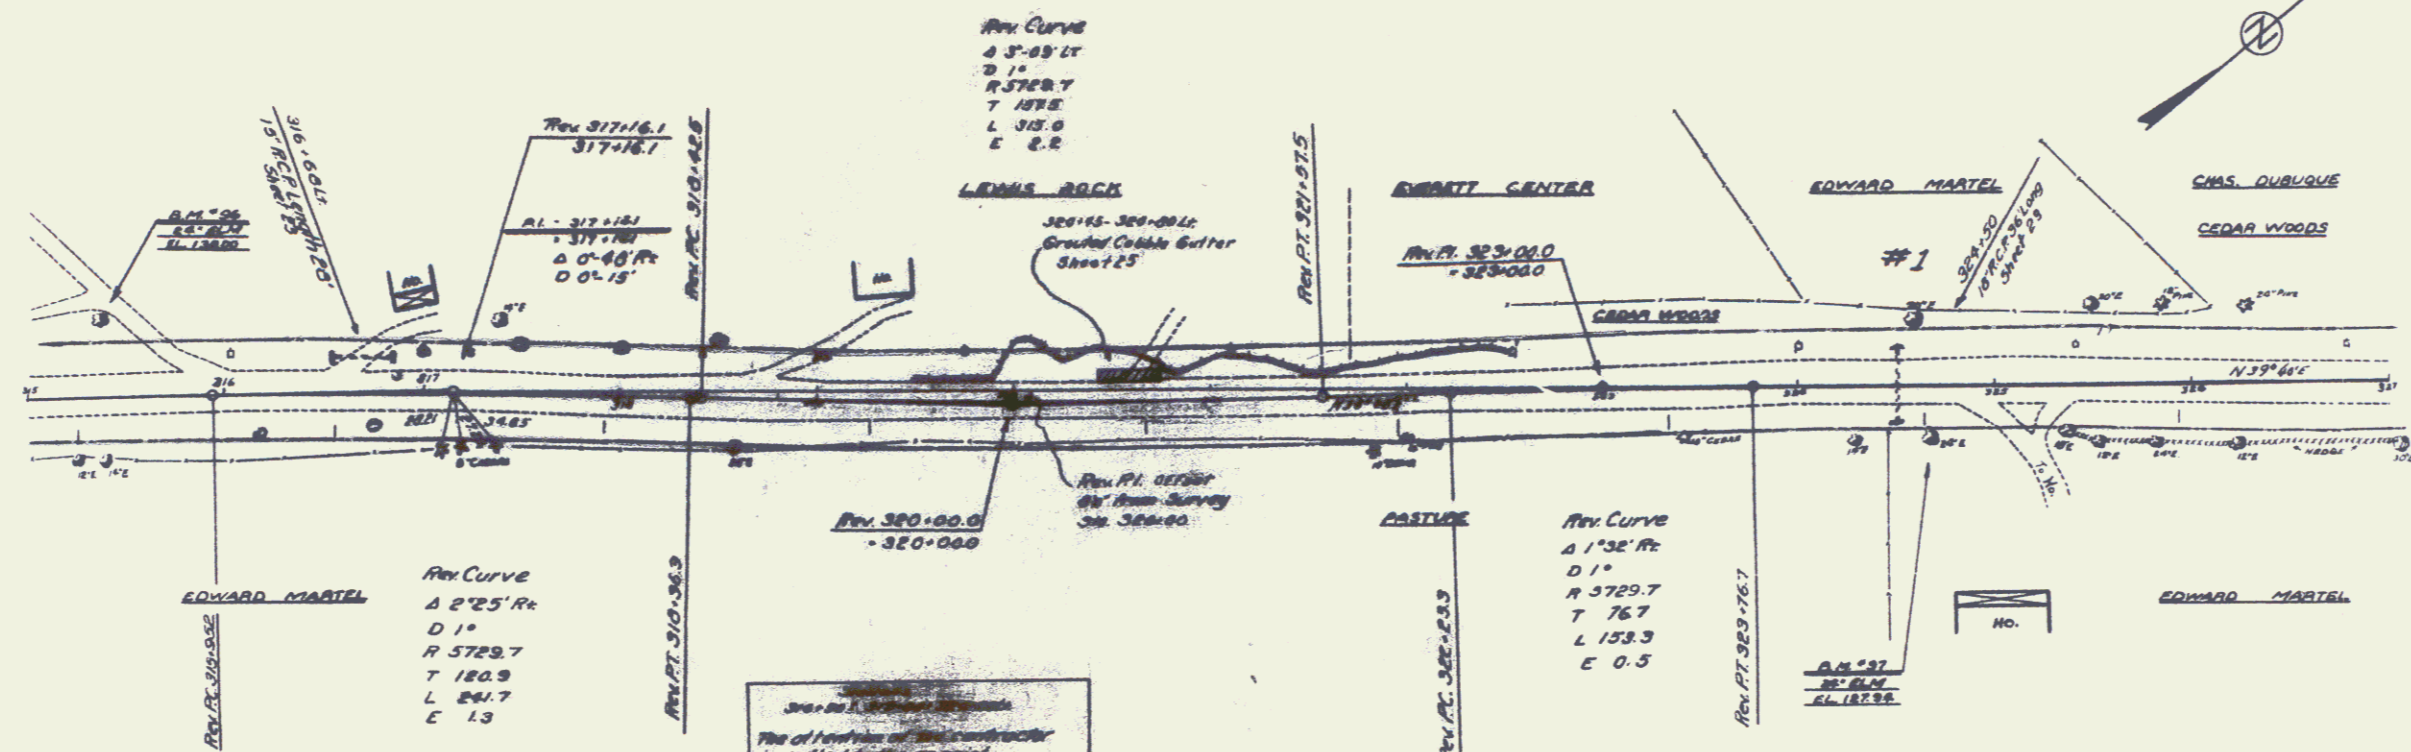

The of position of this structure is called for the original papers made in this connection. See sheet 2 for details.

POOR ORIGINAL COPY

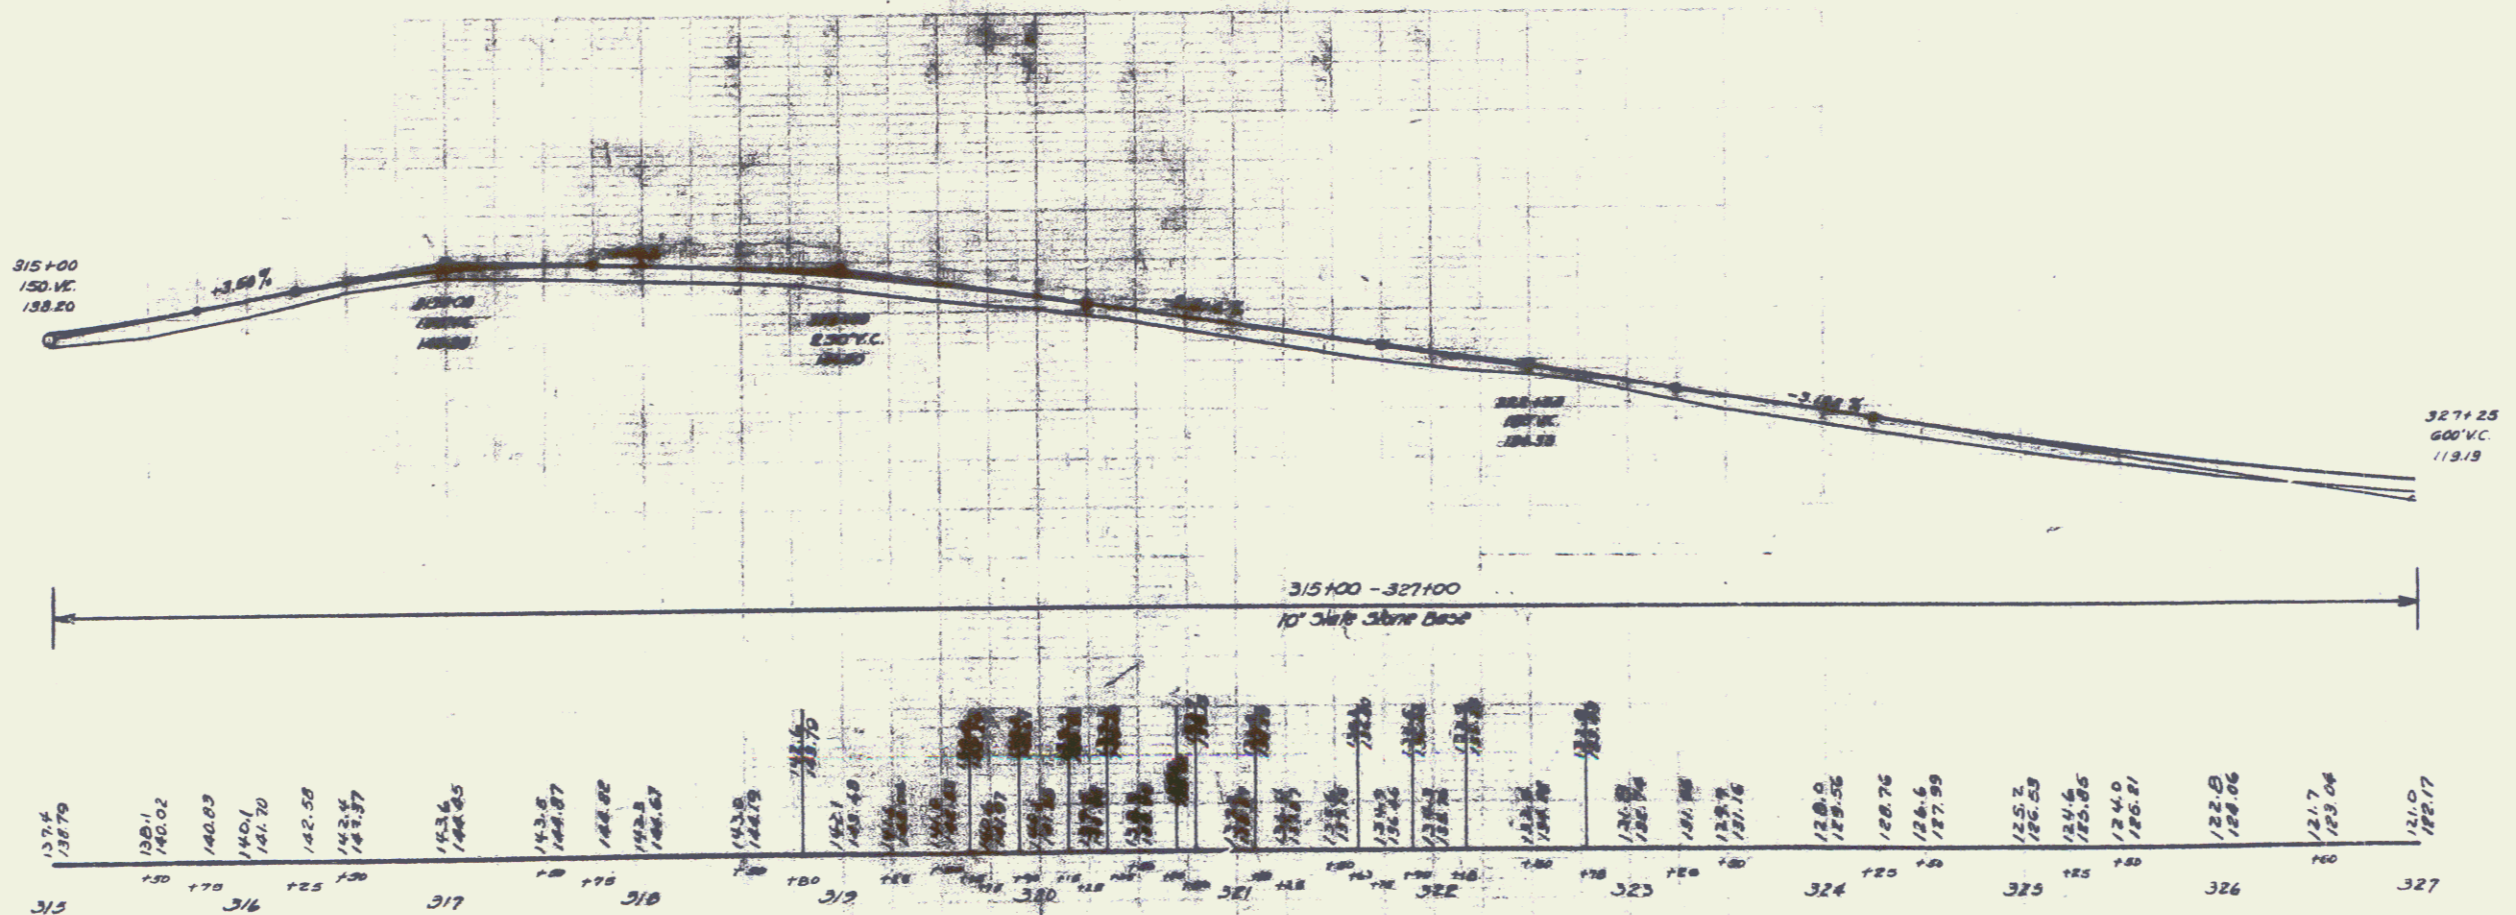

8" # 96 SPIRE IN ROOT 20' ELM. 37 FT. LT. STA. 315+33 ELEV. 138.00
 8" # 97 SPIRE IN ROOT 24' ELM. 24 FT. RT. STA. 326+67 ELEV. 127.24

SERIES 5 Y 18-M
 SHEET 2 OF 59 12