



BARRETT REYNOLDS 1931

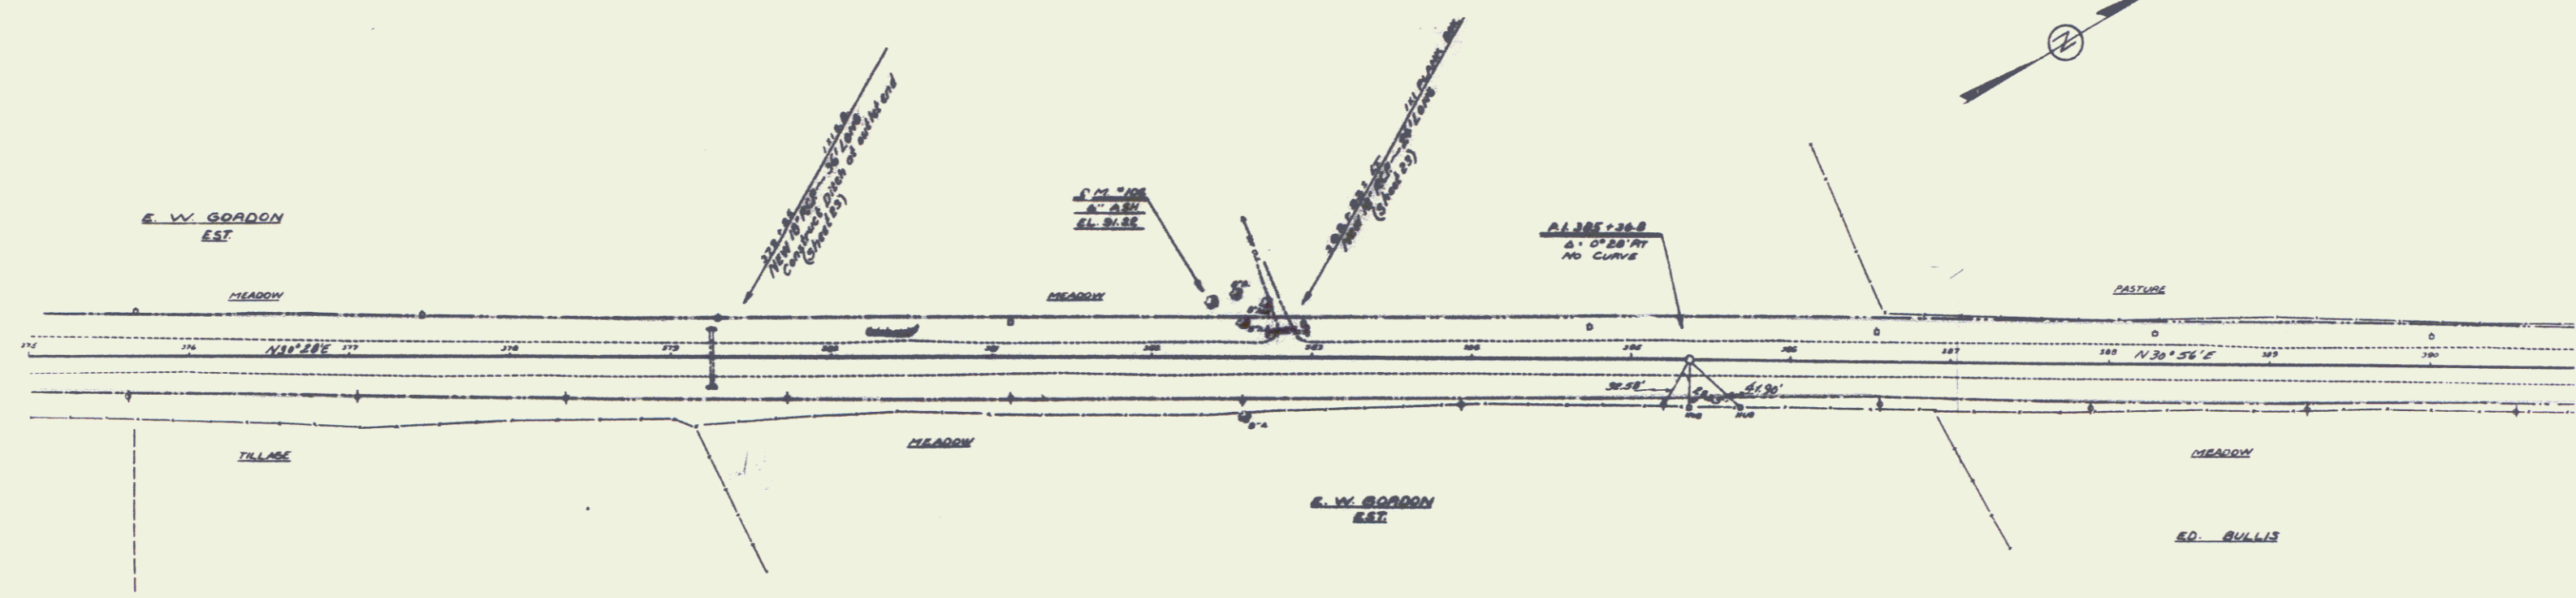

BARRETT PINE 1931

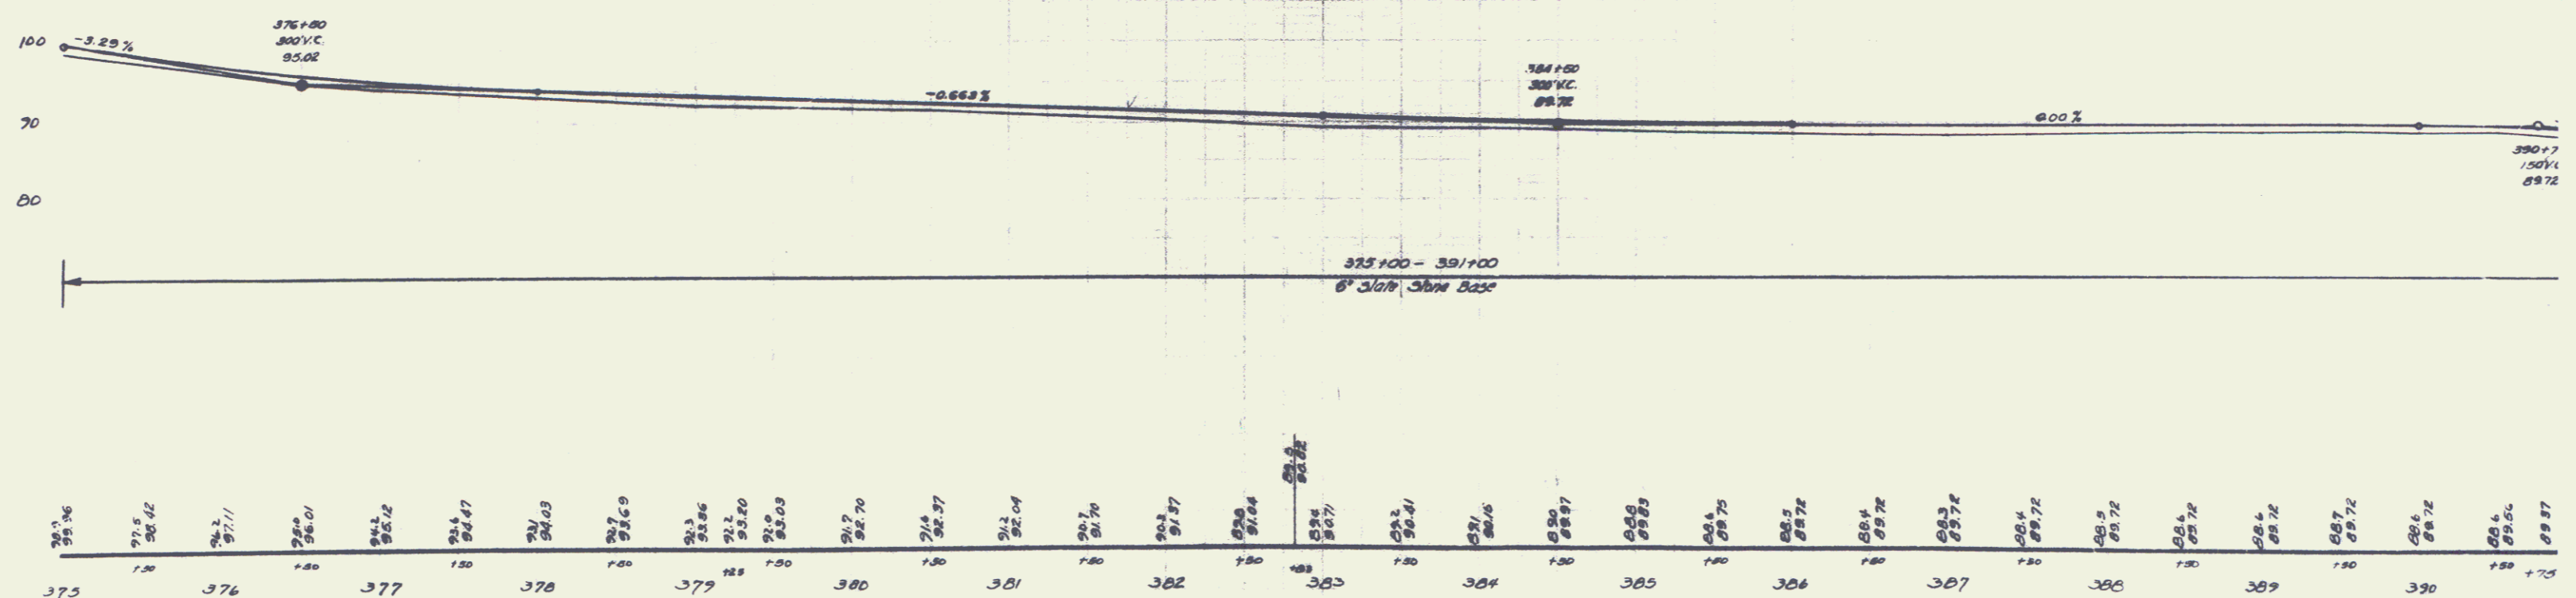

B.M. # 104 SPIKE IN ROOT 6" ASH 30.5 FT. LT. STA 382+37 ELEV 91.22