


POOR ORIGINAL COPY

VERTICAL SCALE  
1" = 10'

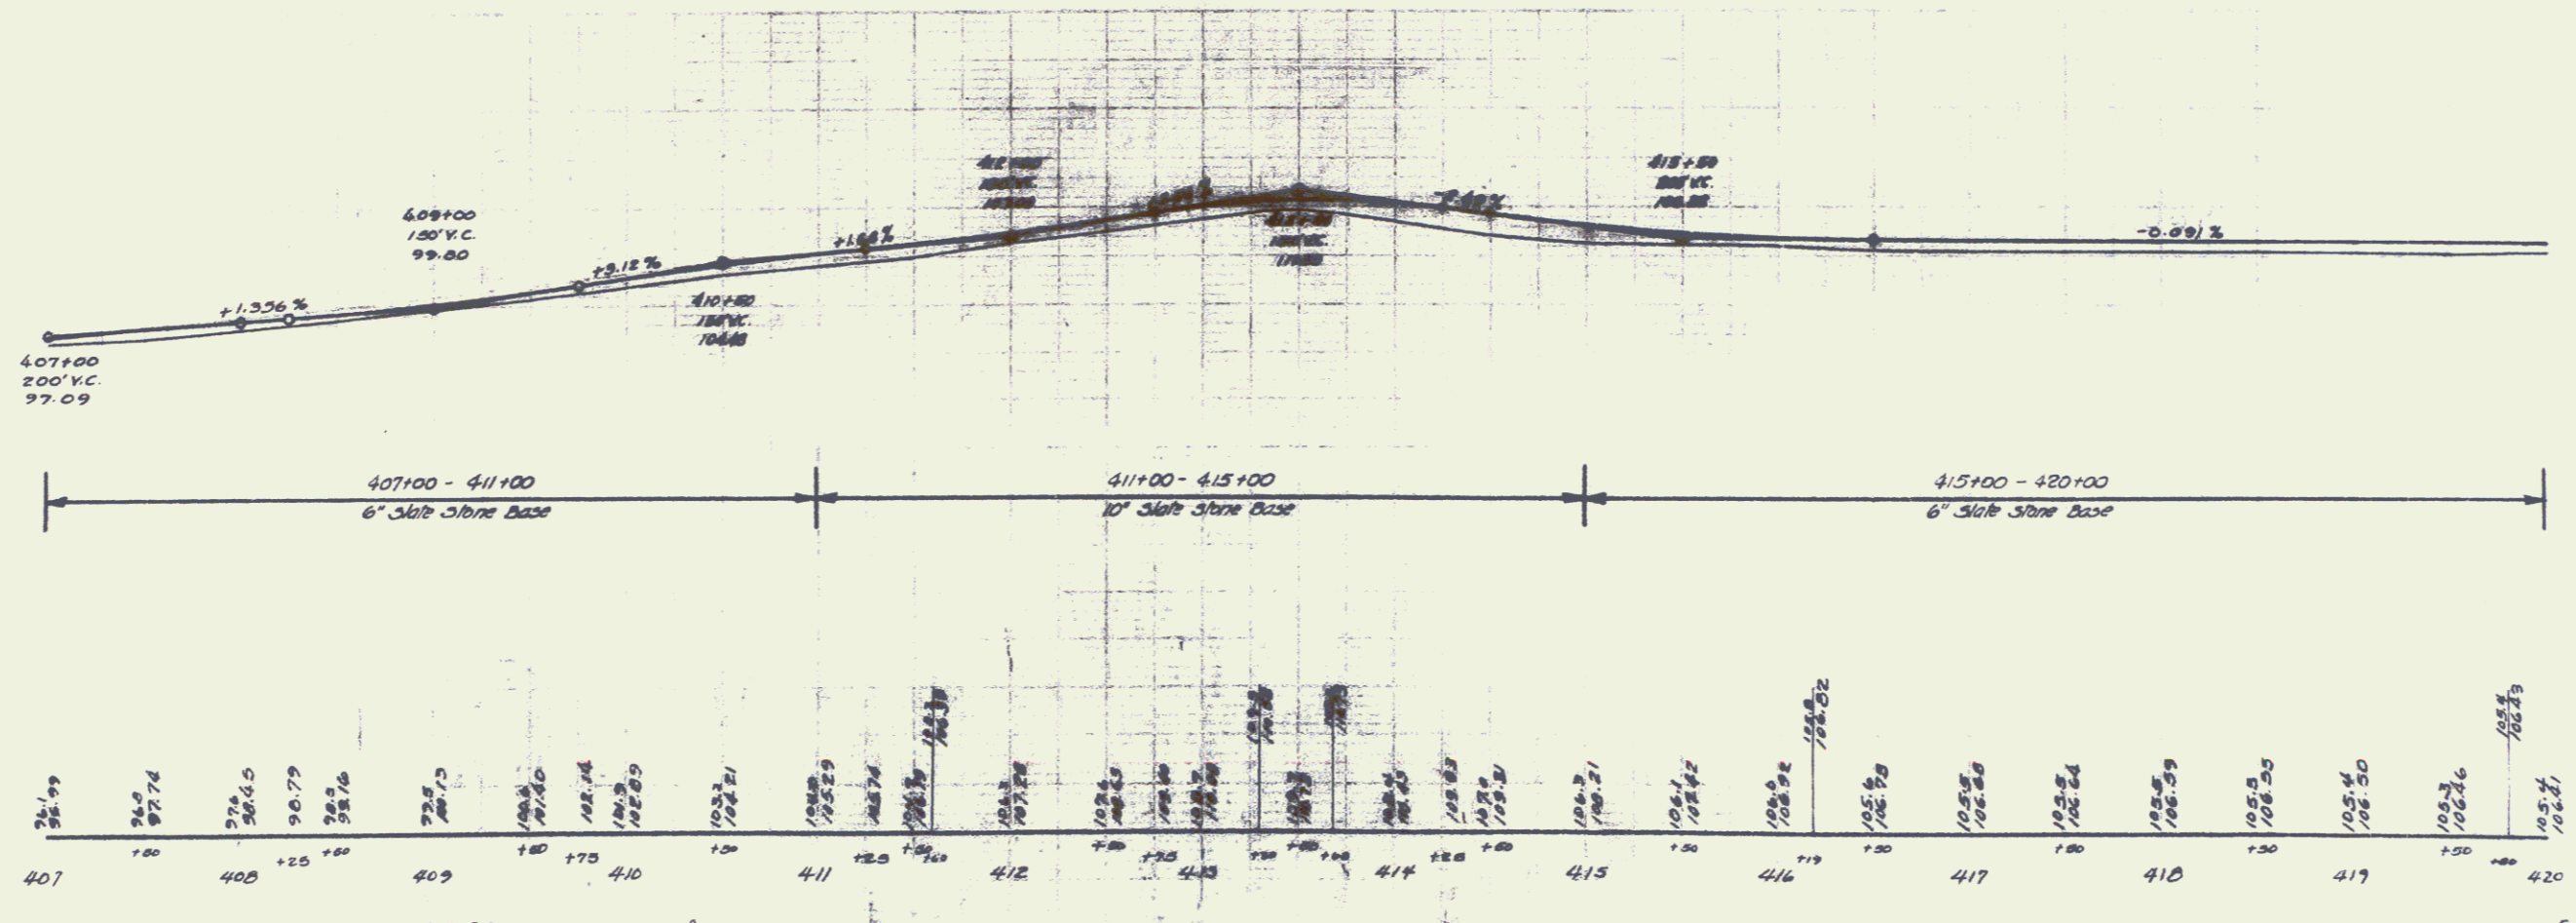

B.M. 107 SPIKE IN ROOT 18" ELM 37 FT. LT.