
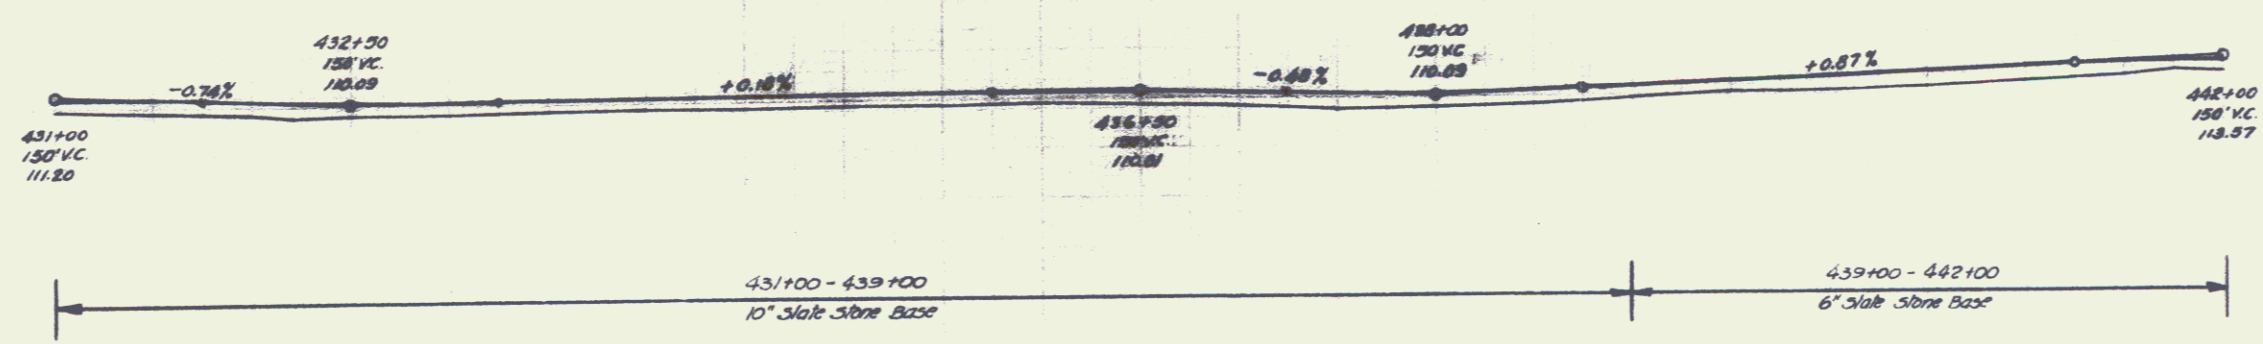


DRETT  
REYNOLDS

DRETT  
PINE

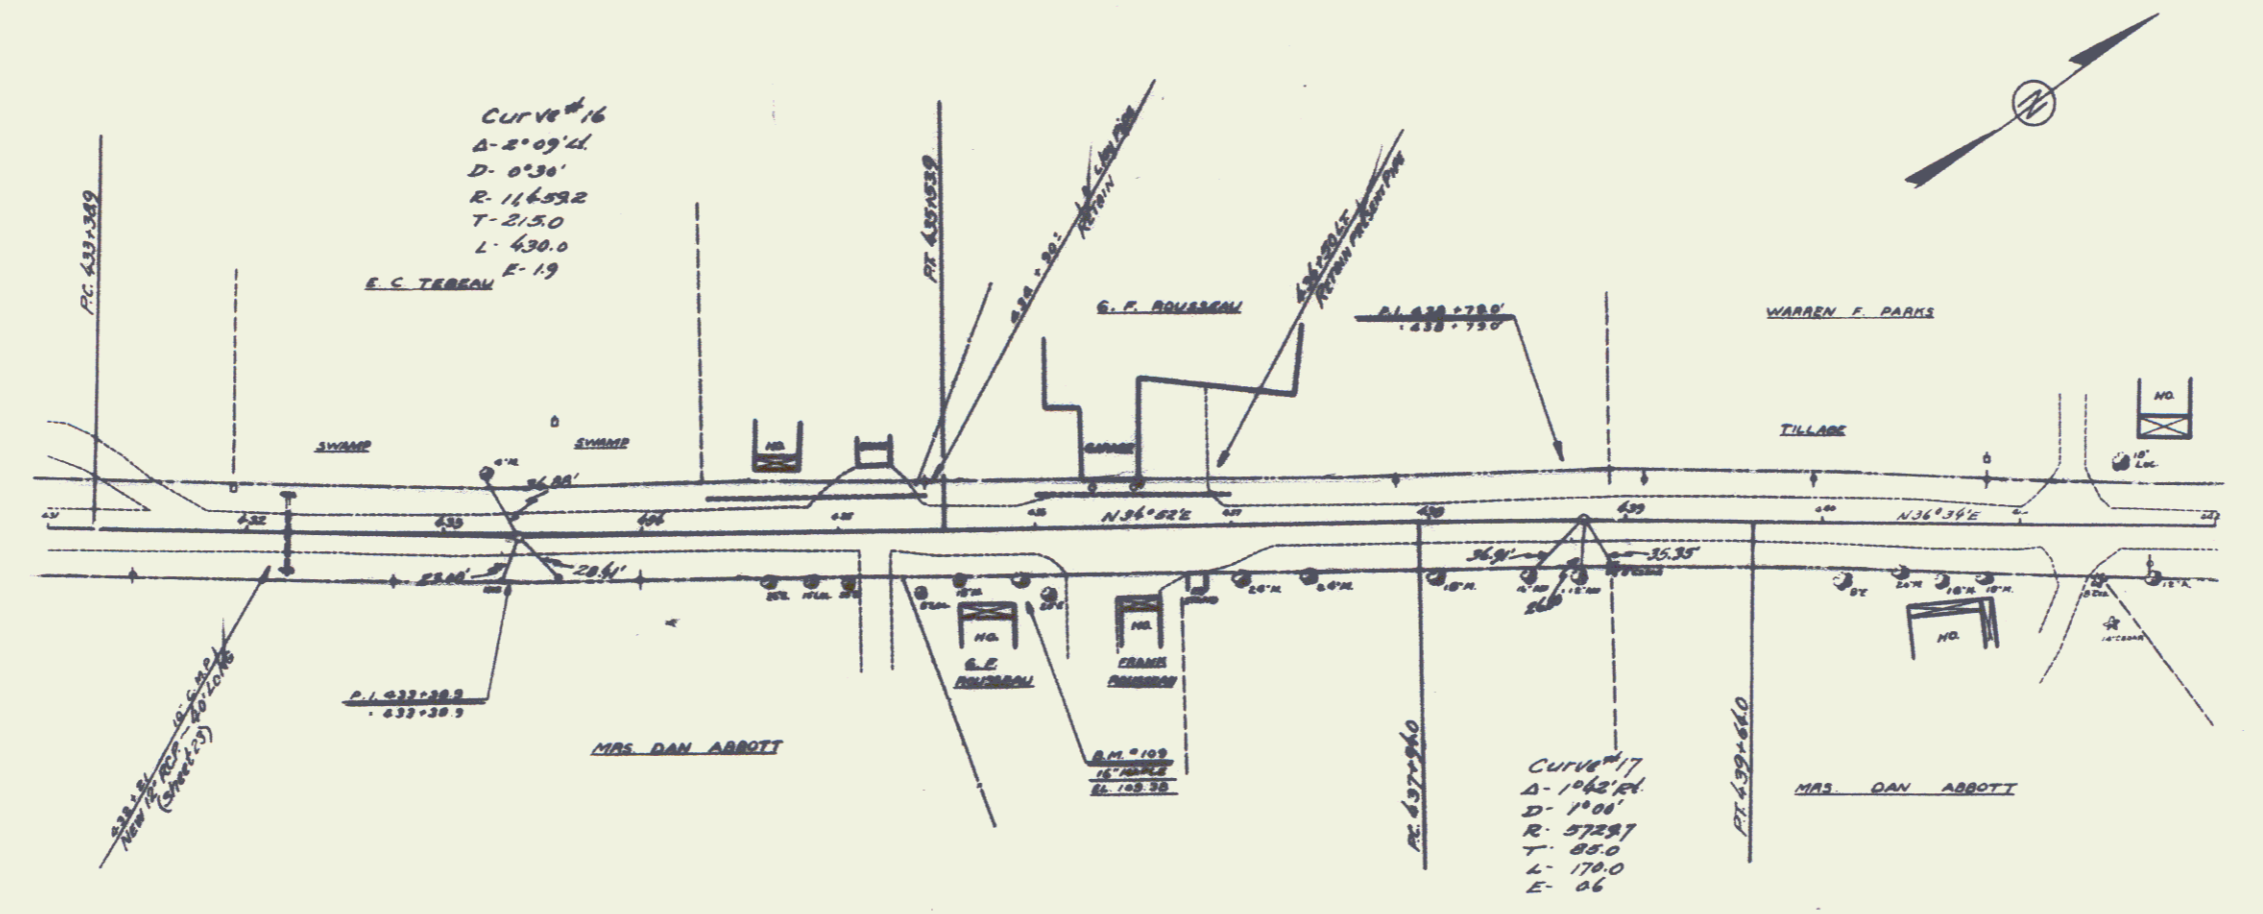

431	432	433	434	435	436	437	438	439	440	441	442
109.84	109.86	109.84	109.82	109.80	109.78	109.76	109.74	109.72	109.70	109.68	109.66
110.84	110.86	110.84	110.82	110.80	110.78	110.76	110.74	110.72	110.70	110.68	110.66
111.84	111.86	111.84	111.82	111.80	111.78	111.76	111.74	111.72	111.70	111.68	111.66

B.M. #109 SPIKE IN ROOT 16" MAPLE 25 FT. RT. STA. 435+90 ELEV. 105.38