


Construct Drives
 643+48 Lt. V
 648+79 Lt. V
 650+92 Rt. V
 656+70 Lt. V
 657+08 Rt. V
 657+71 Rt. V

Jute Matting Item 623
 -647+00 - 652+00 Lt.

Seeding Item 611
 Fertilizer Item 615
 100001 Item 621
 649+00 - 650+85 Rt.
 655+50 - 656+85 Lt.

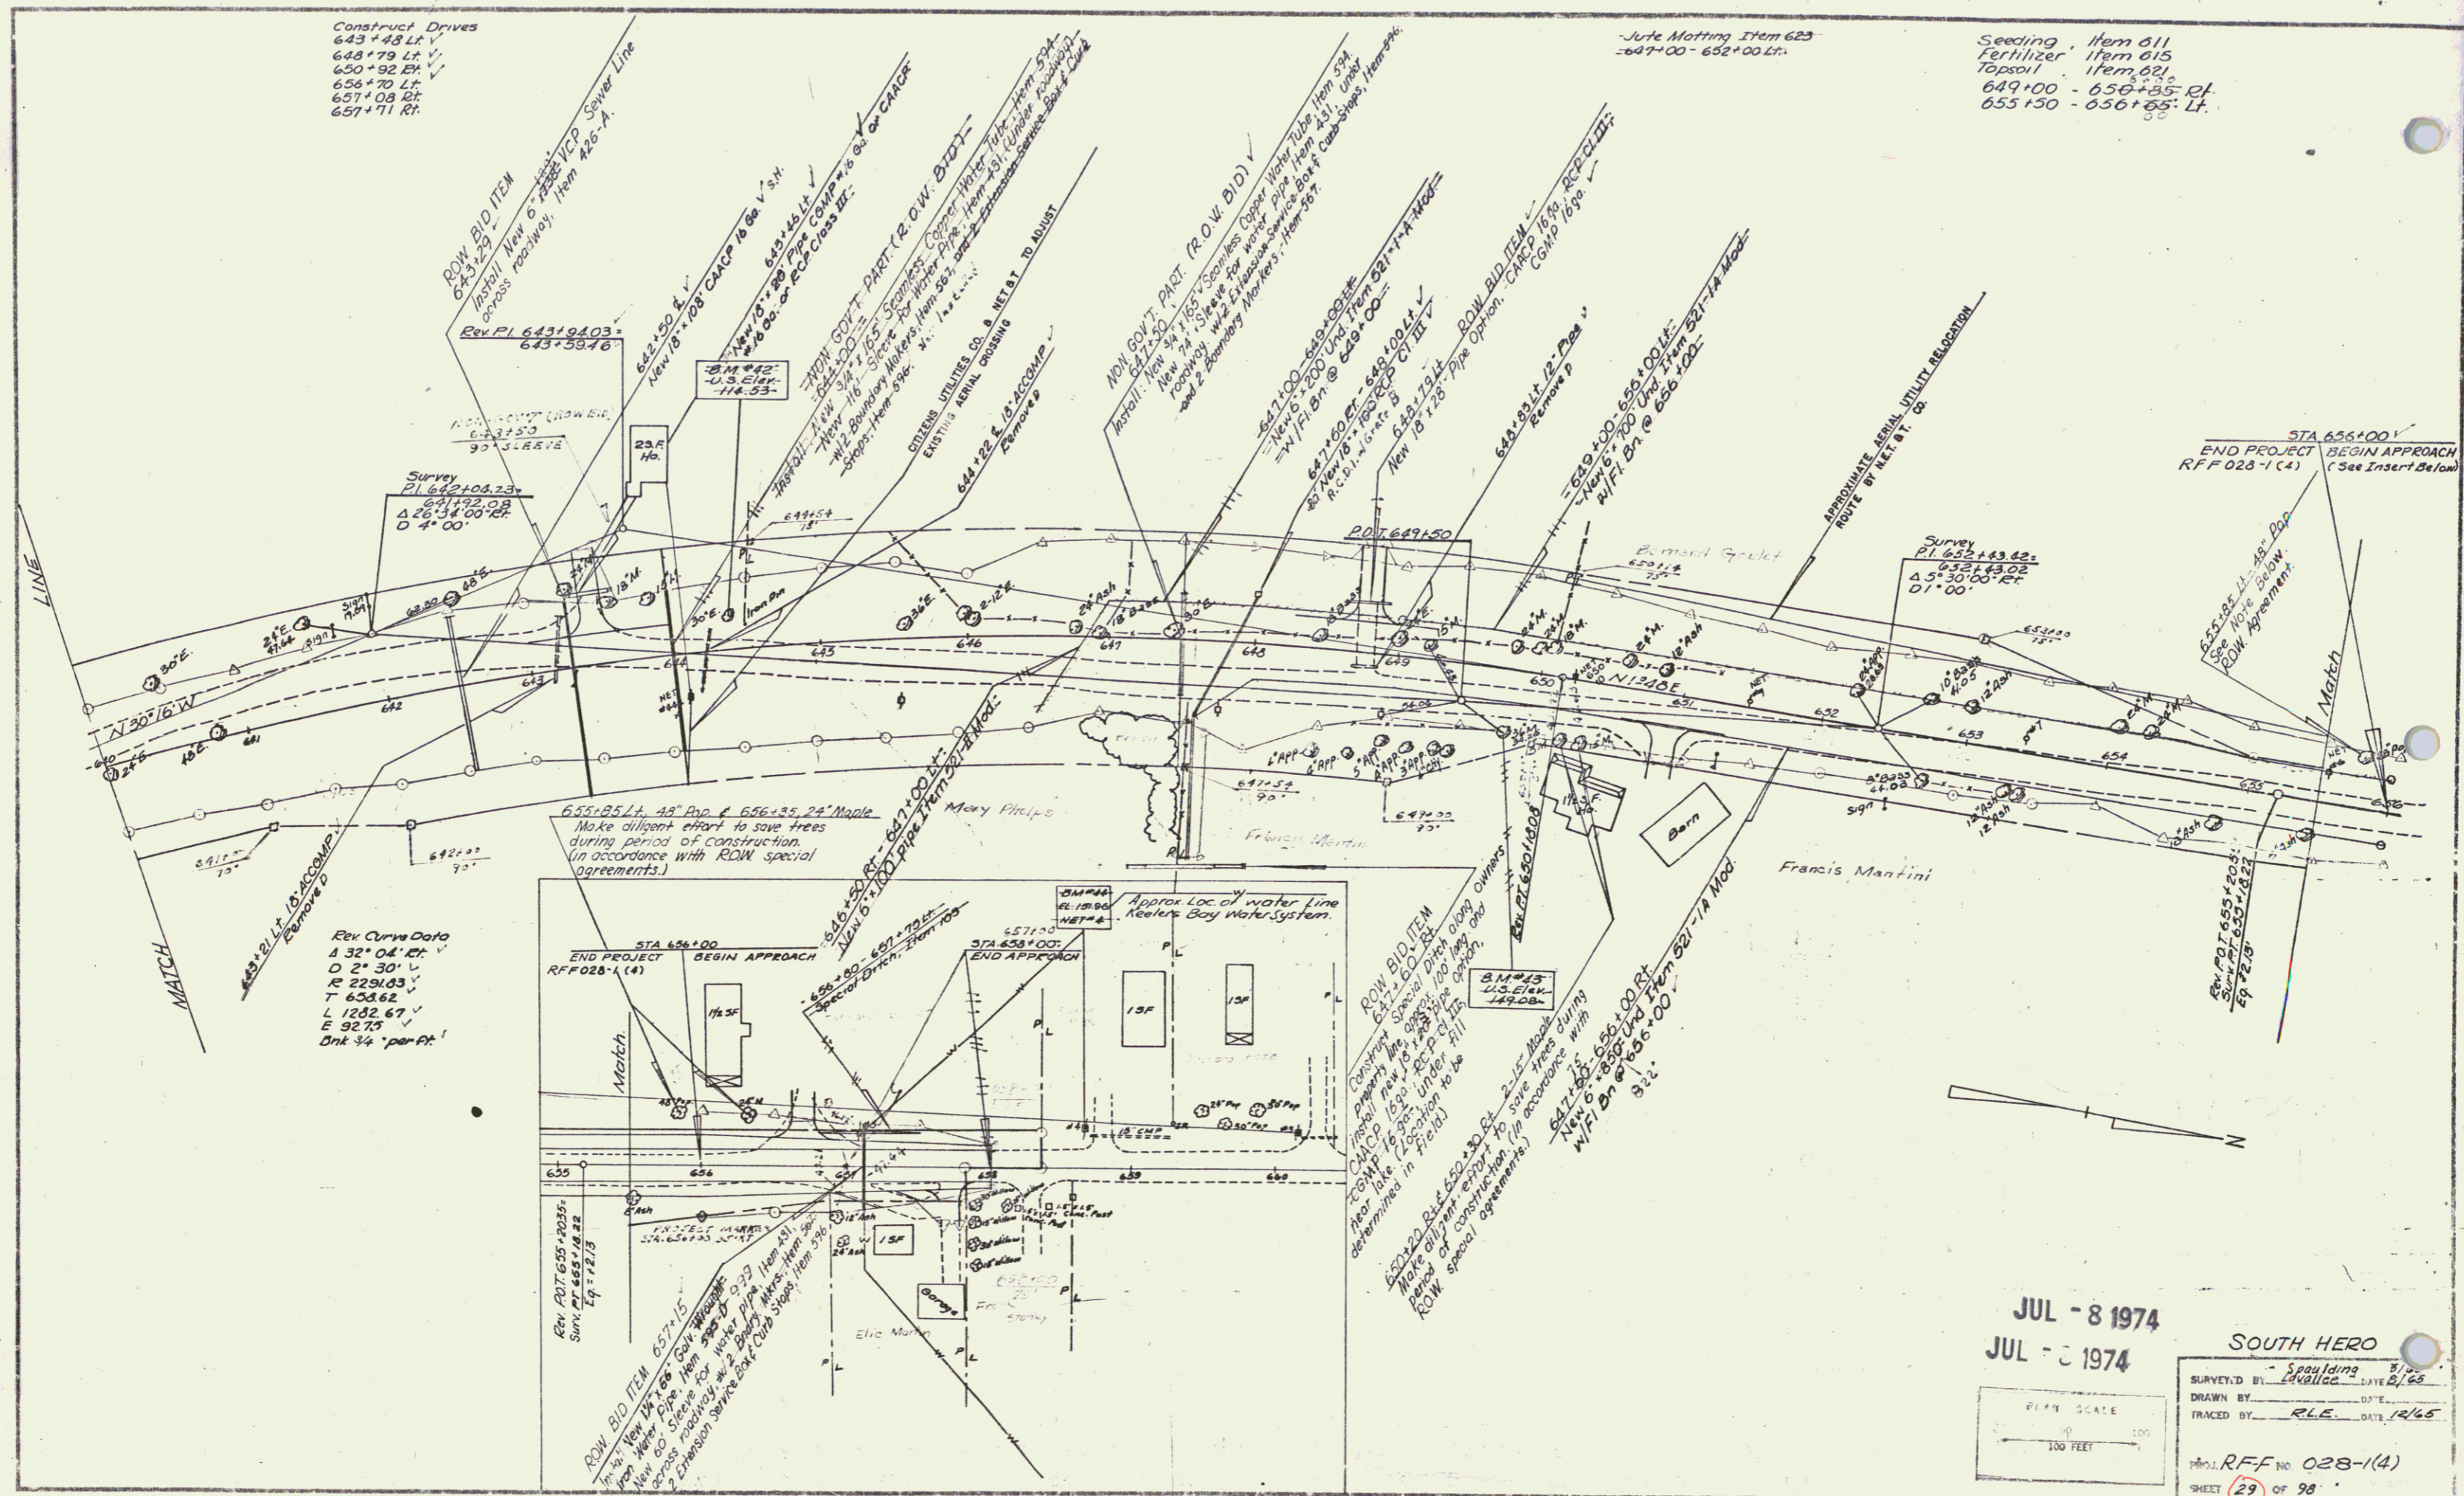

Rev Curve Data
 Δ 32° 04' Cr.
 D 2° 30' Cr.
 R 229.03
 T 638.62
 L 1282.67
 E 92.75
 Bnk 3/4' per Ft.

STA 656+00
 END PROJECT BEGIN APPROACH
 RFF 028-1 (4)

ROW BID ITEM
 Construct 18\"/>

JUL - 8 1974
 JUL - 8 1974

SOUTH HERO

SURVEYED BY Spaulding 8/65
 DRAWN BY Equella DATE 8/65
 TRACED BY RLE DATE 1/65

Scale: 1" = 100 FEET

RFF No 028-1(4)
 SHEET 29 of 98

13