
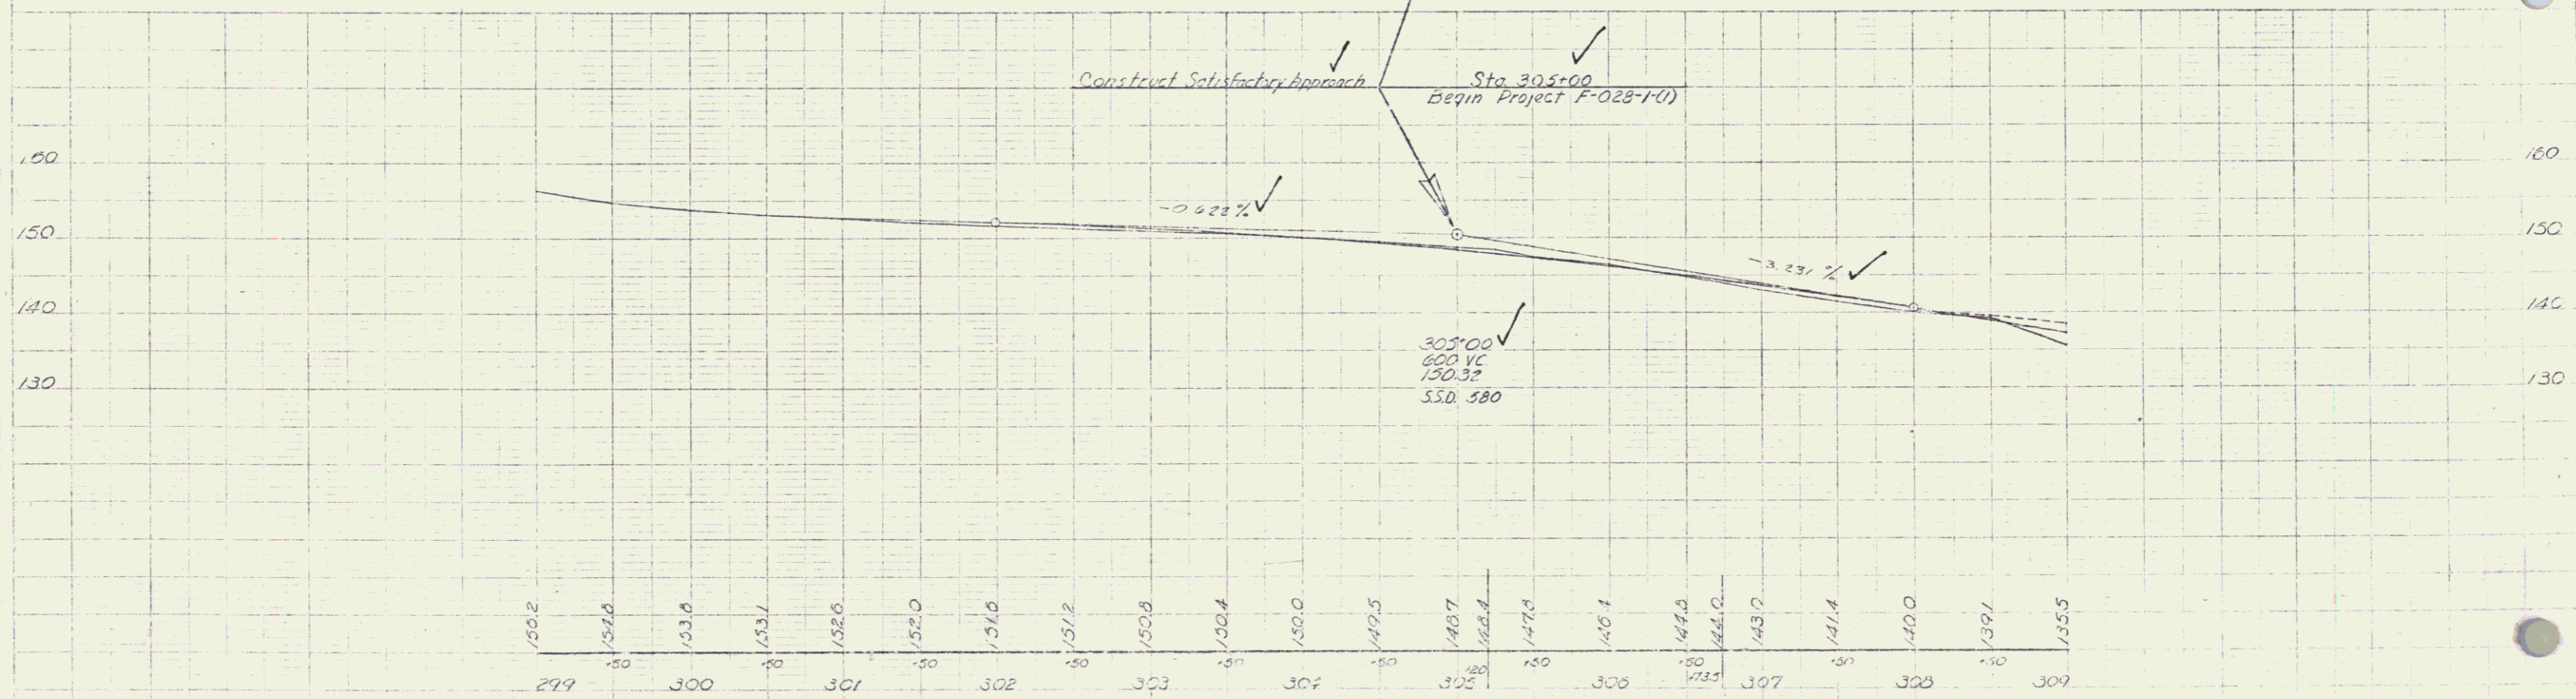


Removal & Disposal of Present Guard Rail
 306+60 to 306+82 Rt. 21'
 306+78 to 308+60 Lt. 182'
 308+60 to 309+00 Rt. 40'

Three Cable Guard Rail
 with Steel Posts 11mm 343
 5 ft. Anchors
 306+35-309+00 Lt. ✓

Construct Drive
 305+20 Rt. ✓

STATE OF VERMONT

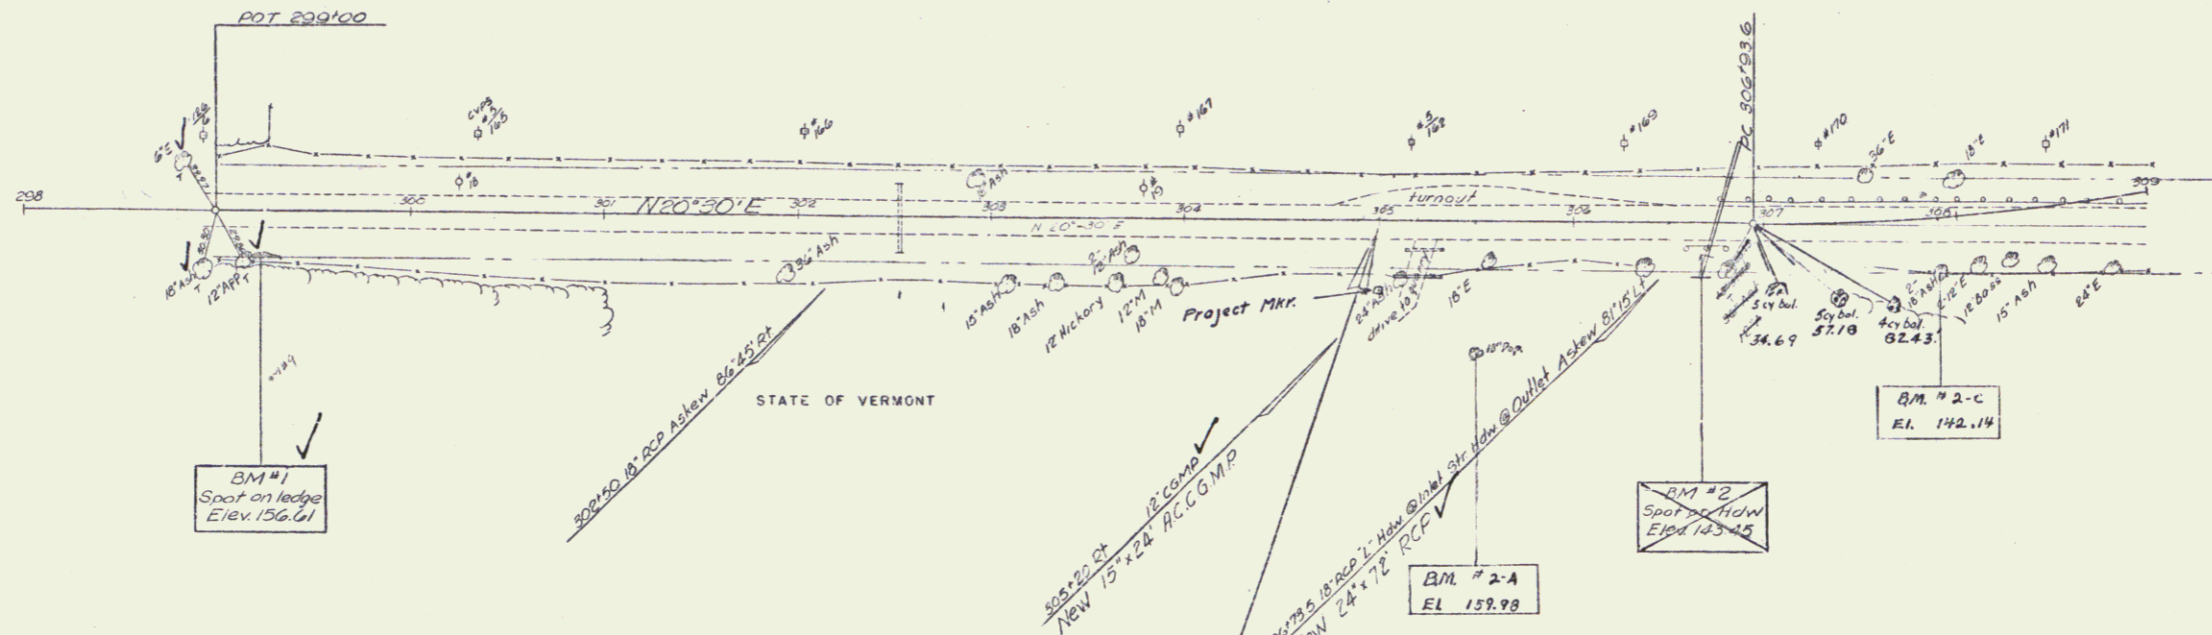

BM #1 Spot on ledge 77' Rt Sta 299+22 Elev. 152.01
 BM #2 Spot on Conc Hdwr 77' Rt Sta 306+67 Elev. 143.45

BM #2-A S.I.E. 18" Pop. 10 Rt. Sta 305+50 El. 152.90
 BM #2-C S.I.E. 36" Bul. Mt. 30 Rt. Sta. 307+90 El. 142.17

MILTON-SOUTH HERO
 SAND BAR BRIDGE
 Proj. F-028-1(1)
 Sheet 2 of 10

JUL - 8 1974 2