

Removal & Disposal of Present
 Guard Rail Item 550
 306+00 - 306+82 Rt
 306+78 - 303+60 Lt
 306+60 - 312+85 Rt
 312+60 - 312+85 Rt

Construct Approaches
 316+50 Rt
 319+50 Rt


Construct Drive
 320+50 Lt
 321+00
 Parking Area
 320+60 Rt

Excavation & Removal of Existing
 Cement Concrete Pavement 1.5m 120
 310+00 - 316+15 Rt
 318+25 - 319+35 Rt
 321+50 - 323+00 Rt

Plank Guard Rail Item 541-A
 310+00 Rt 24'
 316+00 Rt 24'
 319+35 Rt 24'

Three Cable Guard Rail with
 Steel Posts Item 543
 310+70
 321+20
 320+89

Bank 1' per ft
 Δ 90° 00' Lt
 Δ 5° 30' Lt
 T 1145.0'
 L 1800.0'
 E 474.6'

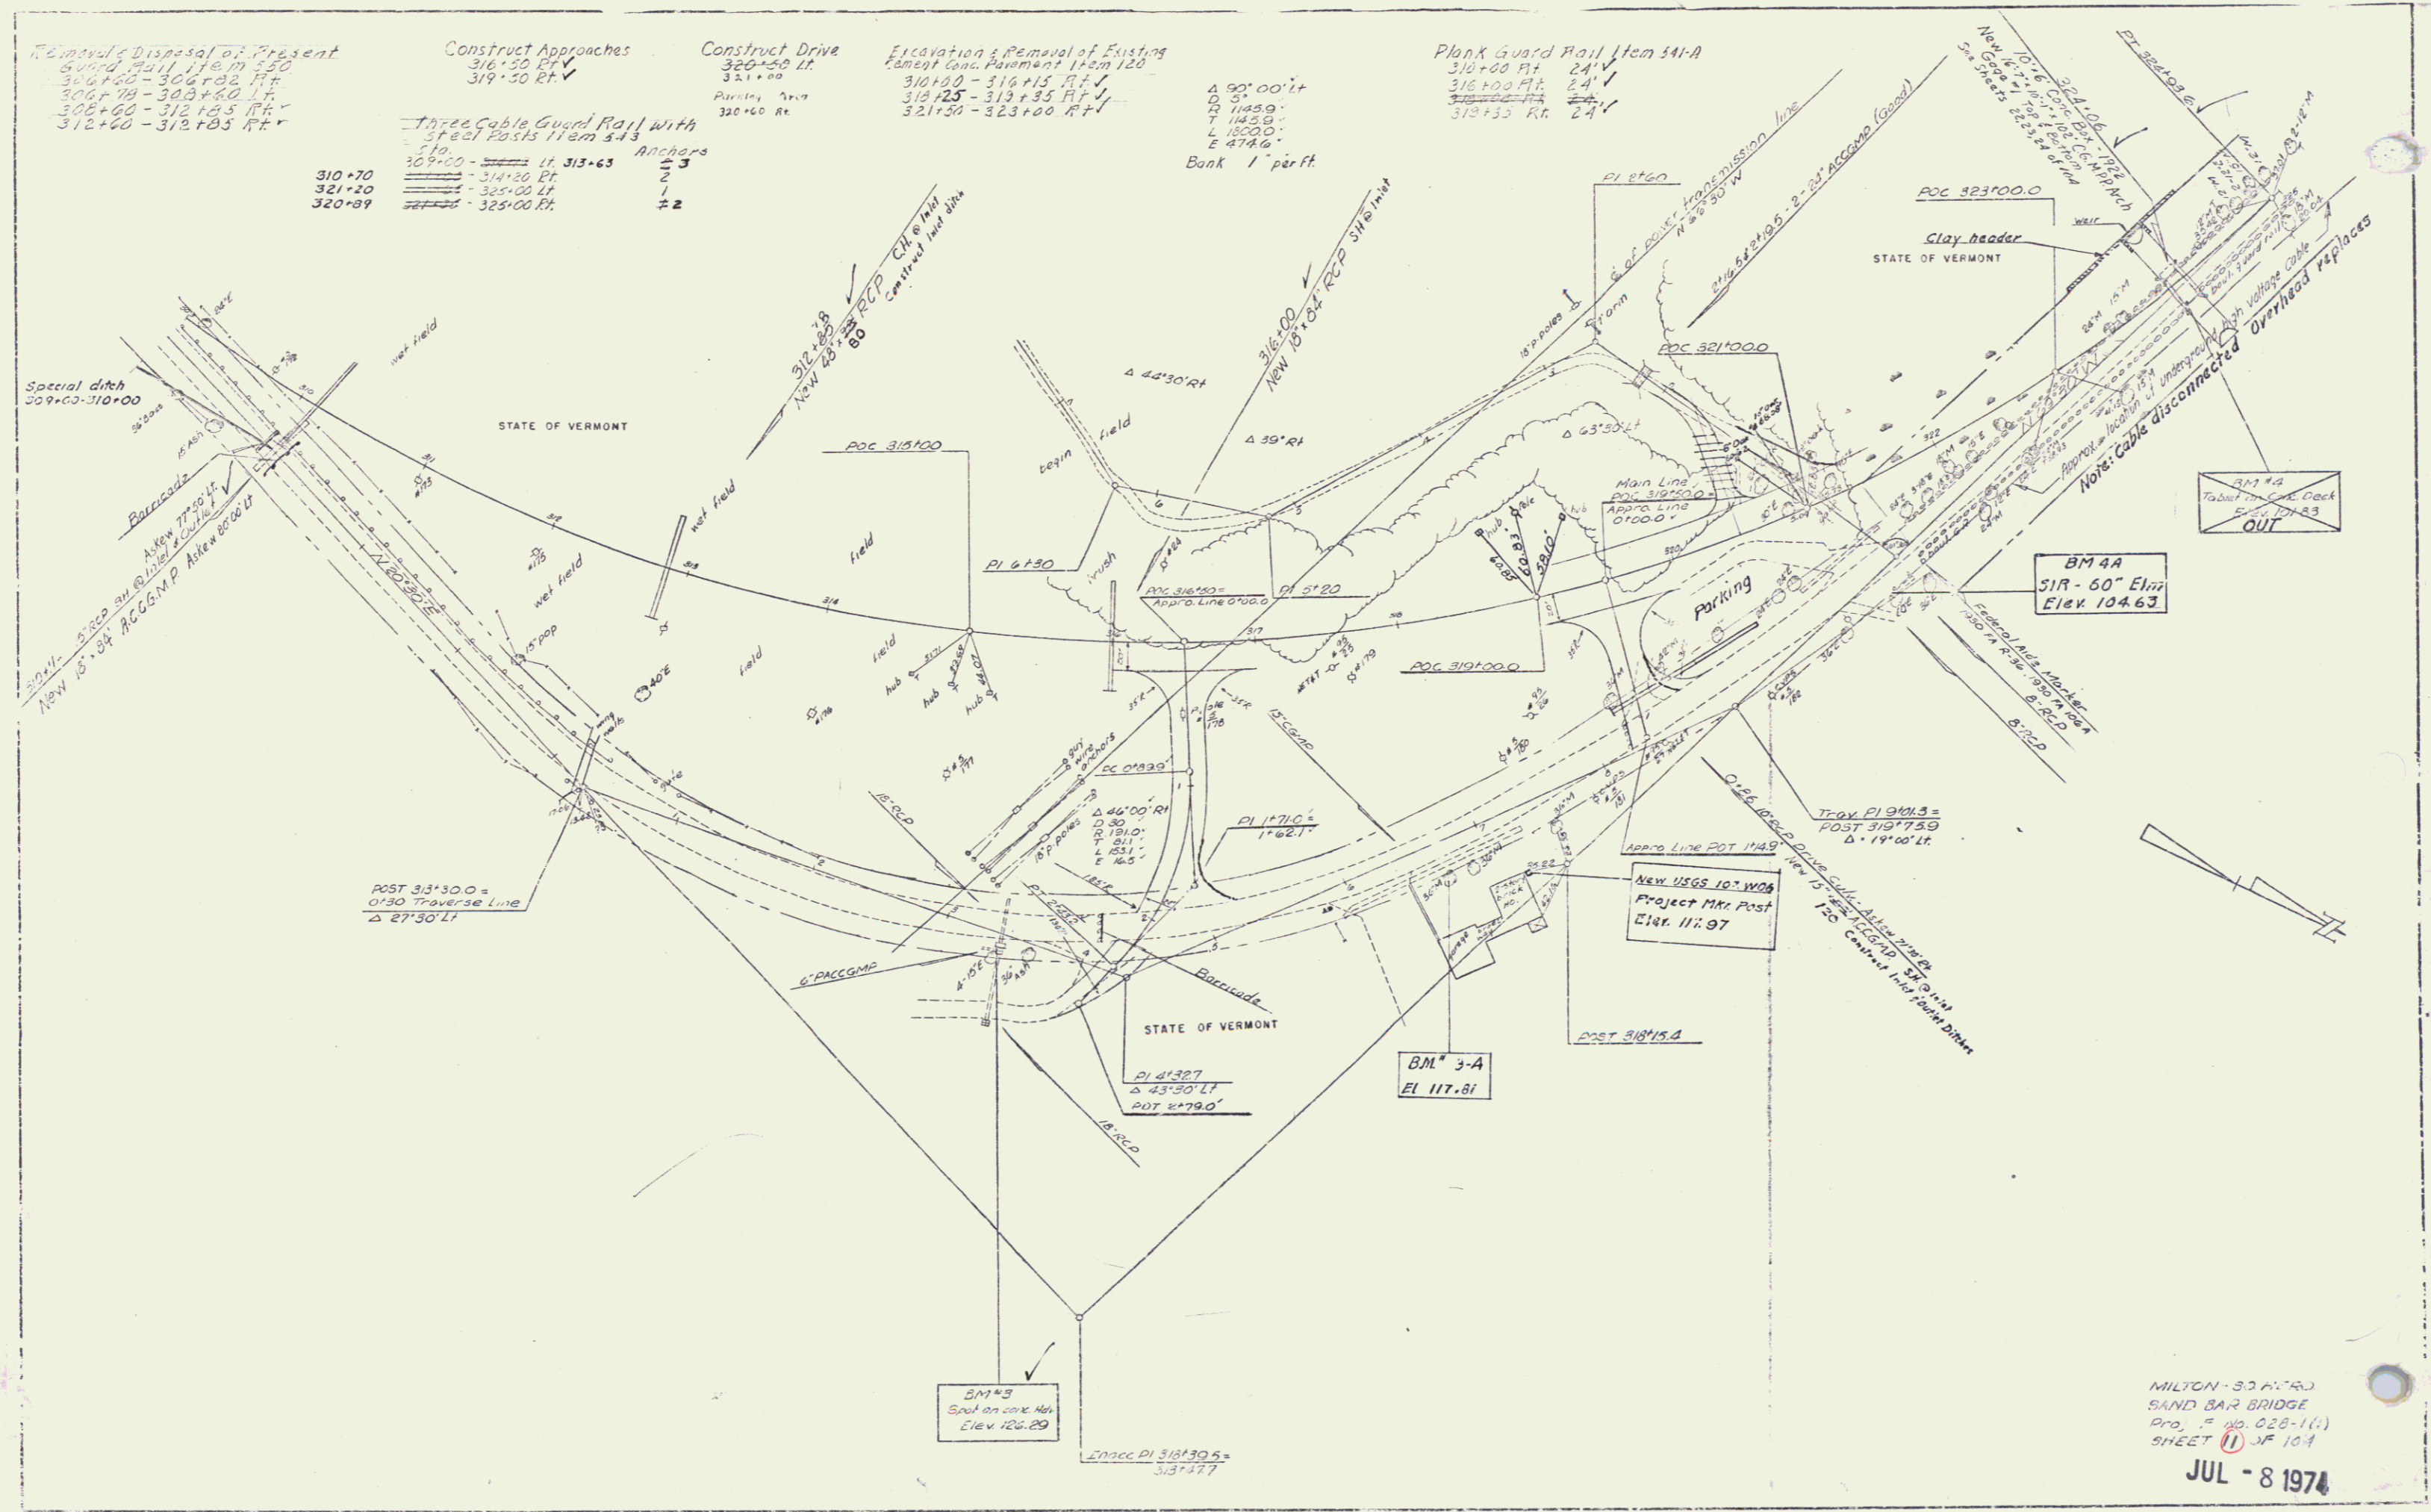

MILTON - S.D.A.R.J.
 SAND BAR BRIDGE
 Proj. No. 028-1(1)
 SHEET 1 OF 104
 JUL - 8 1974

3