


Three Cable Guard Post with Steel Posts - Item 543		
		Anchors
341+00 - 343+00	LT	1
343+36 - 347+00	LT	5
347+00 - 349+43	RT	3
349+75 - 349+00	RT	3

Project: F. 100/11/1
 Date: 8-57
 Scale: 1" = 40'
 Sheet: 1 of 104

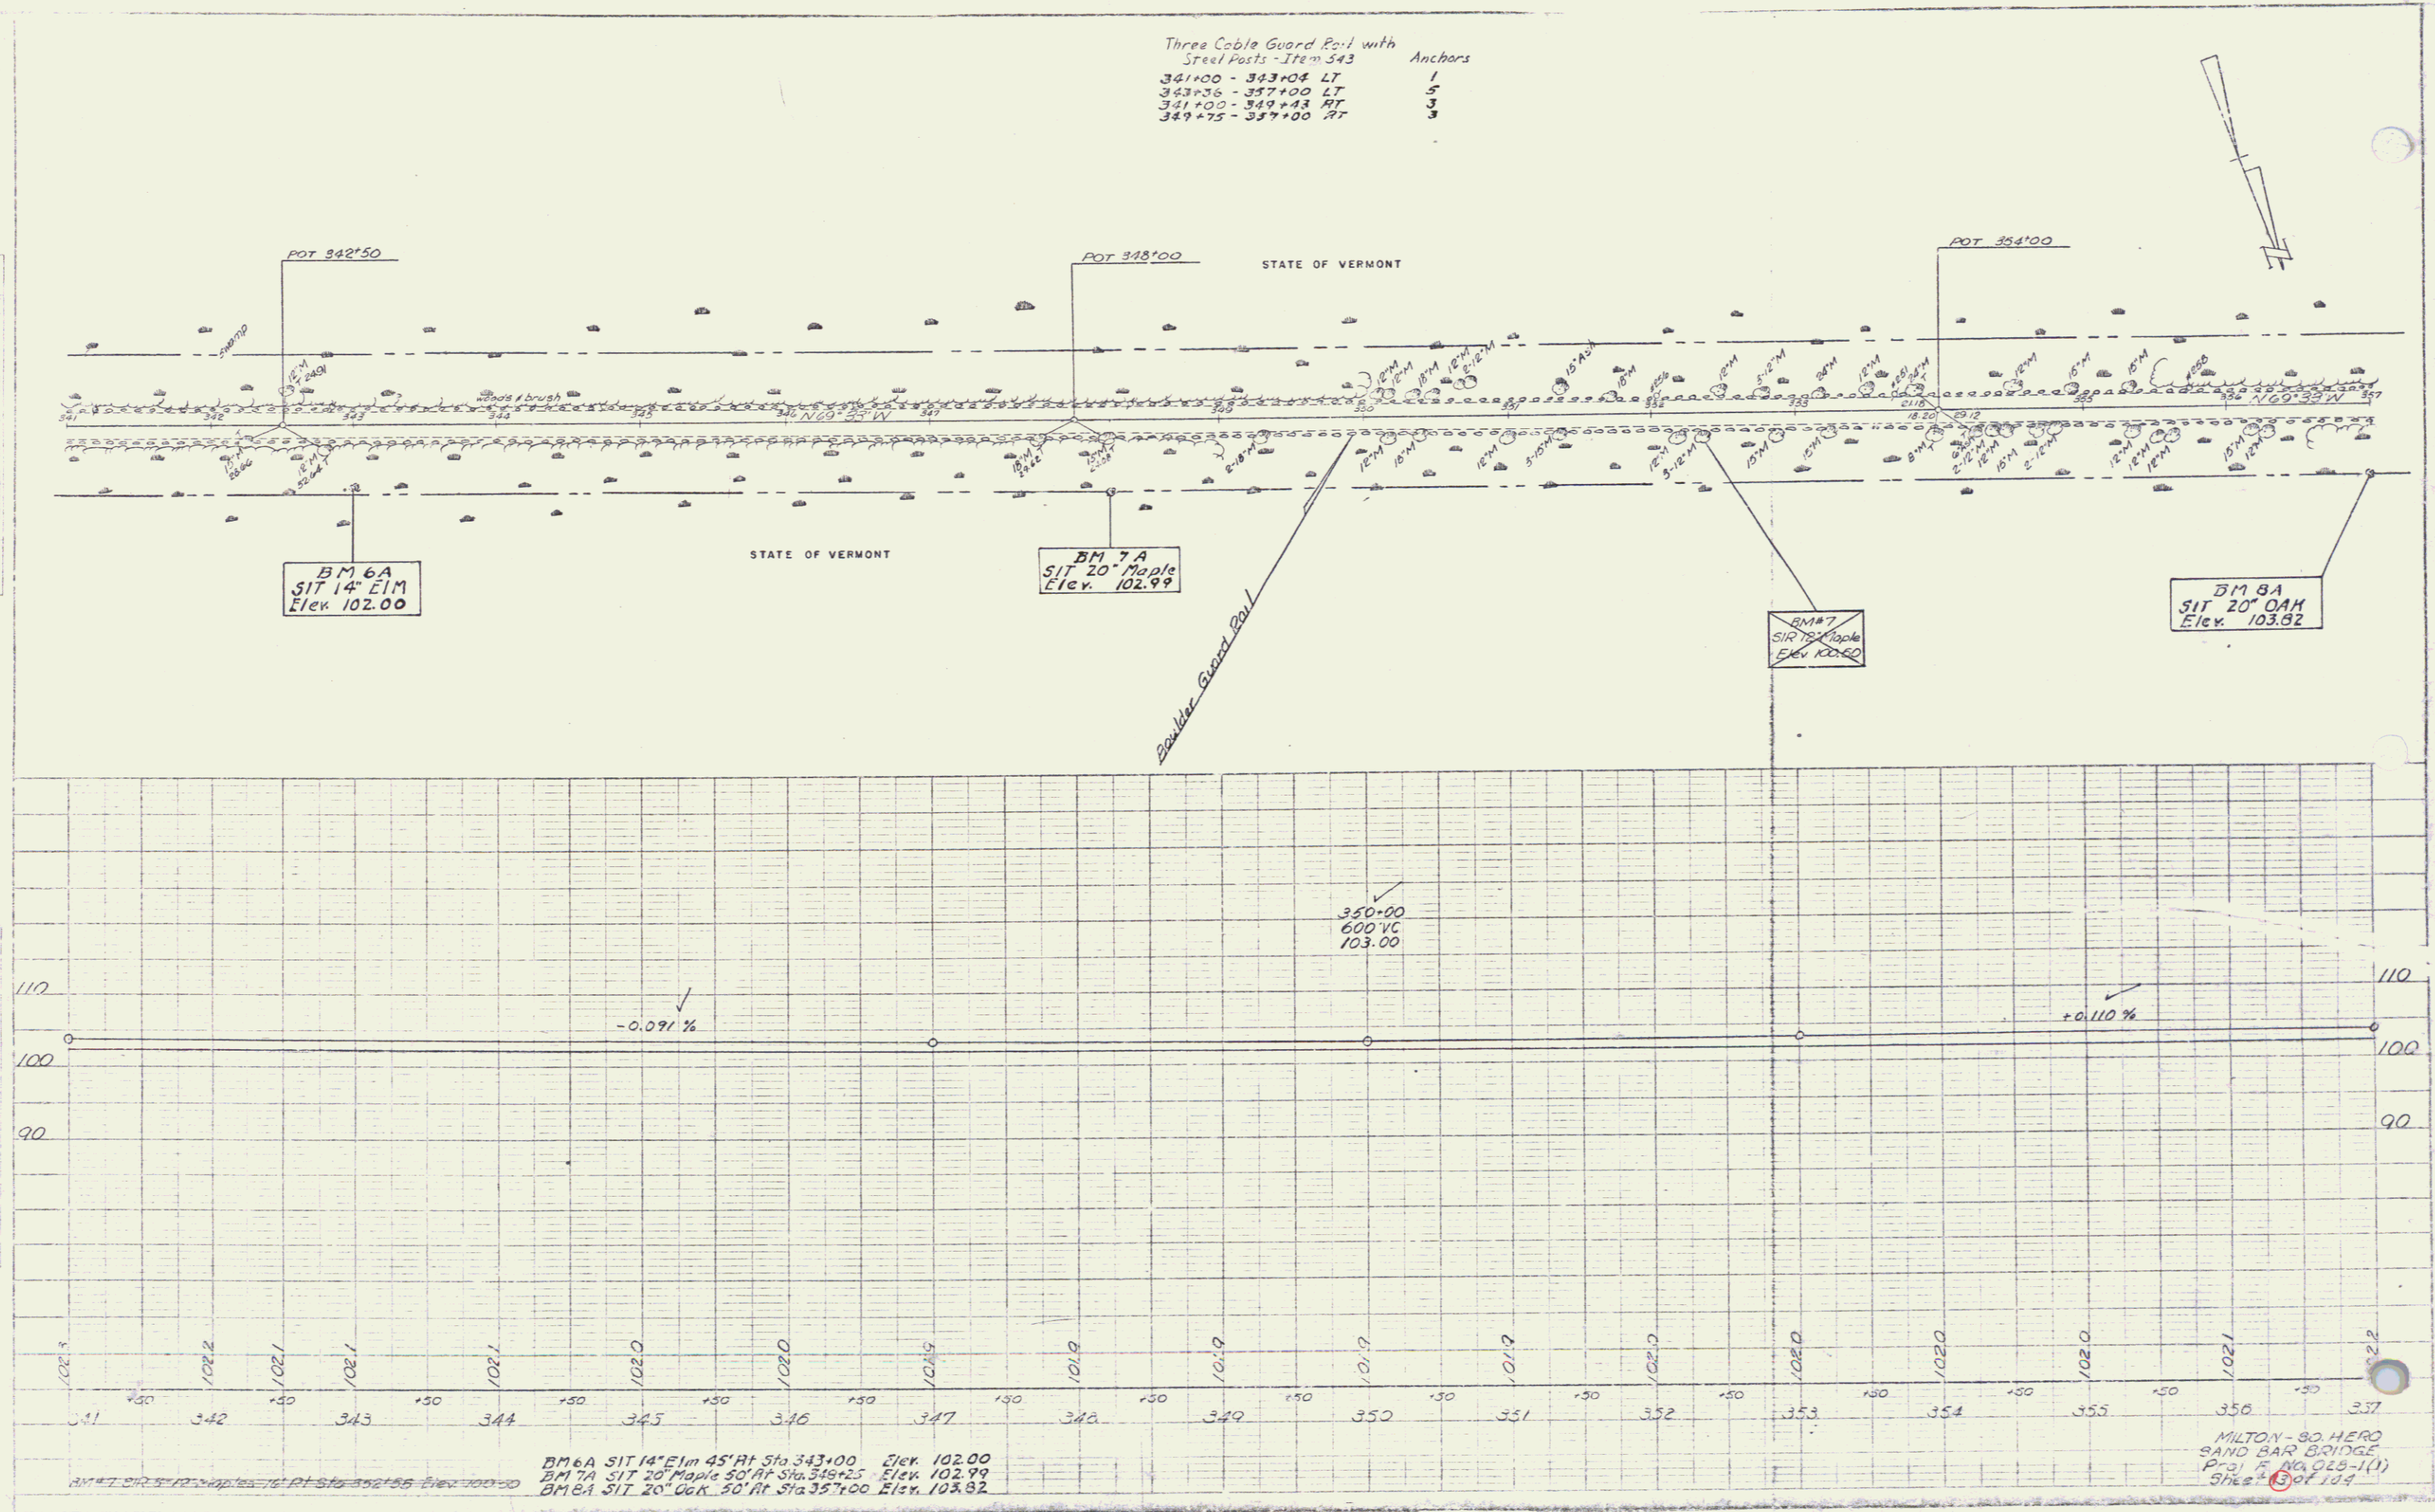

JUL '8 1974 7