
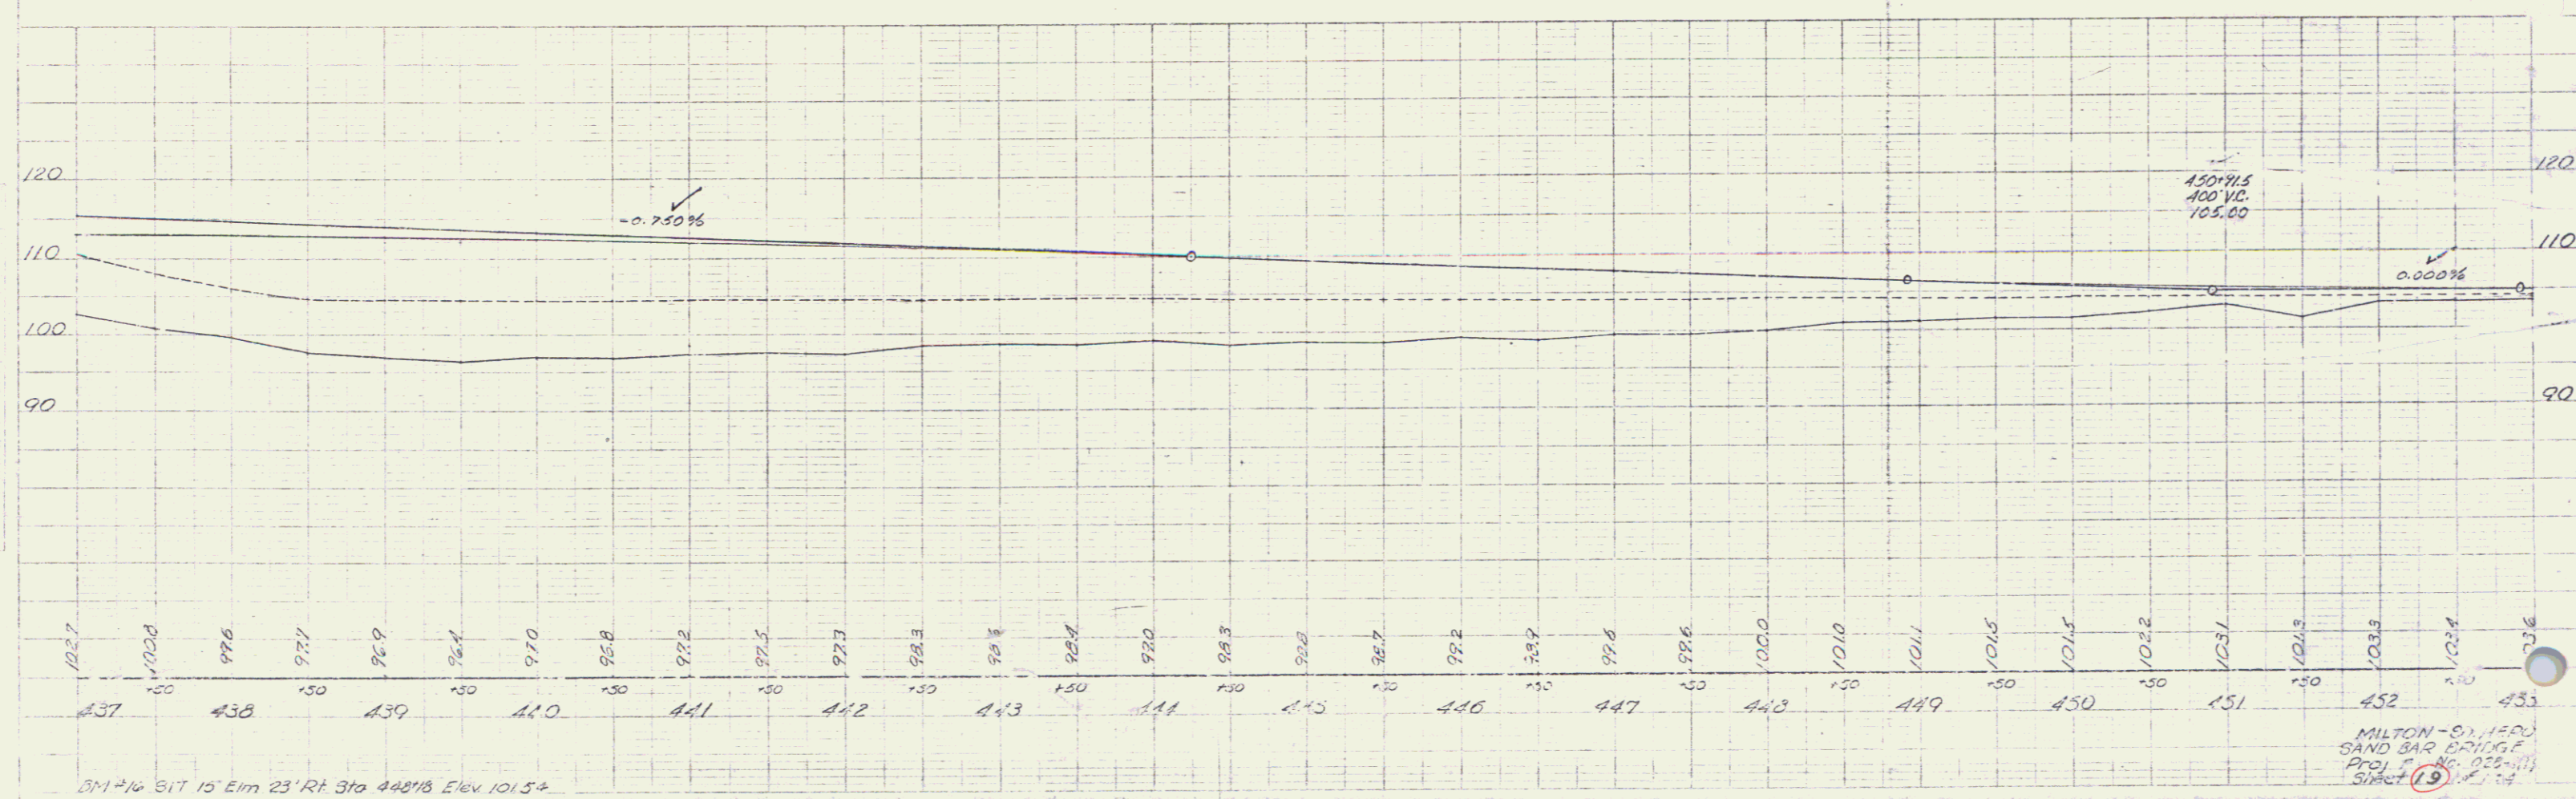


Pilecap for Bank Protection  
 120' 5.26  
 436+89.17 - 453+00 Lt ✓  
 436+89.17 - 453+00 Rt ✓

Three Cable Guard Rail with  
 Steel Posts: Item 543 Anchors  
 437+00 - 453+00 Lt ✓ 6 ✓  
 437+00 - 453+00 Rt ✓ 6 ✓

LAKE CHAMPLAIN

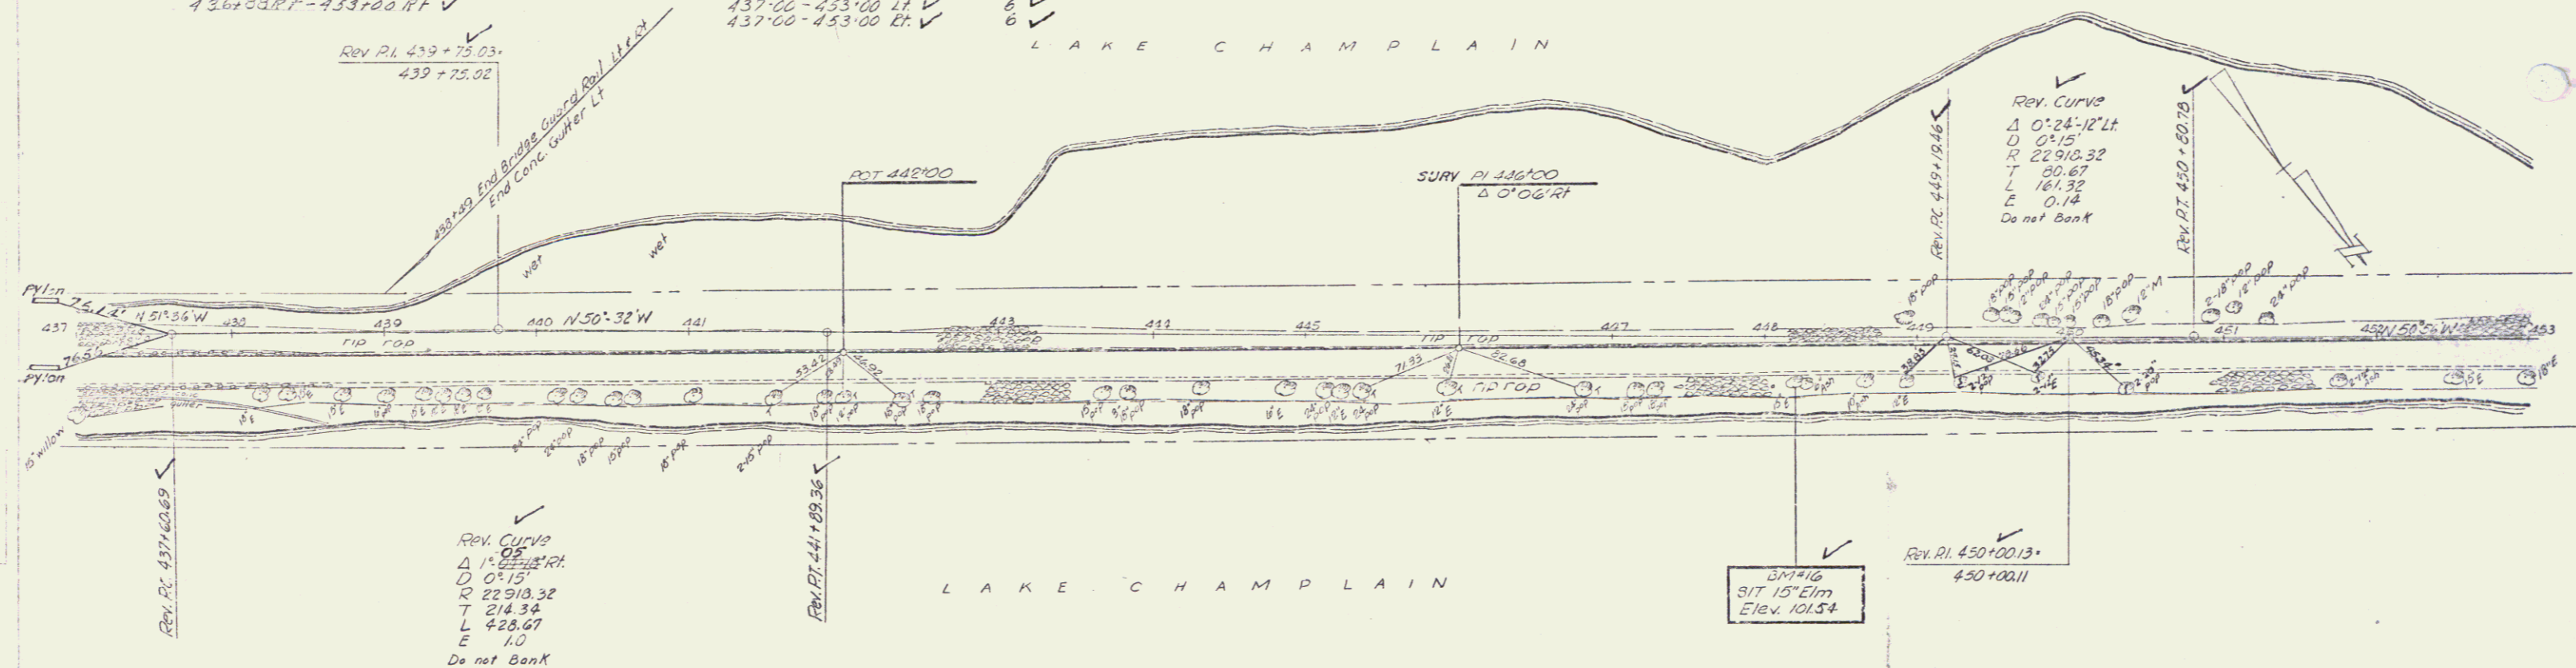

BM #16 SIT 15" Elm 23' Rt Sta 448+16 Elev. 101.54

MILTON - SAND BAR BRIDGE  
 PROJ. NO. 028-111  
 SHEET 13

JUL - 8 1974

13