

**WOOD GUARD RAIL REQUIRED**

CULVERT STATION	LEFT WIDTH	RIGHT
312+00	24'	24'

**CABLE GUARD RAIL REQUIRED**

STATIONS	LEFT	RIGHT
307+00-318+5	6.5'	

**NEW REIN. CONCRETE PIPE CULVERTS REQUIRED**

STATION	DIAM	LEN	CONC. A	REIN. STEEL	DT
316+00	18"	08'	28CY	15CY	7

**GROUTED COBBLE GUTTER REQUIRED**

STATIONS	LEN	WIDTH	LENGTH	AREA
313+00-316+30	R	3'-6"	300'	1173q Yds

**CONCRETE CRIBBING REQUIRED**


STATIONS	LEN	WIDTH	LENGTH	QUANTITY
313+00-316+30	R		300'	1343 Cu Yds

FED. ROAD DIST. NO.	STATE	FED. AID PROJ. NO.	FISCAL YEAR	SHEET NO.	TOTAL SHEETS
9	VT	106A	1930	18	65

**NEW REIN. CONCRETE BOX CULVERTS REQUIRED**

STATION	SIZE	CONC. A	REIN. STEEL
313+13	9x6	21CY	260'

Parcel	Instr.	Date	Grantor	Grantee	Recorded Bk.	Milton Vg.	Date	Remarks
A	M.D.	4-22-30	Sanford H. & Sadie M. Thompson	State of Vt.	2b	21-21	4-22-30	

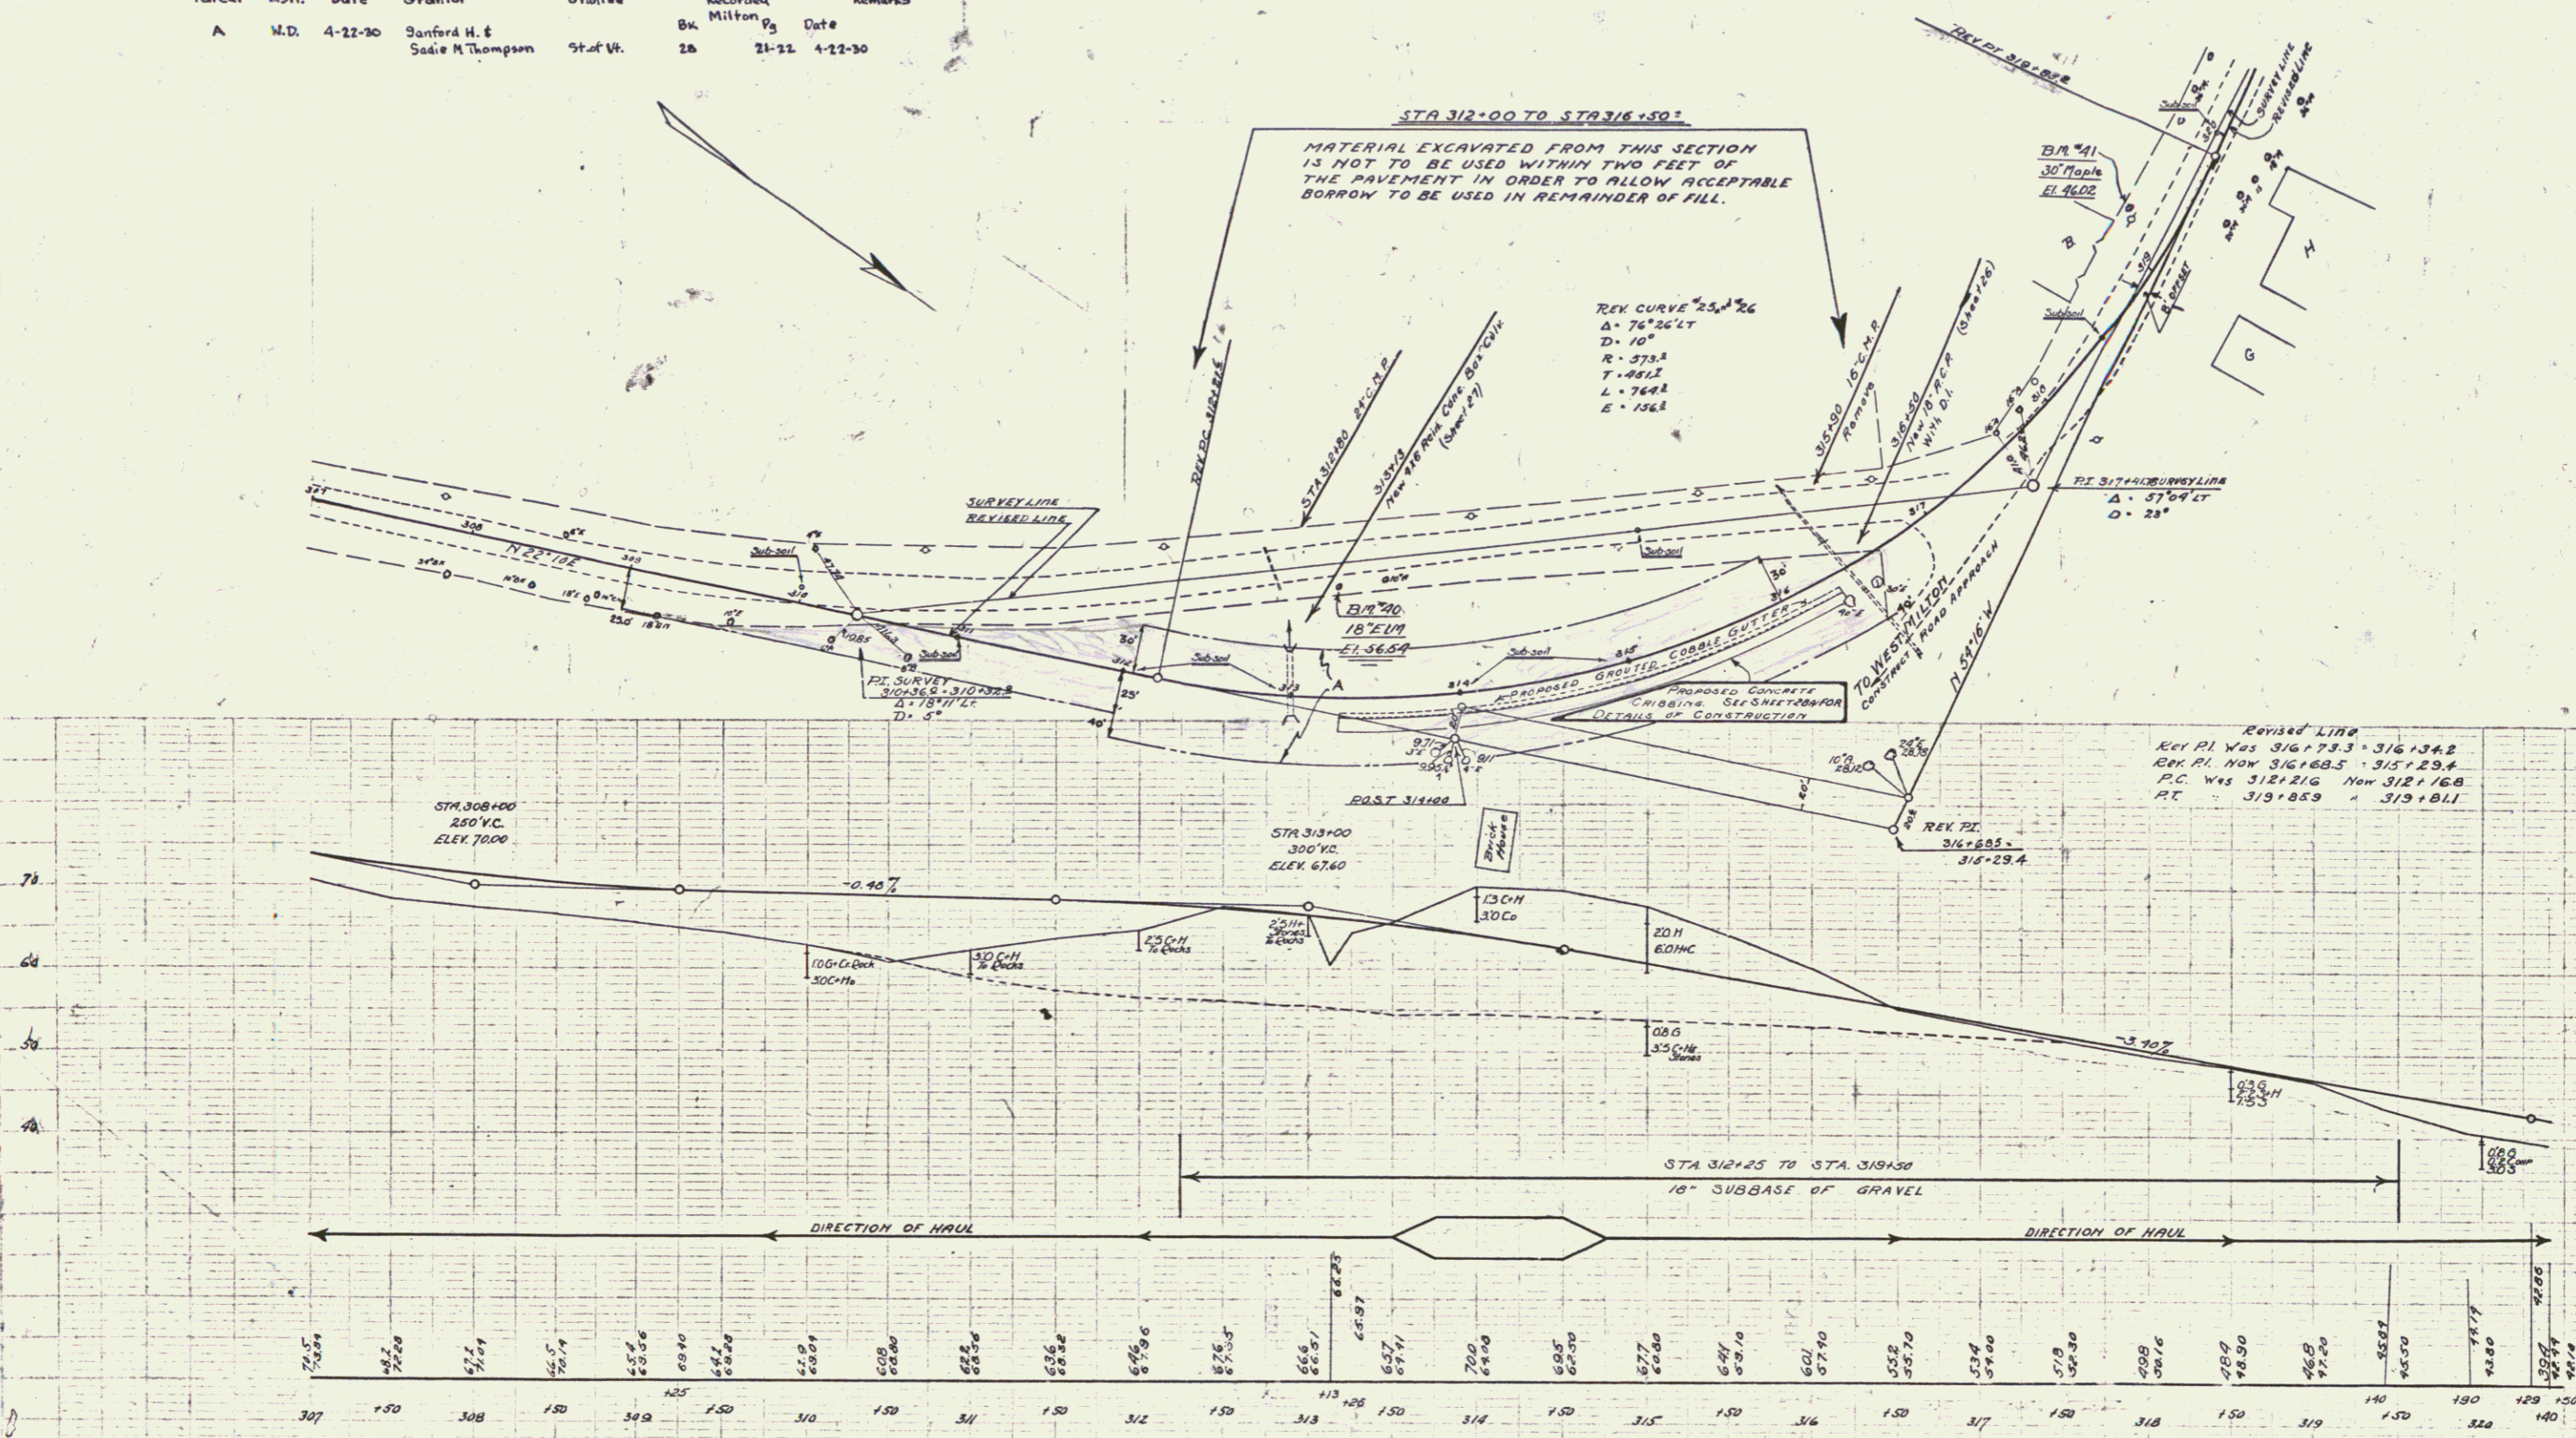

Revised LINE  
 Key PI was 316+79.3 + 316+134.8  
 Key PI Now 316+85 + 316+29.4  
 P.C. was 312+216 Now 312+168  
 P.T. 319+853 + 319+811

B.M. 110.70 spike in root of 18\" E1m 17\" 11\" STA 313+00 Elev. 56.54  
 B.M. 110.91 spike in root of soft maple 27\" 11\" STA 318+02 Elev. 46.02

SERIES F 110.000  
 SHEET 18 OF 65