
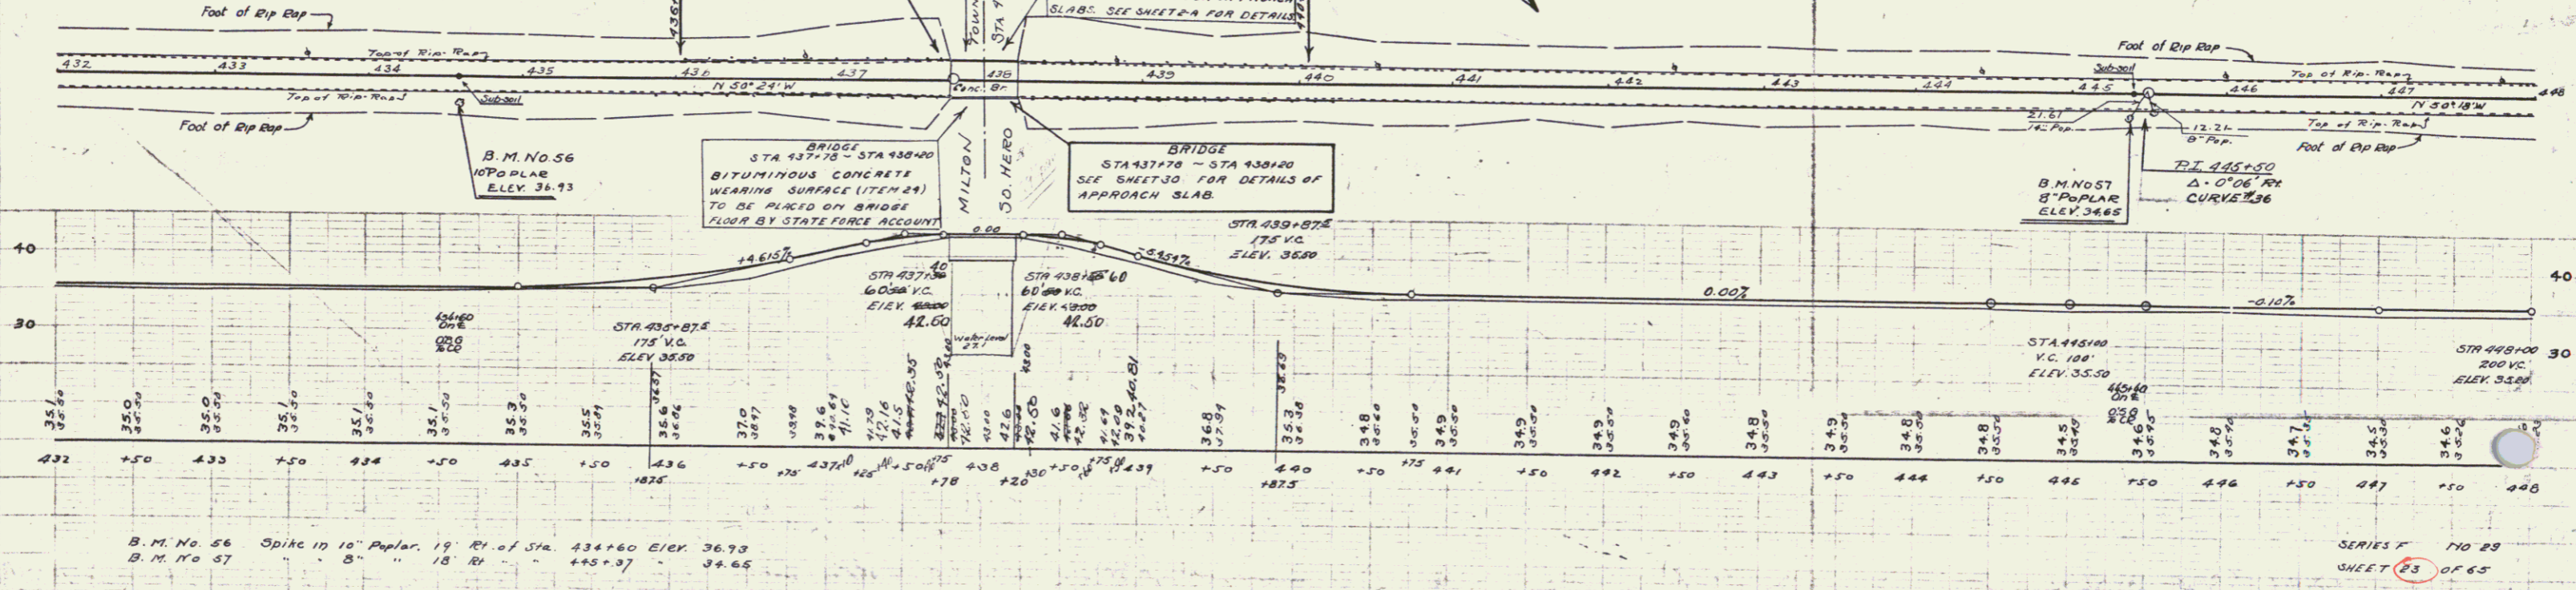


B.M. No. 54 Spike 10' Poplar 13' RI. of Sta. 417+80 ELEV. 37.12
 B.M. No. 55 " " " 18' " " 426+04 " " 35.63

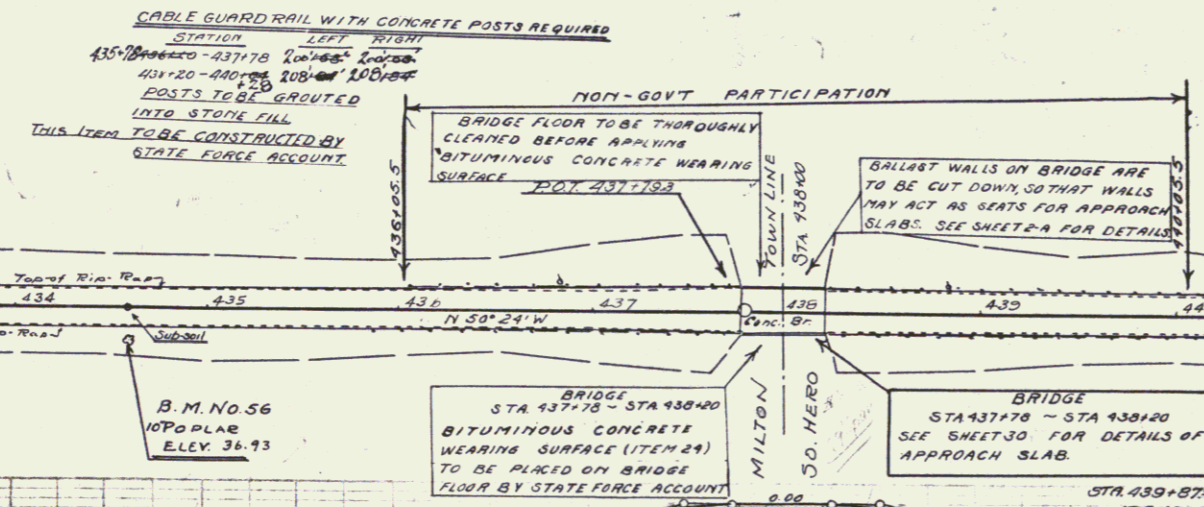

B.M. No. 56 Spike 10' Poplar 19' RI. of Sta. 437+60 ELEV. 36.73
 B.M. No. 57 " " " 8' " " 445+37 " " 34.65