



NEW CABLE GUARD RAIL REQUIRED
 STA 11+00 TO STA 11+50 LENGTH 50' 0"
 15' 0" 15' 0"

NEW WOOD GUARD RAIL REQUIRED
 STA 11+50 TO STA 12+00 LENGTH 50' 0"
 15' 0" 15' 0"

TILE UNDERDRAIN REQUIRED
 STA 11+27 LENGTH 20 FEET

NEW CULVERTS REQUIRED
 STA 11+27 TO STA 11+50 LENGTH 23' 0"
 12' 0" 11' 0"

4 91

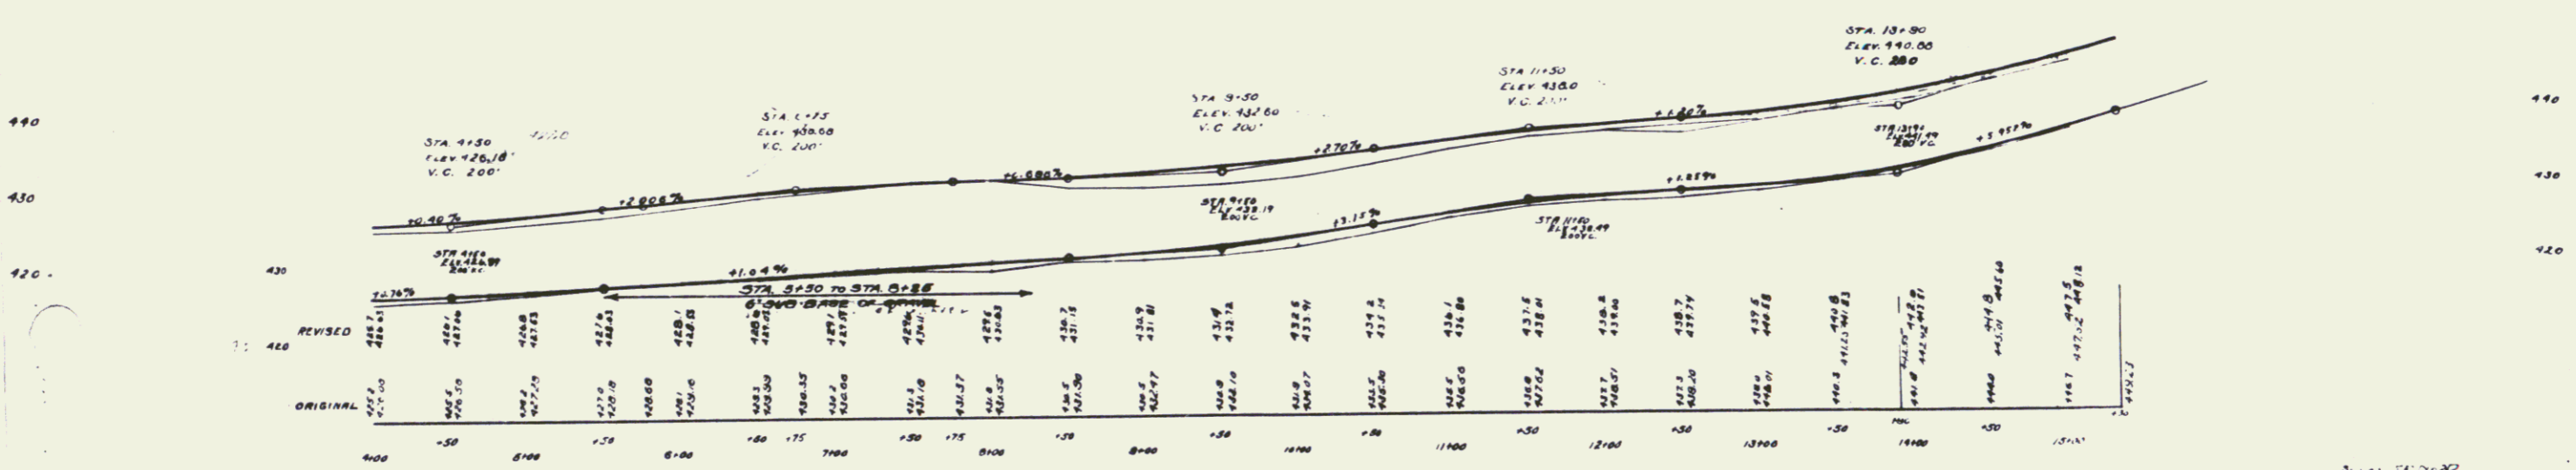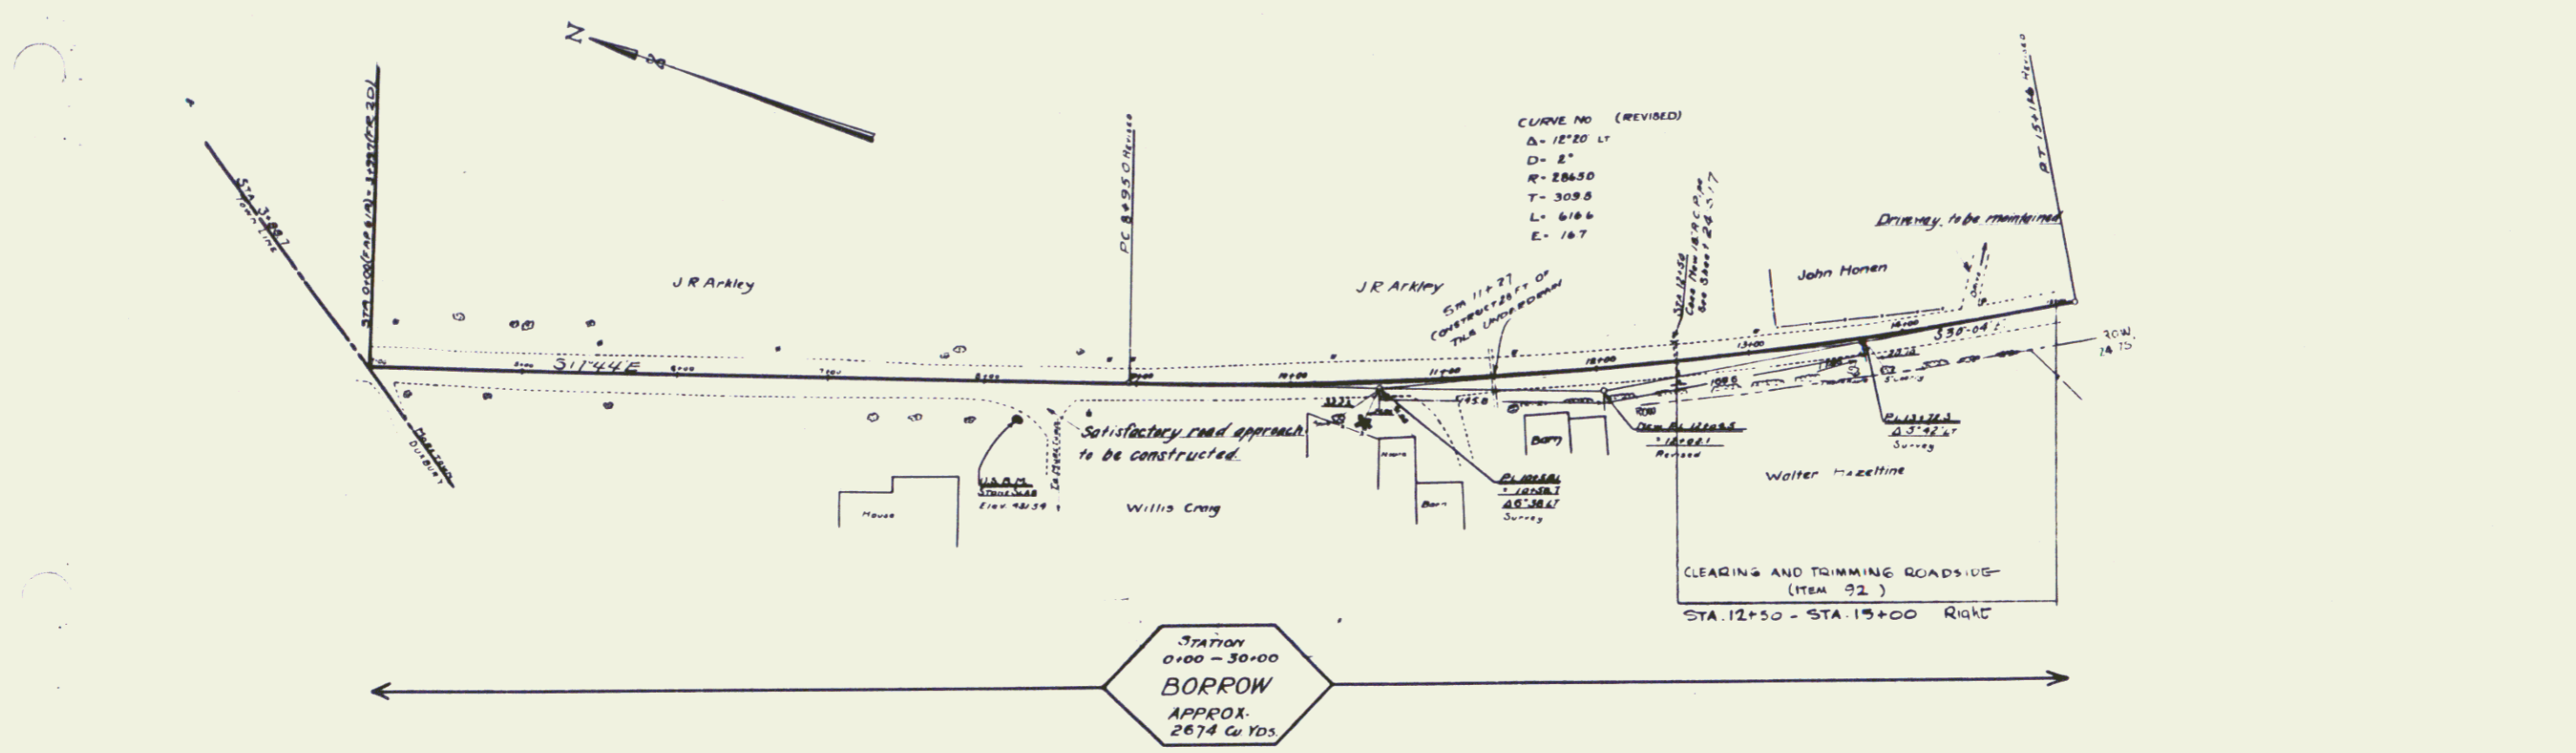

U.S. R.T. 310 & 312A Point Mass on Curve Sta 11+27 Elev 431.59

4