
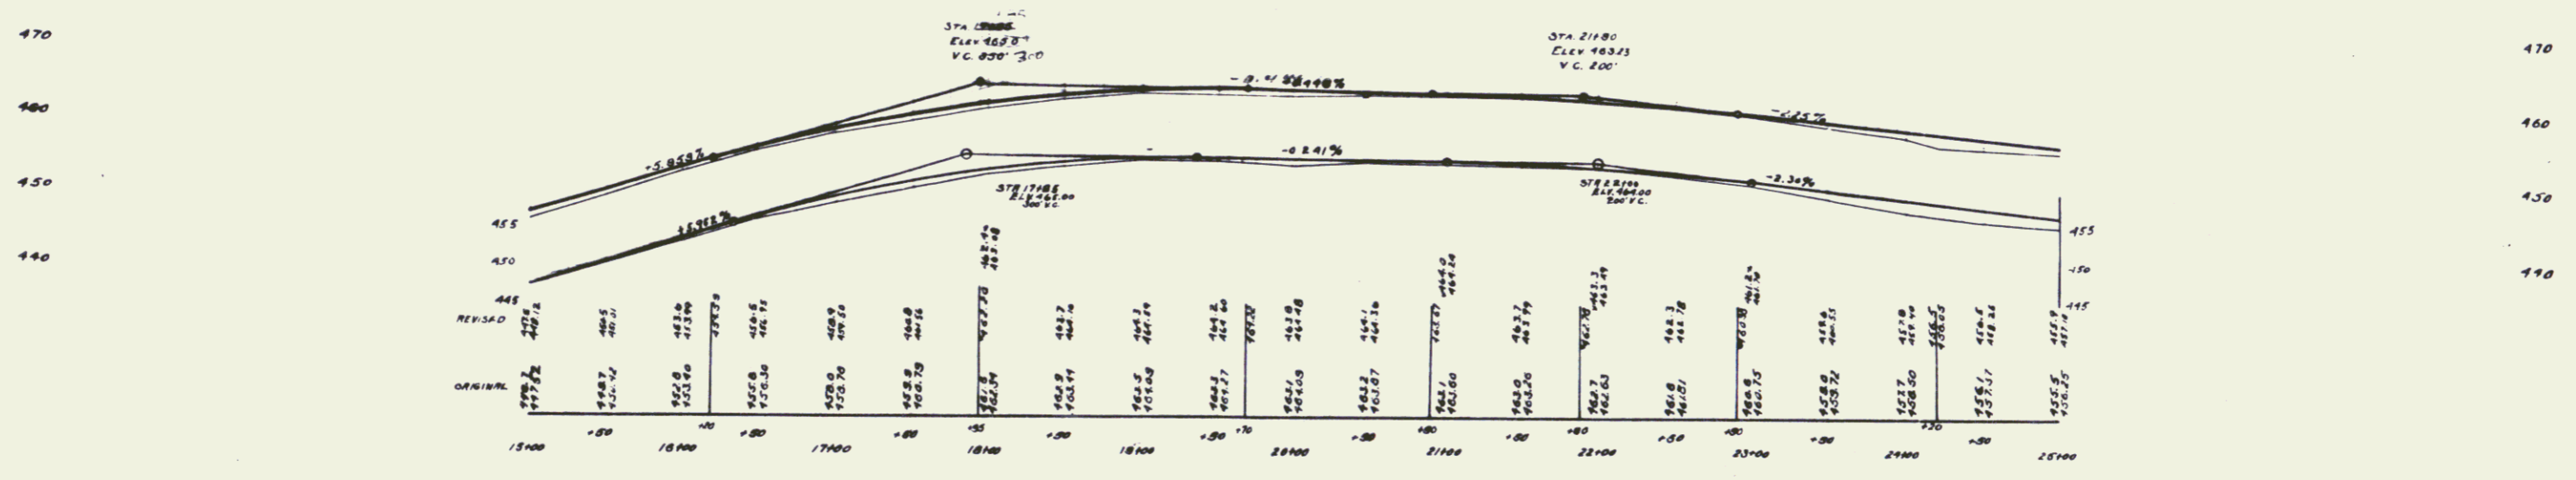


NEW CABLE GUARD RAIL REQUIRED  
 - ON L&P -  
 STA 15100 TO STA 15400 LENGTH 300 L.V.F.F.

NEW WOOD GUARD RAIL REQUIRED  
 - ON R&P -  
 STA 20000 TO STA 20500 LENGTH 500 L.V.F.F.  
 STA 20500 TO STA 20700 LENGTH 200 L.V.F.F.  
 TOTAL FOR SHEET 700 L.V.F.F.

NEW CULVERTS REQUIRED  
 STA 21100 15" Reinforced Concrete Pipe Length 165 FT  
 Concrete Class B (U-29-3)  
 Reinforcing Steel 3.00 Cu Yds  
 33.00 cu

DATE: 11-21-1928  
 SHEET: 5 OF 7

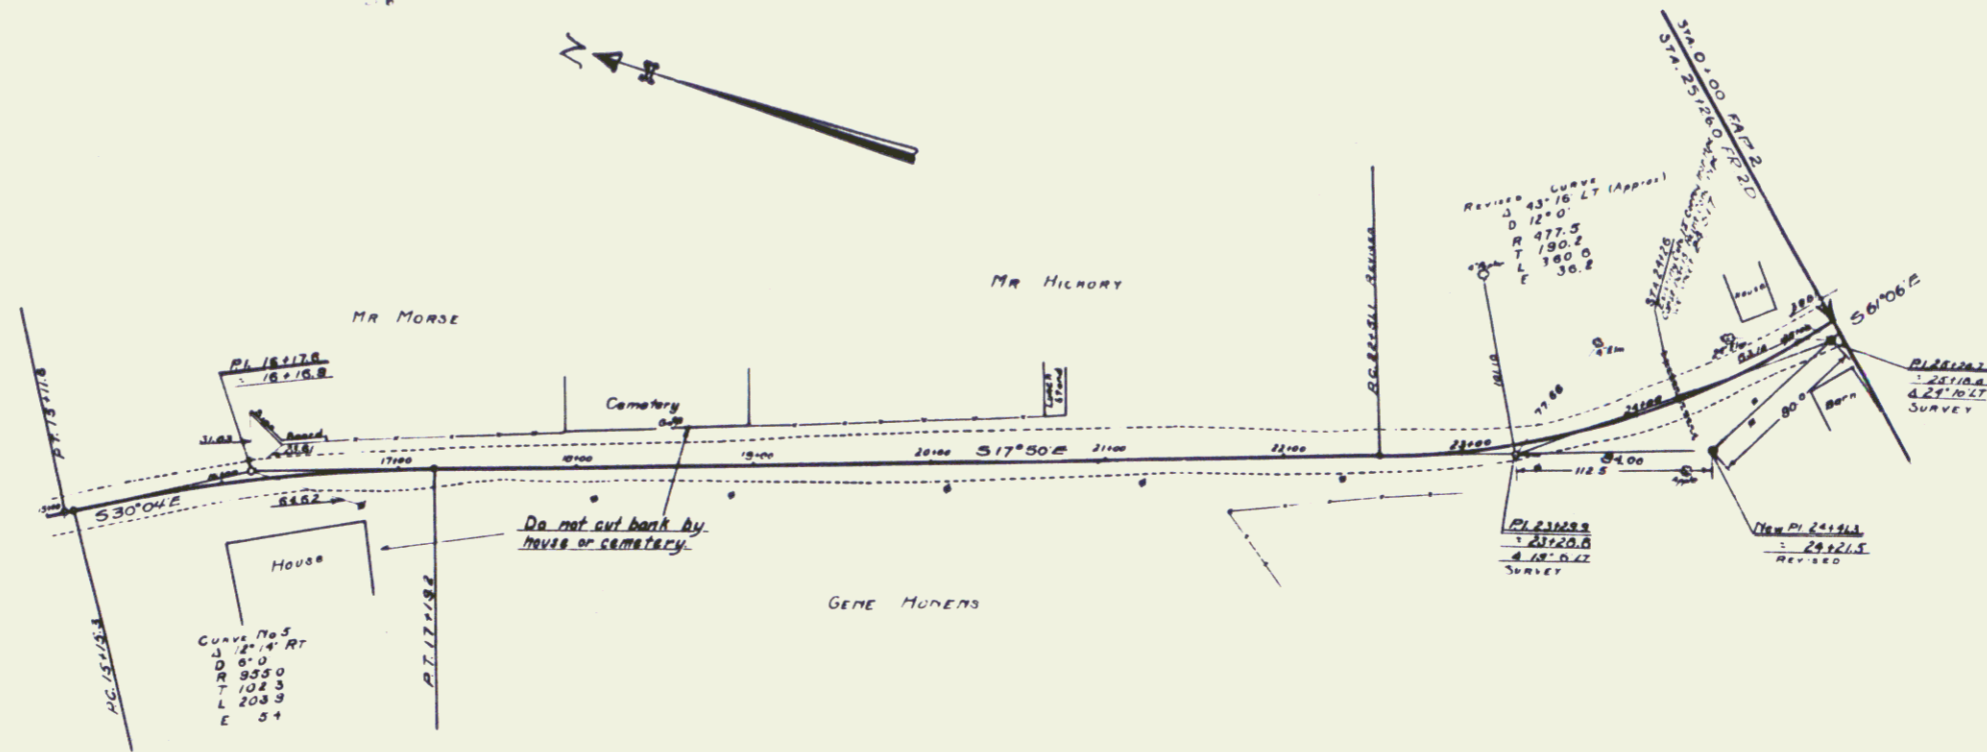

DATE: 11-21-1928  
 SHEET: 5 OF 7

4