

NEW CABLE GUARD RAIL REQUIRED

STA 29+00 TO STA 30+00 LENGTH 100 LF
 STA 30+00 TO STA 36+75 LENGTH 66 75 LF
 STA 36+75 TO STA 38+75 LENGTH 20 LF
 TOTAL FOR SHEET 186 75 LF

NEW WOOD GUARD RAIL REQUIRED



STA 27+00 TO STA 28+75 LENGTH 175 LF
 STA 28+75 TO STA 31+75 LENGTH 300 LF
 STA 31+75 TO STA 33+00 LENGTH 125 LF
 STA 33+00 TO STA 34+00 LENGTH 100 LF
 STA 34+00 TO STA 35+00 LENGTH 100 LF
 TOTAL FOR SHEET 600 LF

NEW CULVERTS REQUIRED

STA 25+85 6" Reinforced Concrete Pipe Length 44 FT
 Concrete Class A (12" R) 34.100 Yds
 Reinforcing Steel 34.100 Yds
 STA 30+60 8" Reinforced Concrete Pipe Length 100 FT
 Concrete Class A (12" R) 84.000 Yds
 Reinforcing Steel 84.000 Yds

CULVERT REPAIRS REQUIRED

STA 36+75 Present 36" Box in good condition
 Concrete Class A (12" R) 7.000 Yds
 Reinforcing Steel 7.000 Yds
 Existing 42" Box in good condition
 Concrete Class A (12" R) 4.200 Yds
 Reinforcing Steel 4.200 Yds

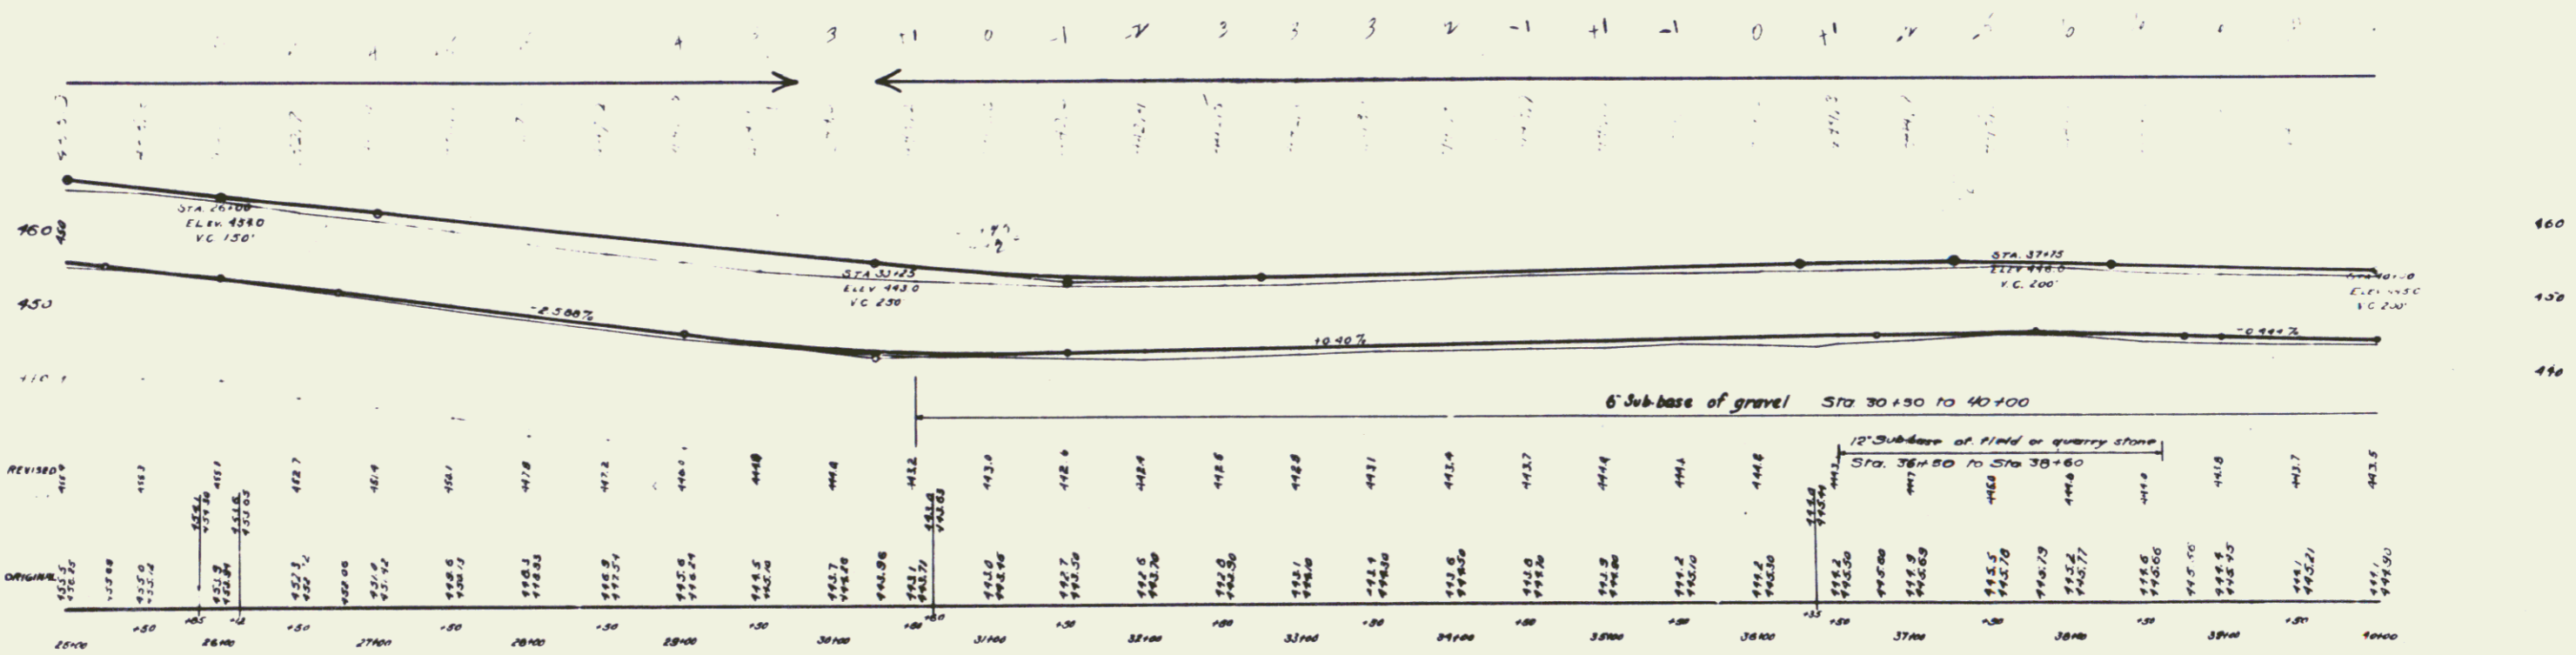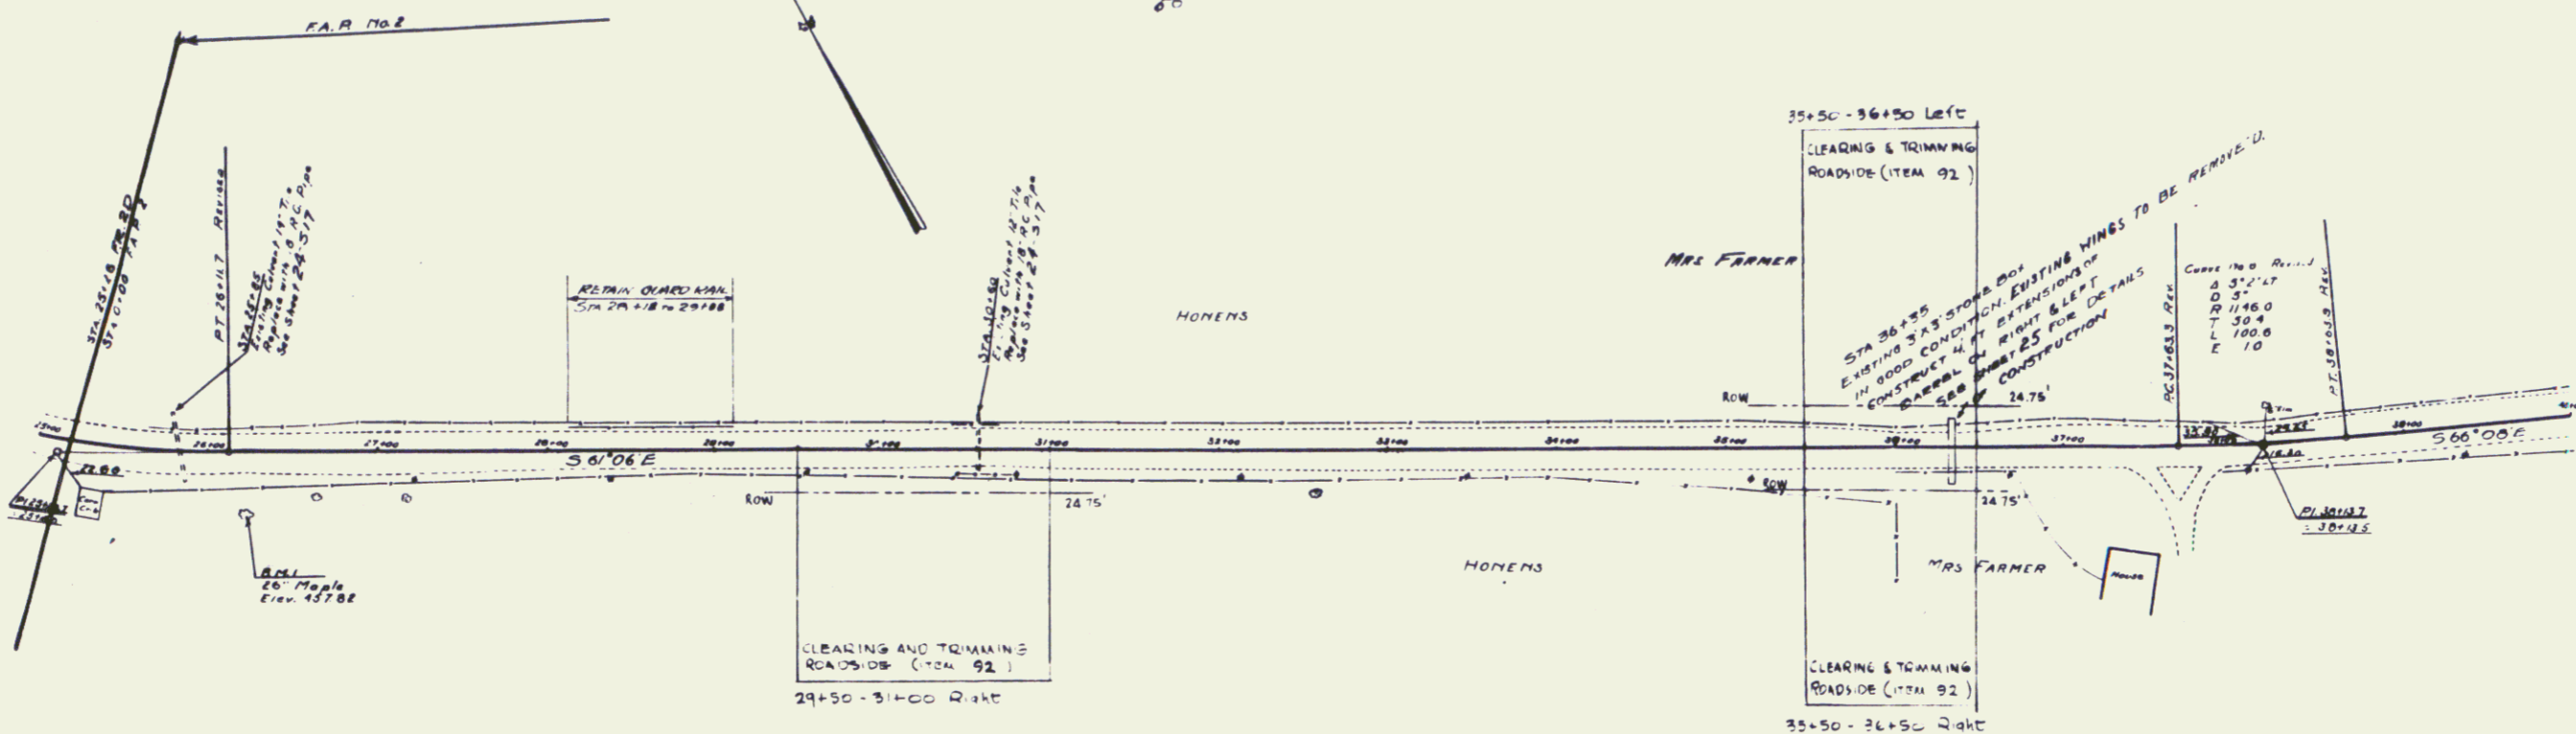

B.M. Spike in 2nd Map Ref Sta 20+00 Elev 427.82

Sta 25+00 to 40+00
 6-01

5