

NEW CABLE GUARD RAIL REQUIRED



STATION	LENGTH	REMARKS
STA 58+00 TO STA 58+95	95	2.0'
STA 58+00 TO STA 59+00	100	1.60'
TOTAL FOR BRIDGE	195	

NEW WOOD GUARD RAIL REQUIRED

STATION	LENGTH	REMARKS
STA 59+00 TO STA 59+18	18	24'
STA 59+00 TO STA 59+77	77	24'
STA 59+00 TO STA 59+77	77	24'
TOTAL FOR BRIDGE	172	

CULVERT REPAIRS REQUIRED
 STA 62+00 - 3 x 3 Stone Box Culvert
 New flow and extension of barrel
 on right side
 Concrete (Class A) 1-2-4
 Reinforcing Steel
 Repair Masonry 11-300 Sq. yds.

NEW CULVERTS REQUIRED
 STA 59+00
 18" Reinforced Concrete Pipe
 Concrete Class A (1-2-4)
 Reinforcing Steel
 STA 61+75
 18" Reinforced Concrete Pipe
 Concrete Class A (1-2-4)
 Reinforcing Steel
 STA 62+00
 18" Reinforced Concrete Pipe
 Concrete Class A (1-2-4)
 Reinforcing Steel

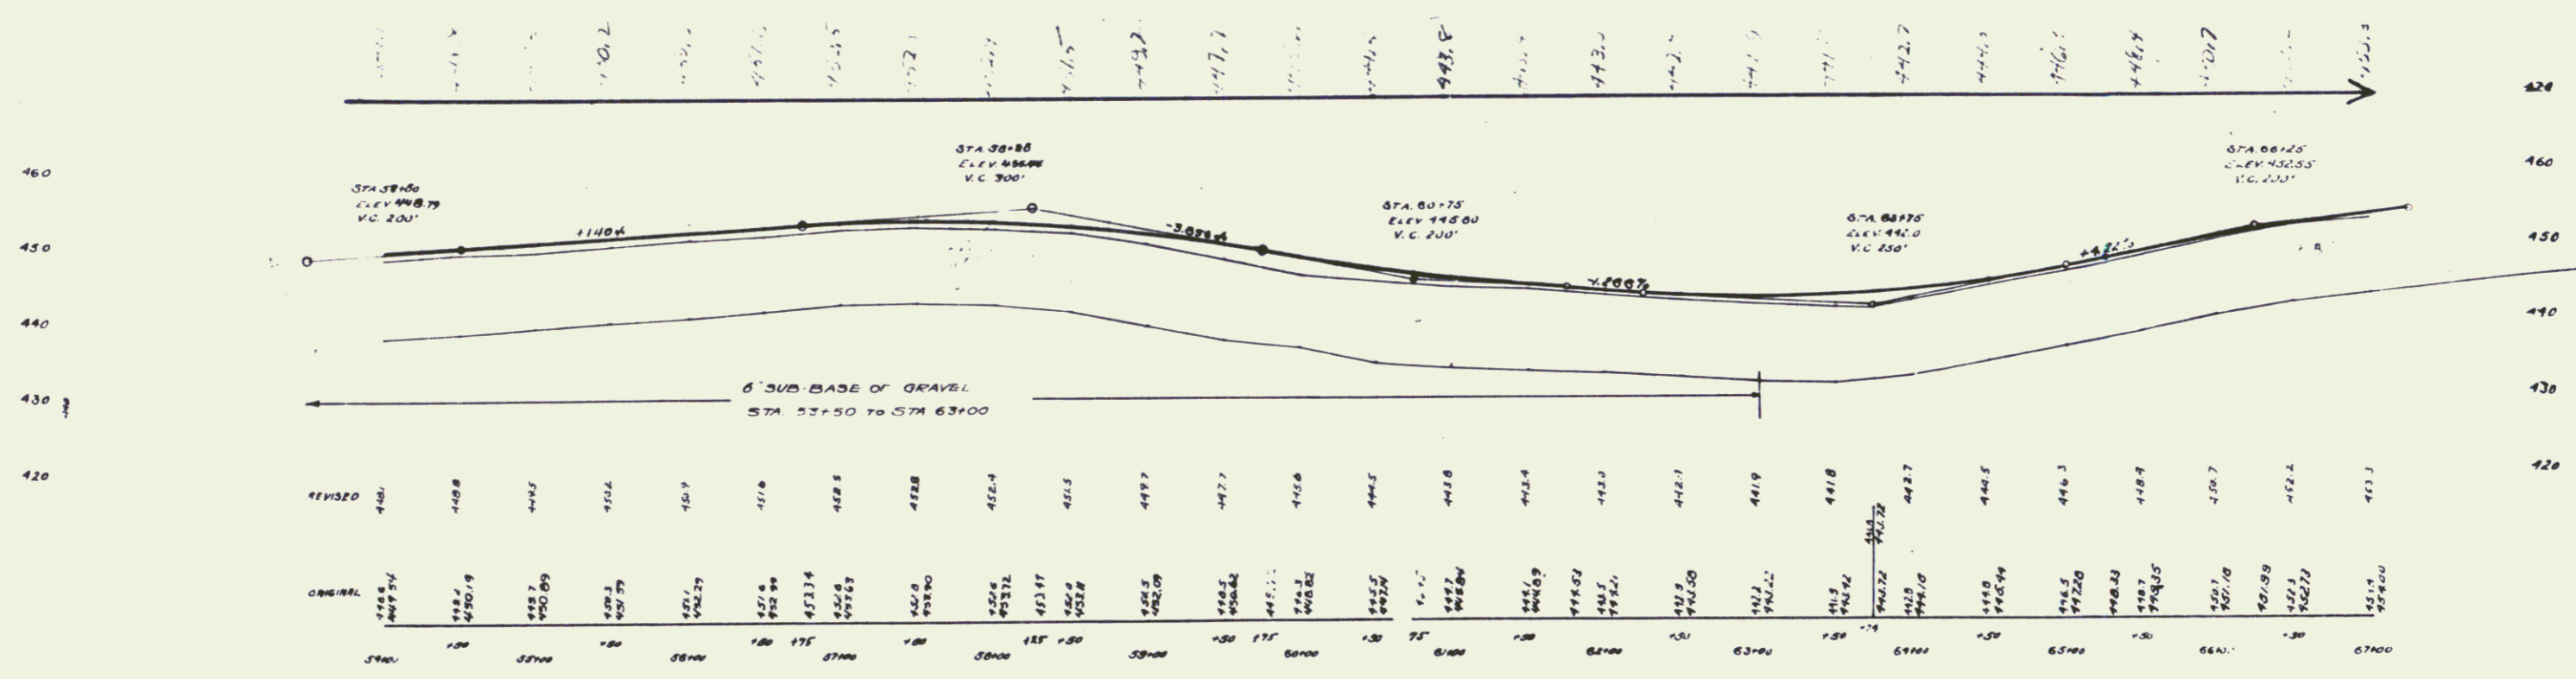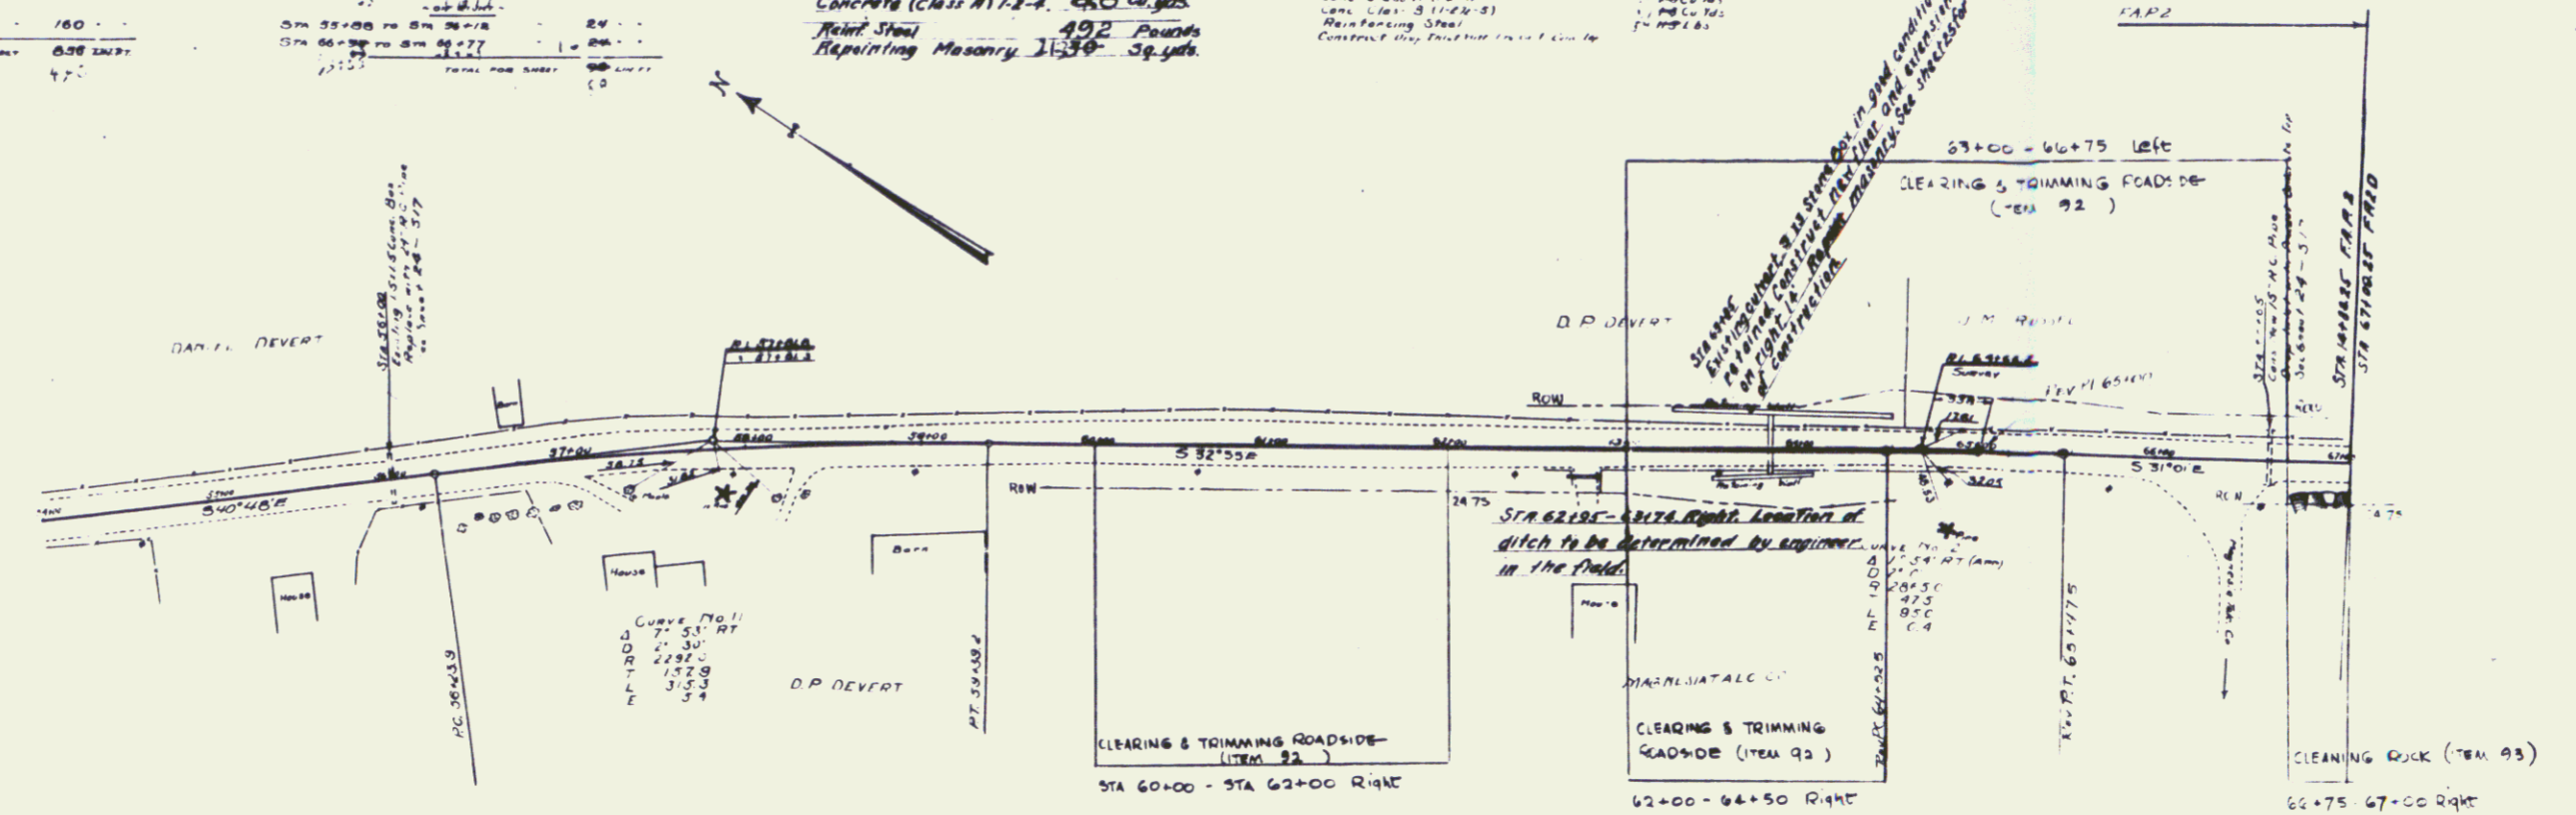

FIELD 1928 B 81