
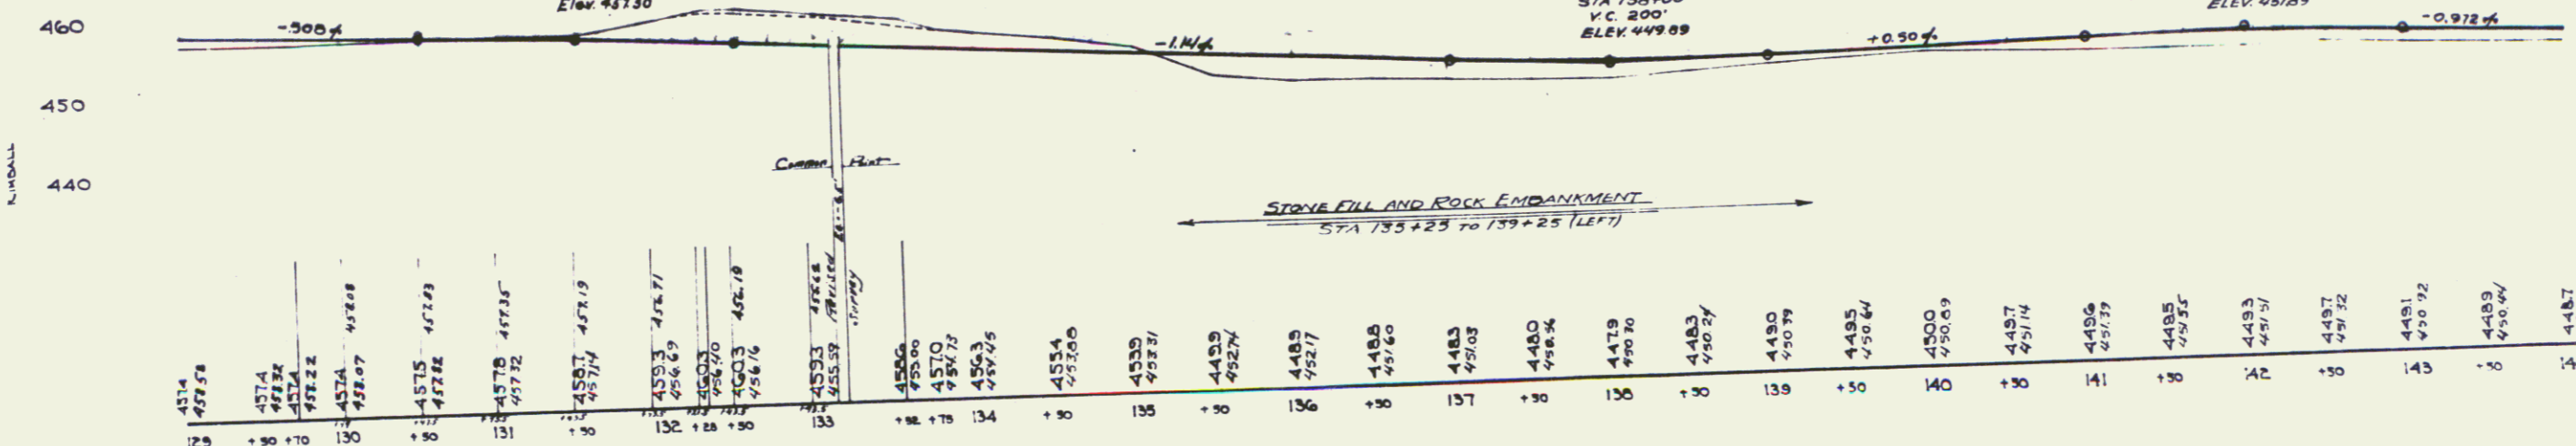


**NEW CABLE GUARDRAIL REQUIRED**  
 STA 129+00 TO STA 130+00 LENGTH 1000 LF  
 STA 130+00 TO STA 131+00 LENGTH 1000 LF  
 TOTAL FOR 5000 LF

**NEW WOOD GUARDRAIL REQUIRED**  
 STA 131+00 TO STA 132+00 LENGTH 1000 LF  
 STA 132+00 TO STA 133+00 LENGTH 1000 LF  
 TOTAL FOR 2000 LF

**NEW CULVERTS REQUIRED**  
 STA 129+70 30' REINFORCED CONCRETE PIPE - LENGTH 30' - 18" REINFORCED CONCRETE CLASS B (1413) REINFORCING STEEL  
 STA 138+00 18' REINFORCED CONCRETE PIPE - LENGTH 30' - 18" REINFORCED CONCRETE CLASS B (1413) REINFORCING STEEL

DATE	10/1/58
BY	W. J. ...
CHECKED	...
SCALE	1" = 40'

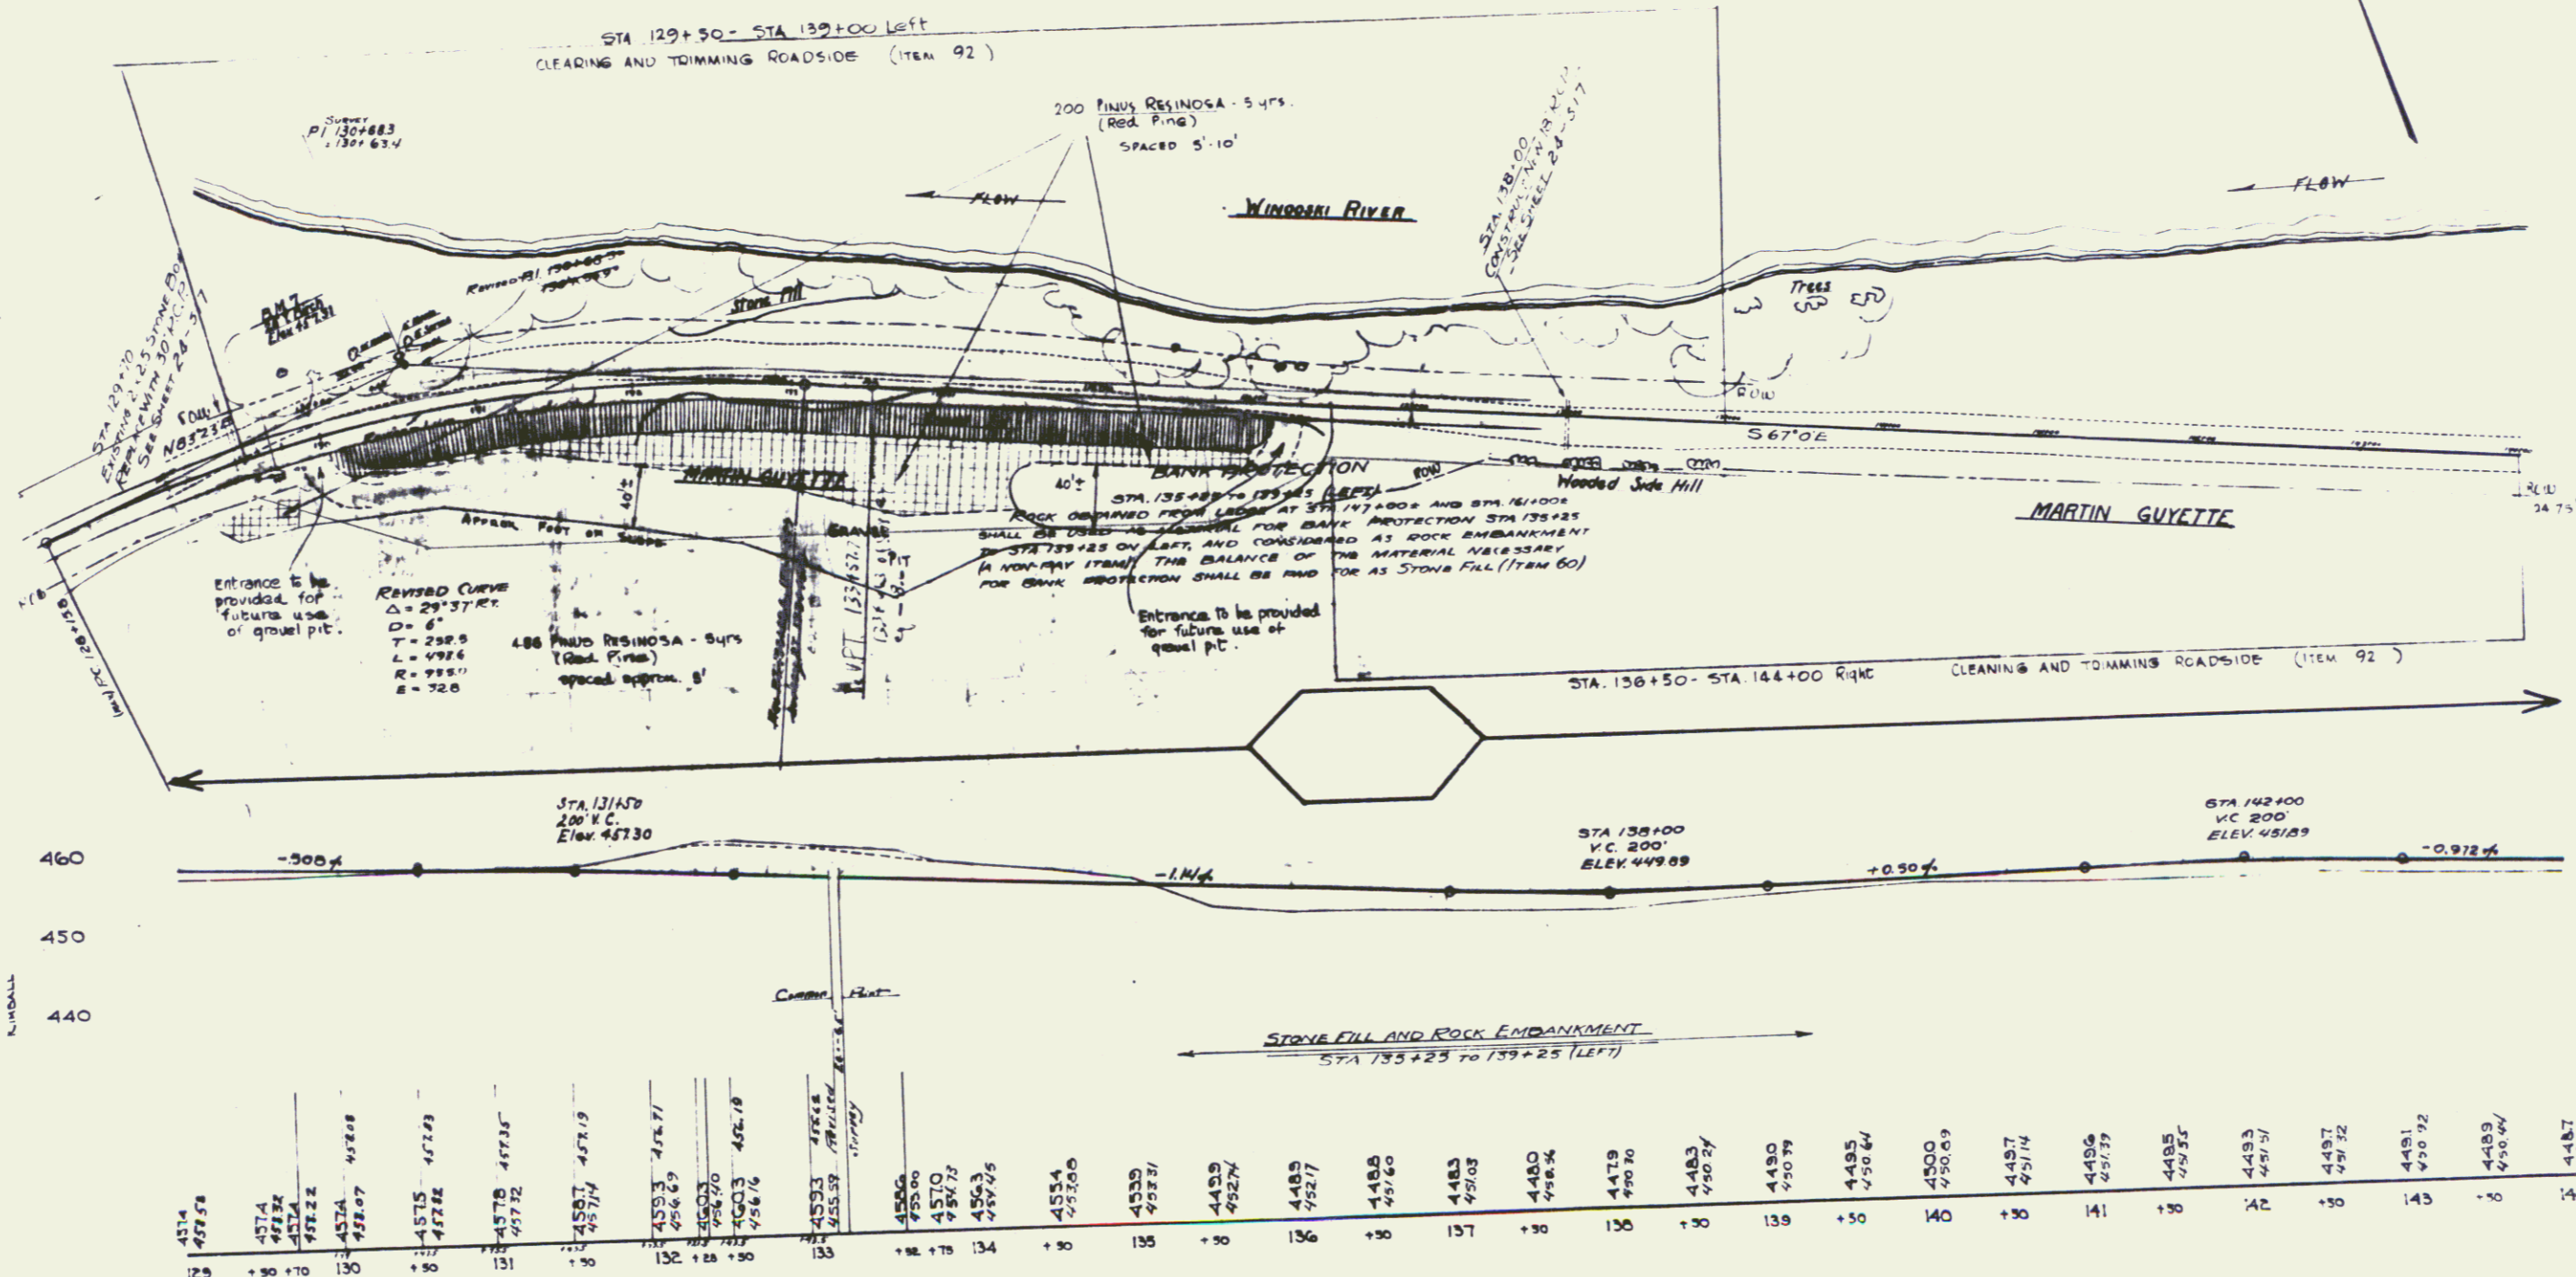

B.M. 7 Spike in root 20' yellow birch 27.5' left sta 129+96 Elev 457.31

SEE EN NRH 107-C (293) LANDSCAPING  
 SHEET 8 OF 26

5