


Grade Road Standard Full Beam
 w/ 14'0" Posts Type 17
 STA 50+89 LT → STA 52+35 LT
 STA 50+45 RT → STA 51+73 RT

POOR ORIGINAL COPY

PLAN
 DATE: 10/15/50
 DRAWN BY: [illegible]
 CHECKED BY: [illegible]

PROFILE
 DATE: 10/15/50
 DRAWN BY: [illegible]
 CHECKED BY: [illegible]

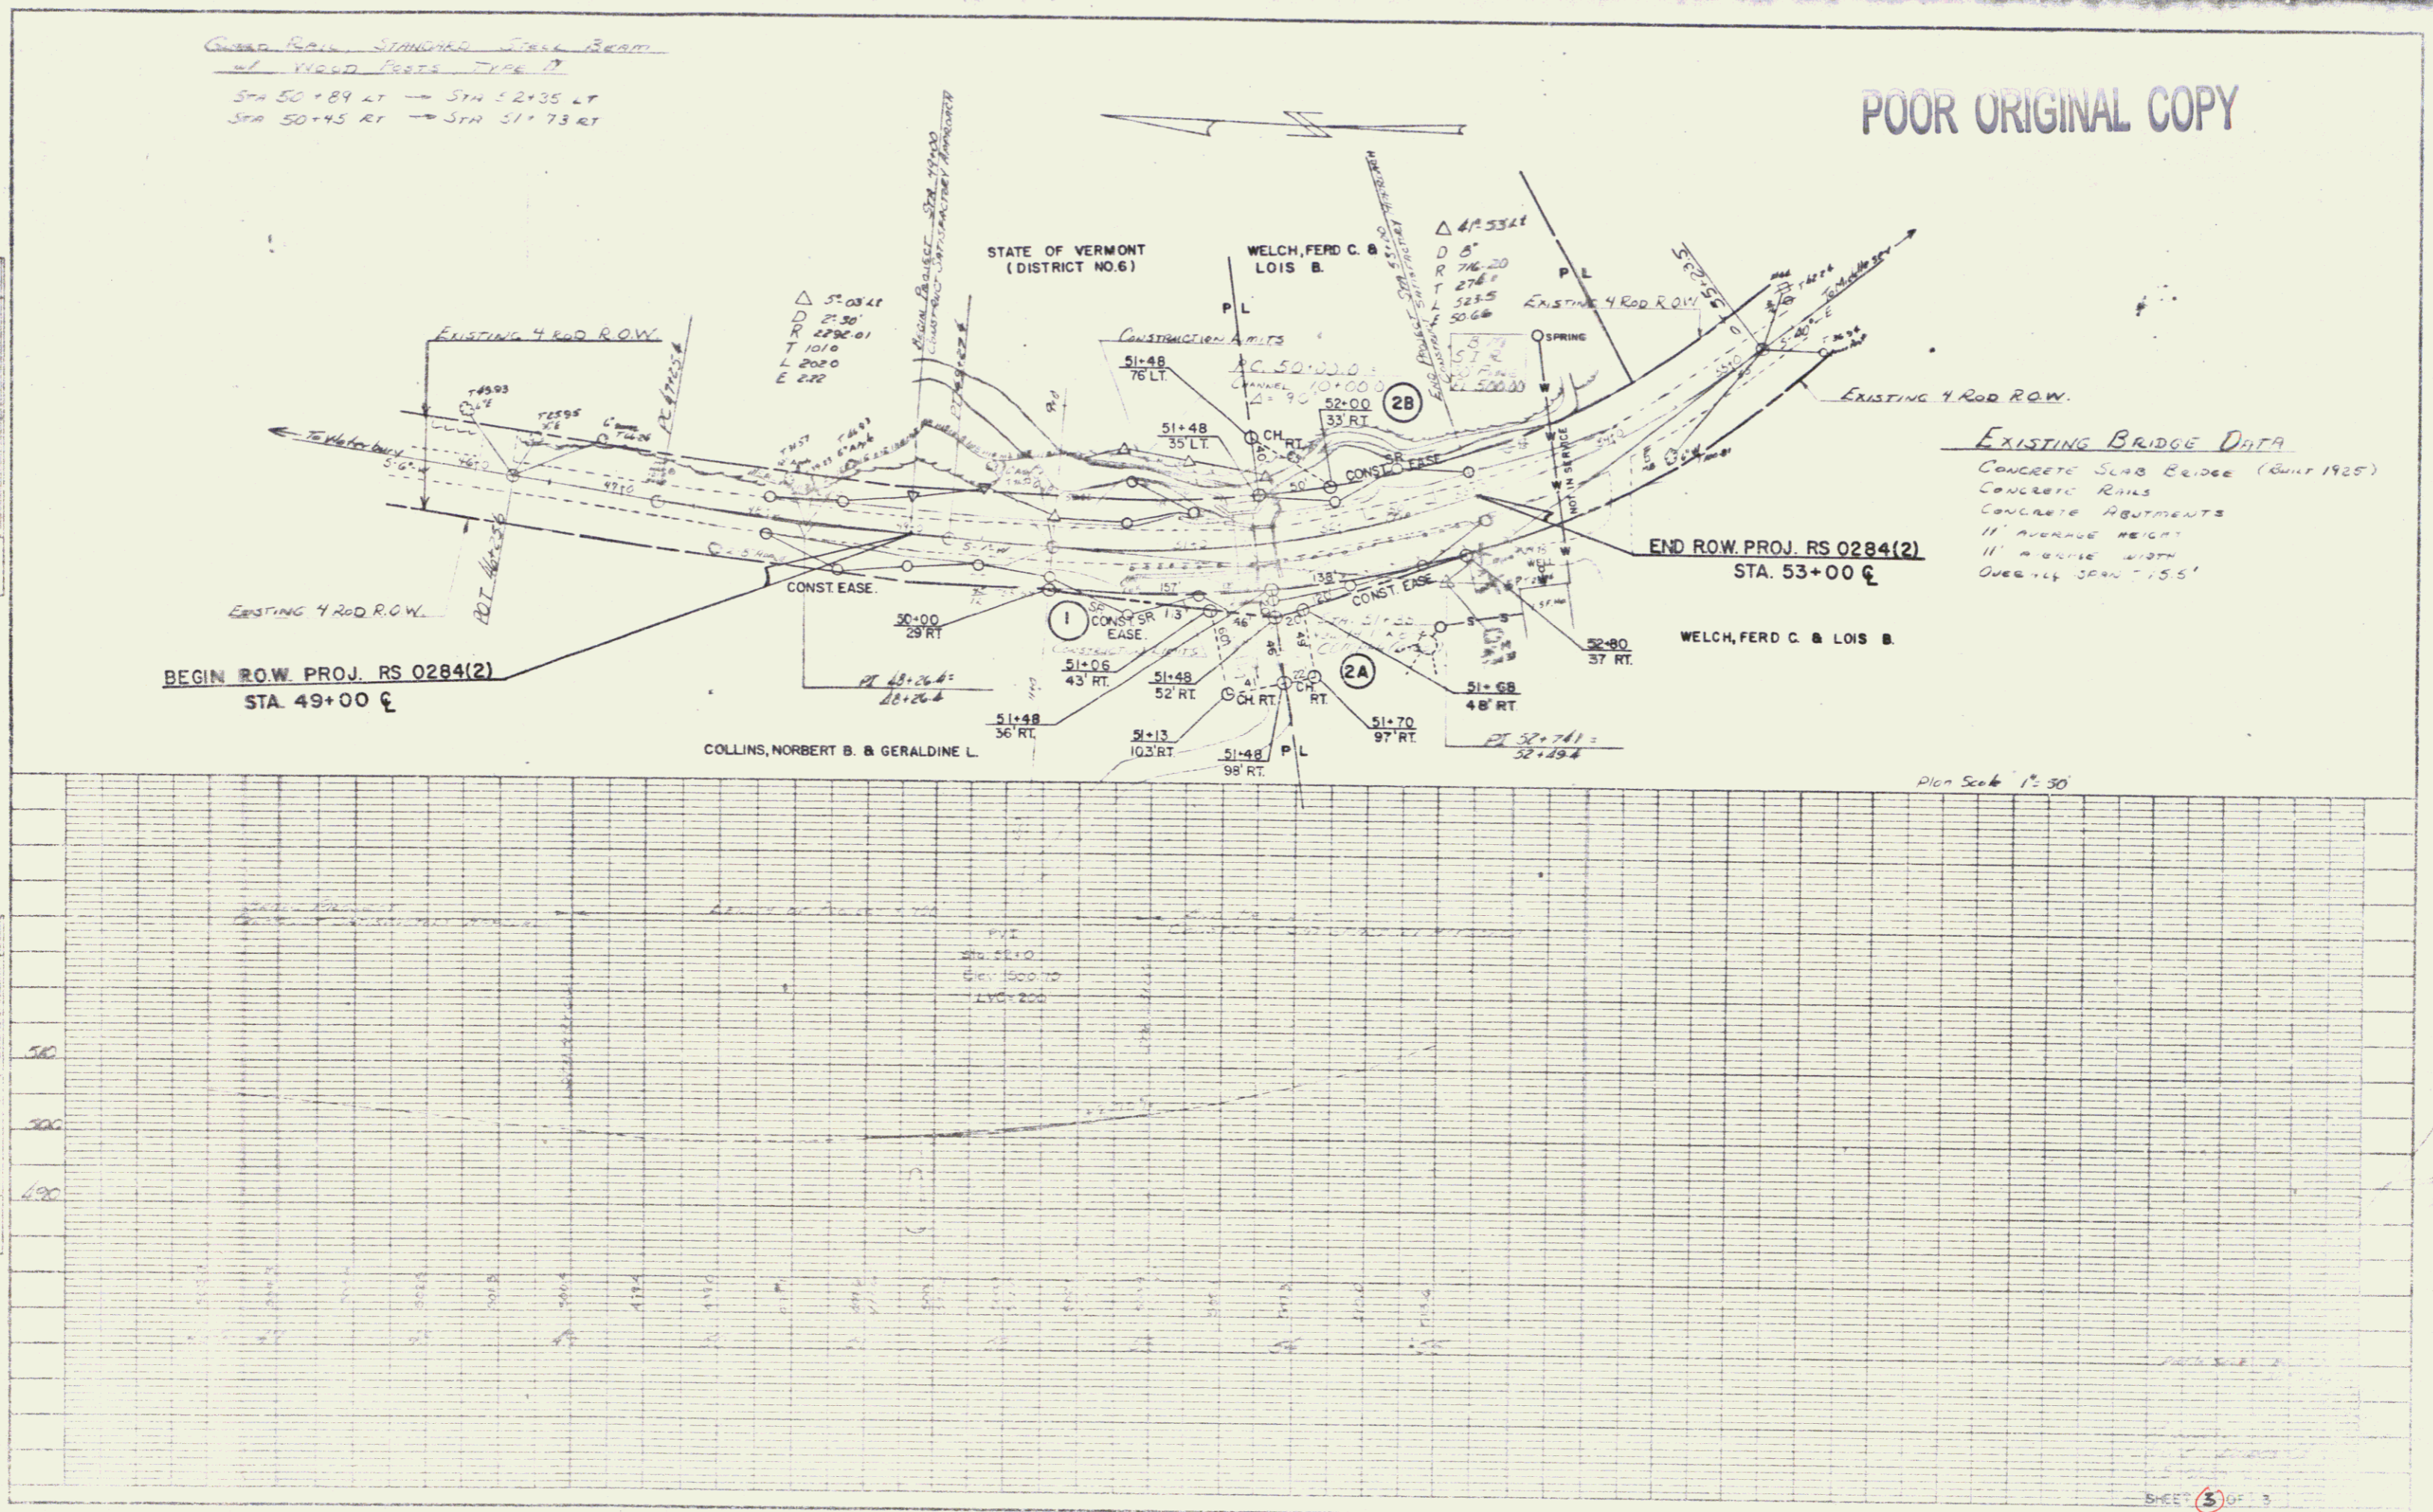

EXISTING BRIDGE DATA
 CONCRETE SLAB BRIDGE (BUILT 1925)
 CONCRETE RAILS
 CONCRETE ABUTMENTS
 11' AVERAGE HEIGHT
 11' AVERAGE WIDTH
 OVERALL SPAN = 15.5'

Plan Scale 1" = 30'