
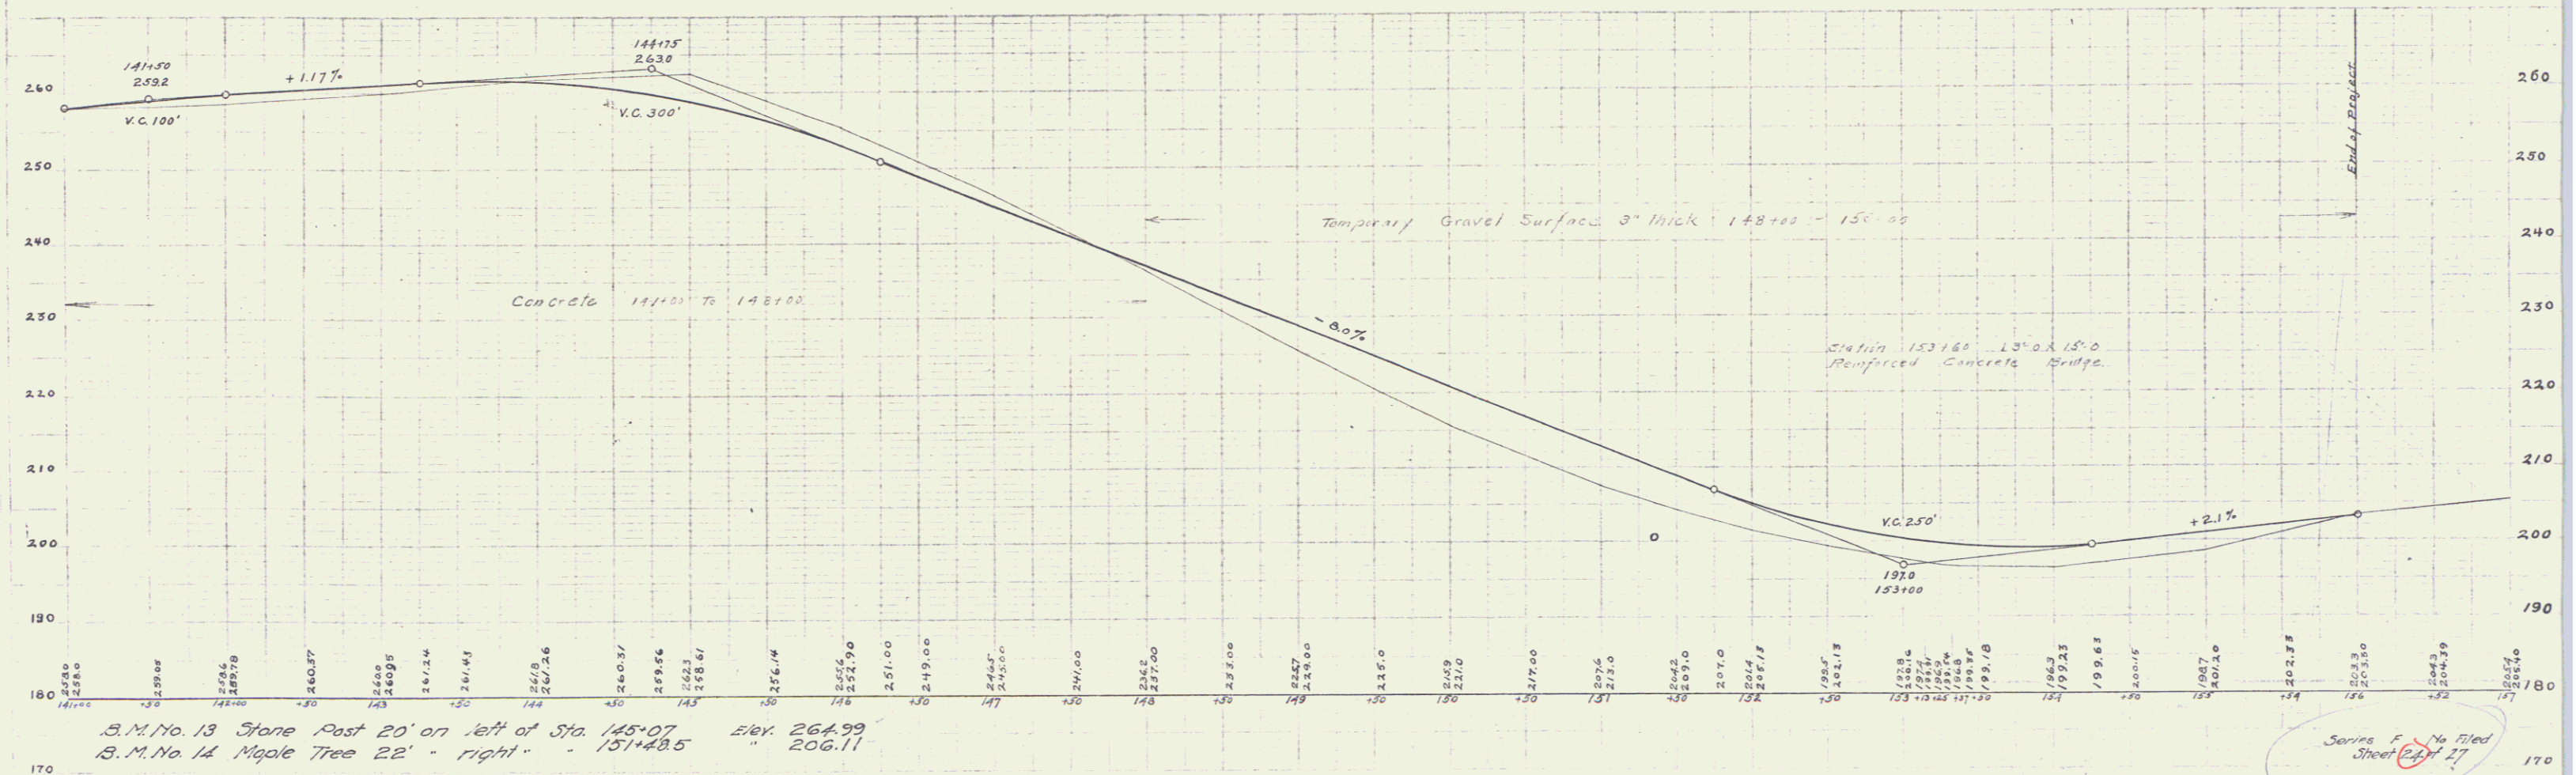


GUARD RAIL REQUIRED
ON LEFT
Sta 149+00 to Sta 154+04 Length 504 ft
ON RIGHT
Sta 149+00 to Sta 154+44 Length 544 ft
Total This Sheet 960 ft

NEW CULVERT REQUIRED
Sta 150+00 18" Concrete Pipe 40 ft
1-2% S Concrete Roadway 2.3 Cu yds

FOO 11
DIS NO 9
PEN No 60-A
YE R 1922 24 27

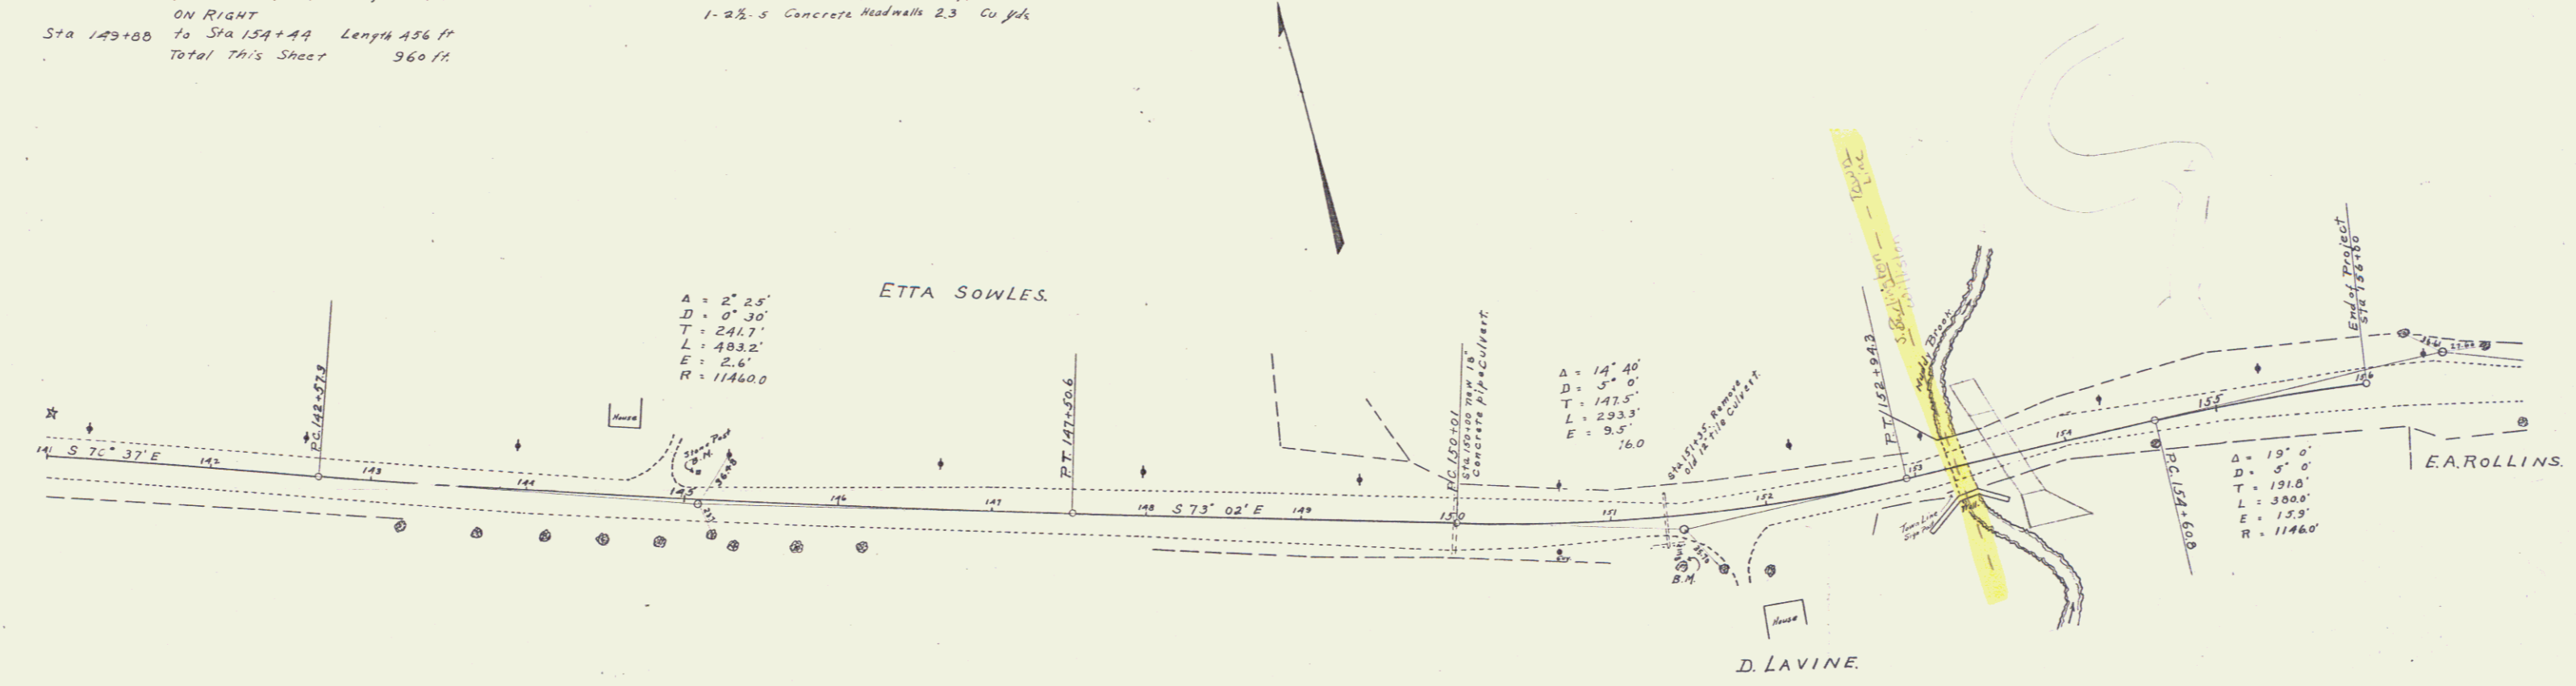

B.M. No. 13 Stone Post 20' on left of Sta. 145+07 Elev. 264.99
B.M. No. 14 Maple Tree 22' right - 151+05 " 206.11

Series E No filed
Sheet 27 of 27