
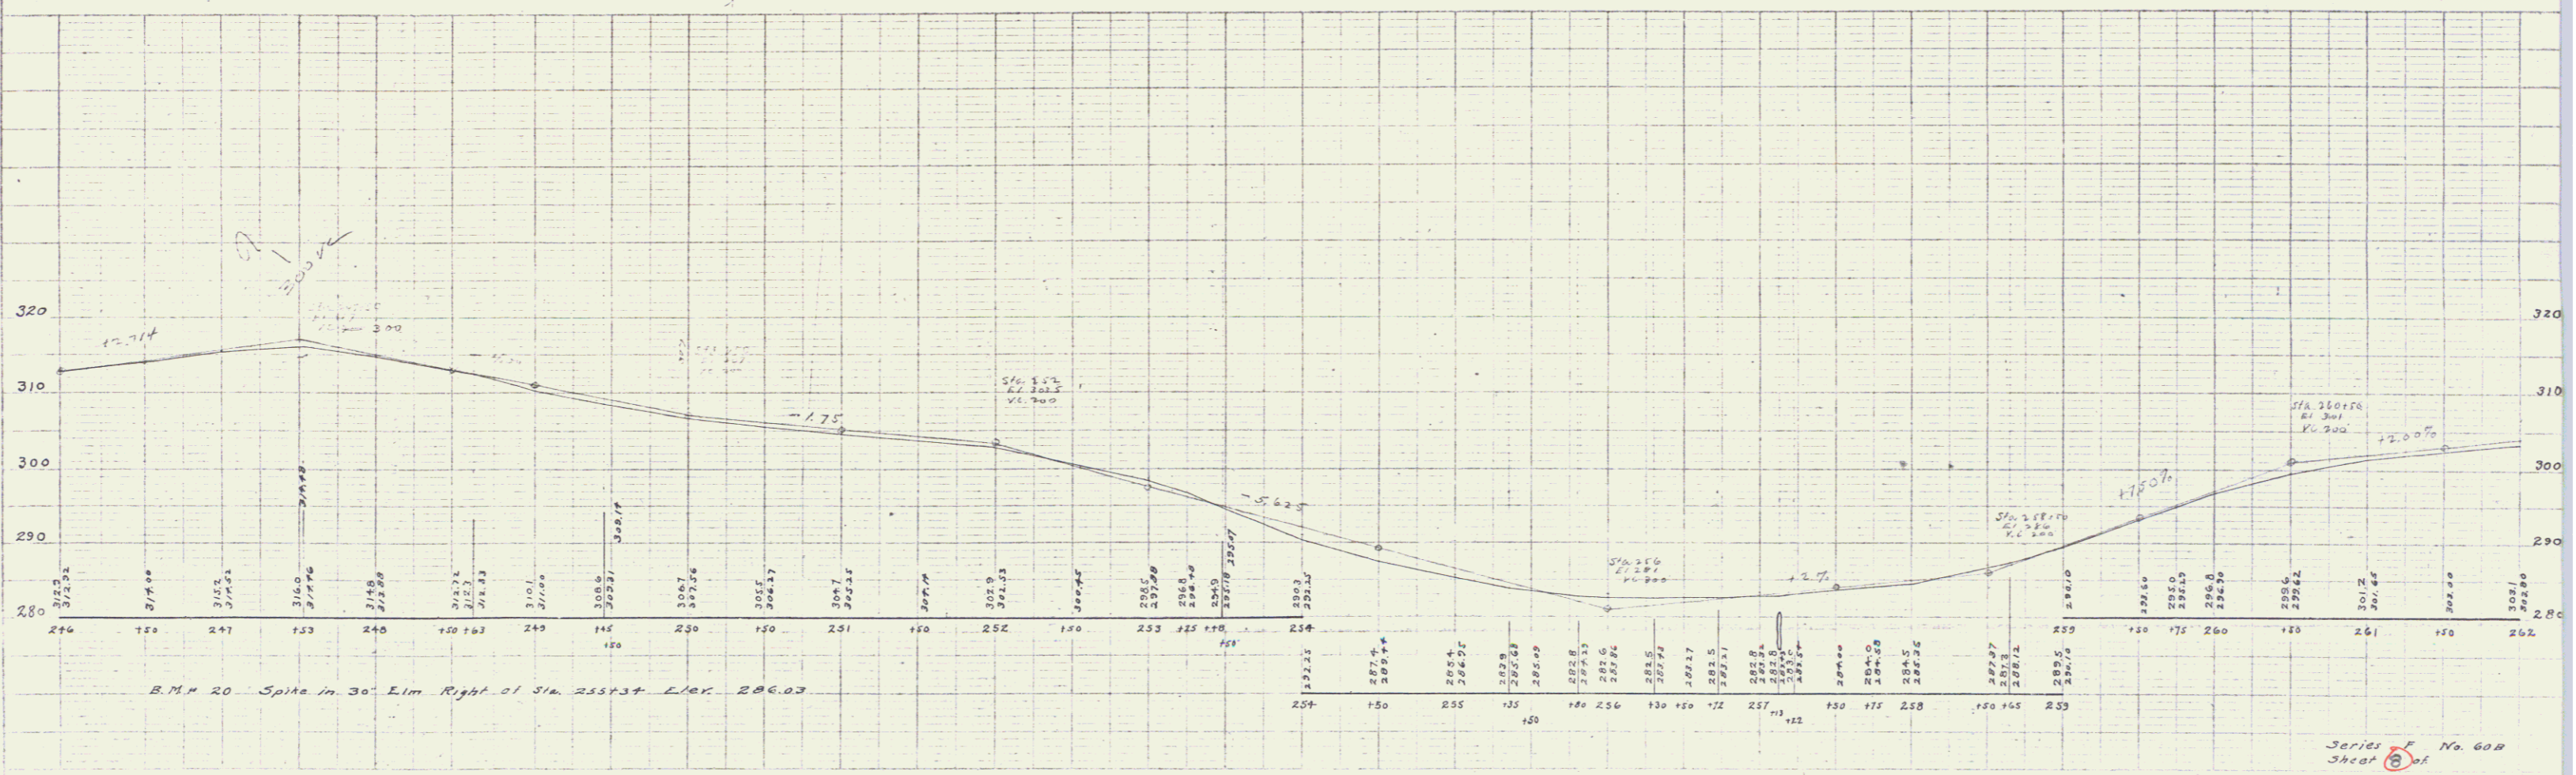


GUARD RAIL REQUIRED
 ON LEFT
 Sta 257+00 to Sta 257+24 Length 24 ft
 ON RIGHT
 Sta 258+72 to Sta 258+32 Length 40 ft
 Total This Sheet 184 ft

NO.	DATE	BY	REVISION
1			
2			
3			

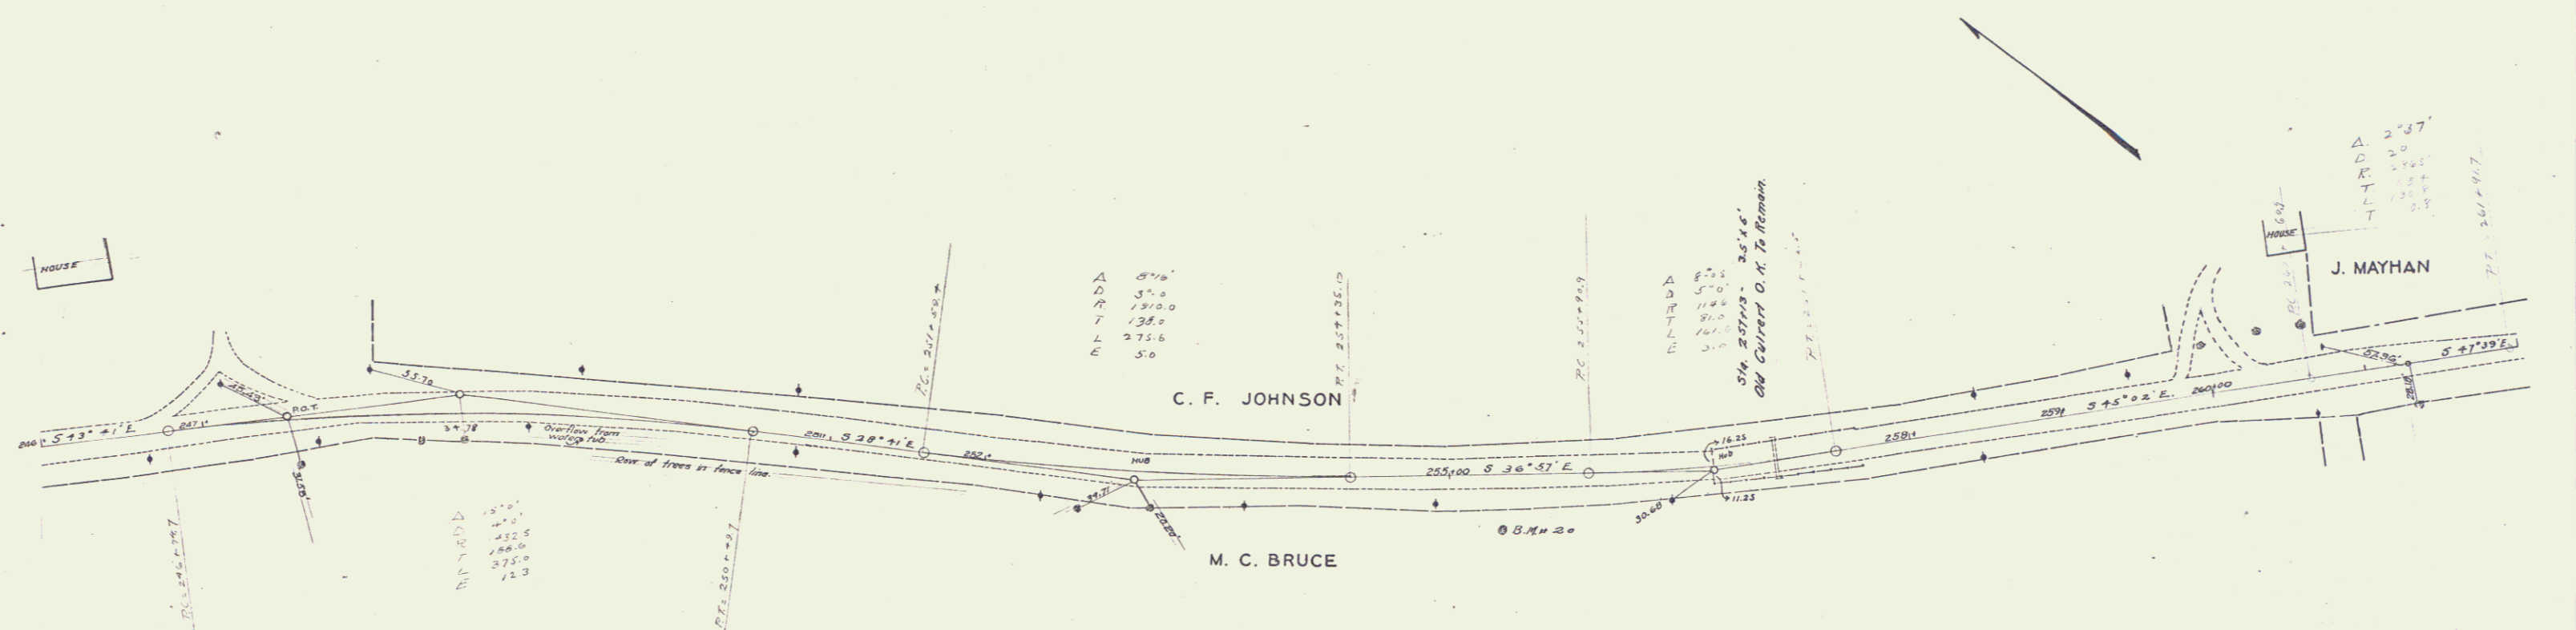

Series # No. 60
 Sheet 8 of 9