



PROJECT: U.S. 2 to Burlington
 DRAWN BY: MILLER
 CHECKED BY: [blank]
 DATE: [blank]

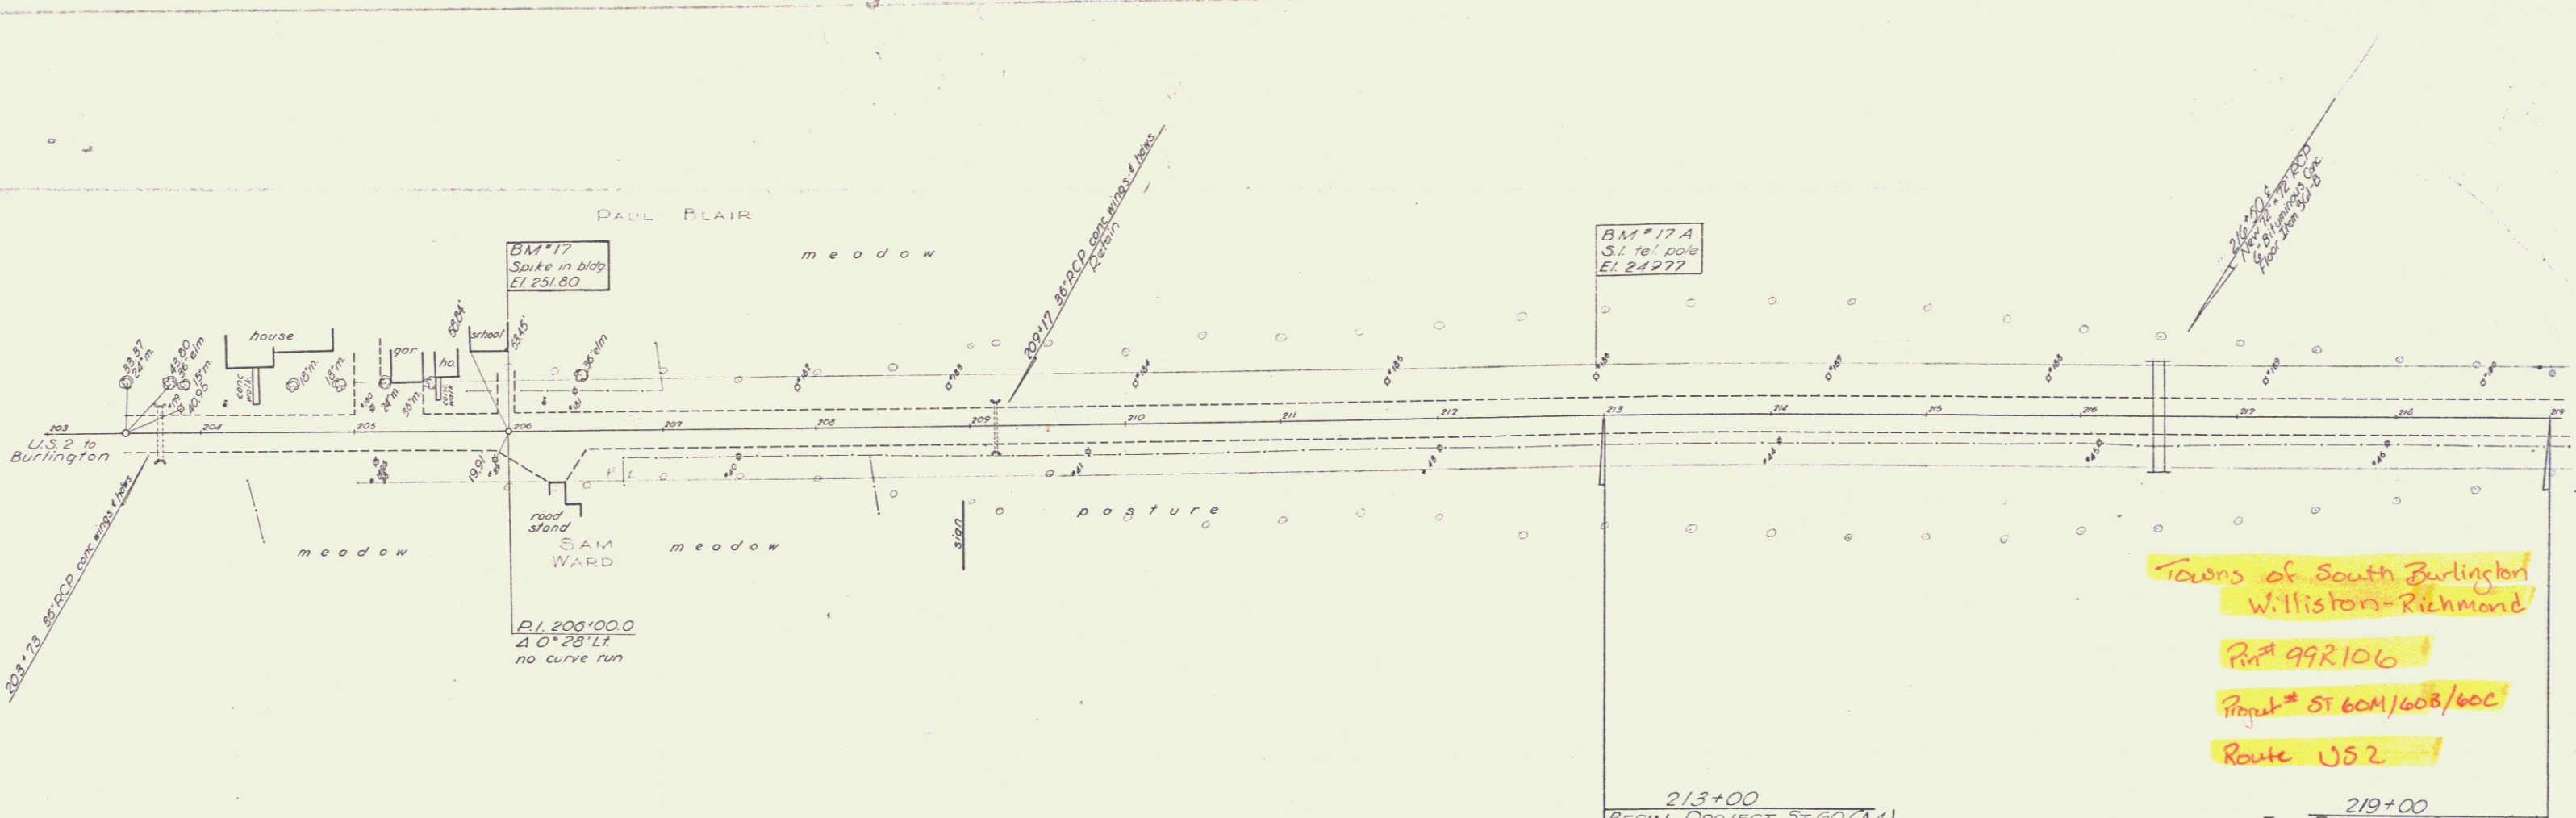

Towns of South Burlington
 Williston-Richmond
 Proj # 99R106
 Project # ST 60M/60B/60C
 Route US2

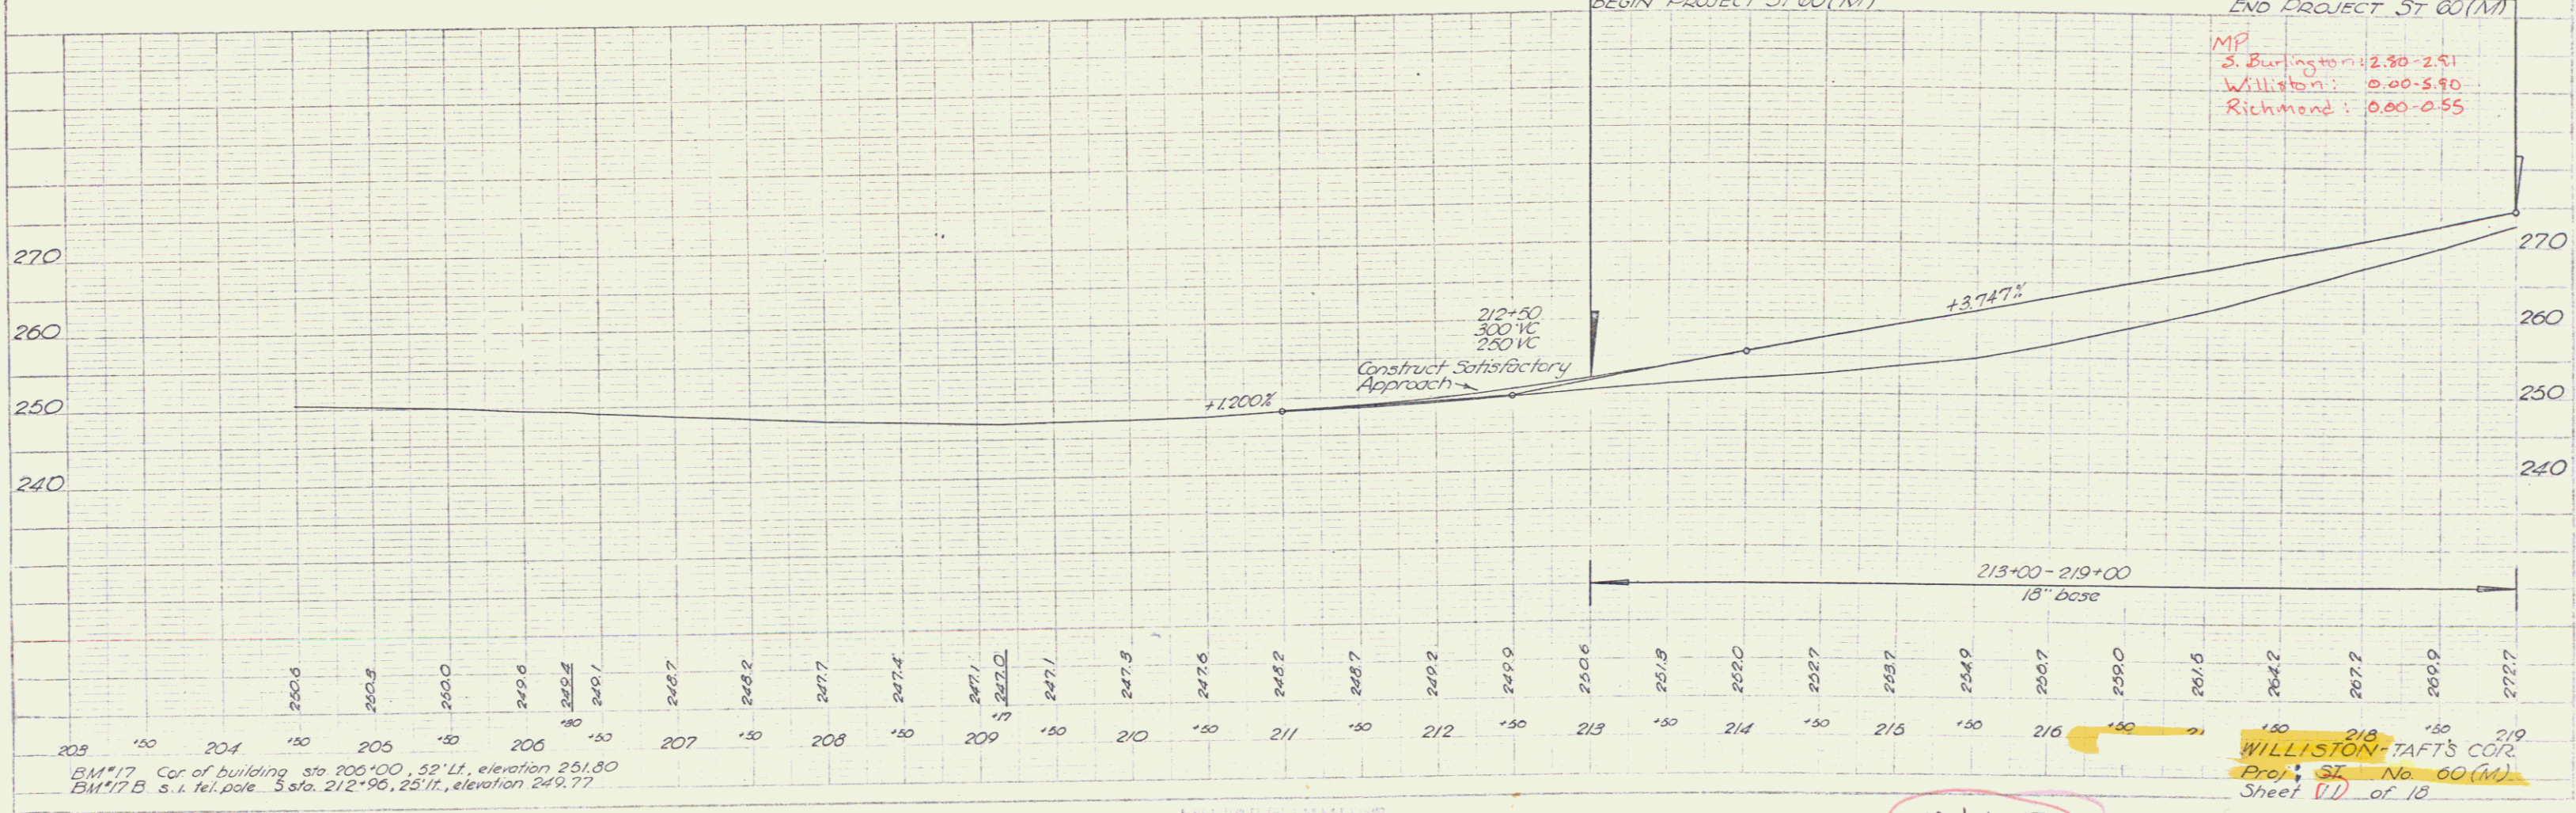

BM*17 Cor. of building sta 206+00, 52' LT, elevation 251.80
 BM*17B s.i. tel. pole sta. 212+96, 25' LT, elevation 249.77

WILLISTON TAFTS COR.
 Proj. ST No. 60 (M)
 Sheet 11 of 18

12/1/55