



Town: South Burlington-Williston
 Route: 452
 Project: 608

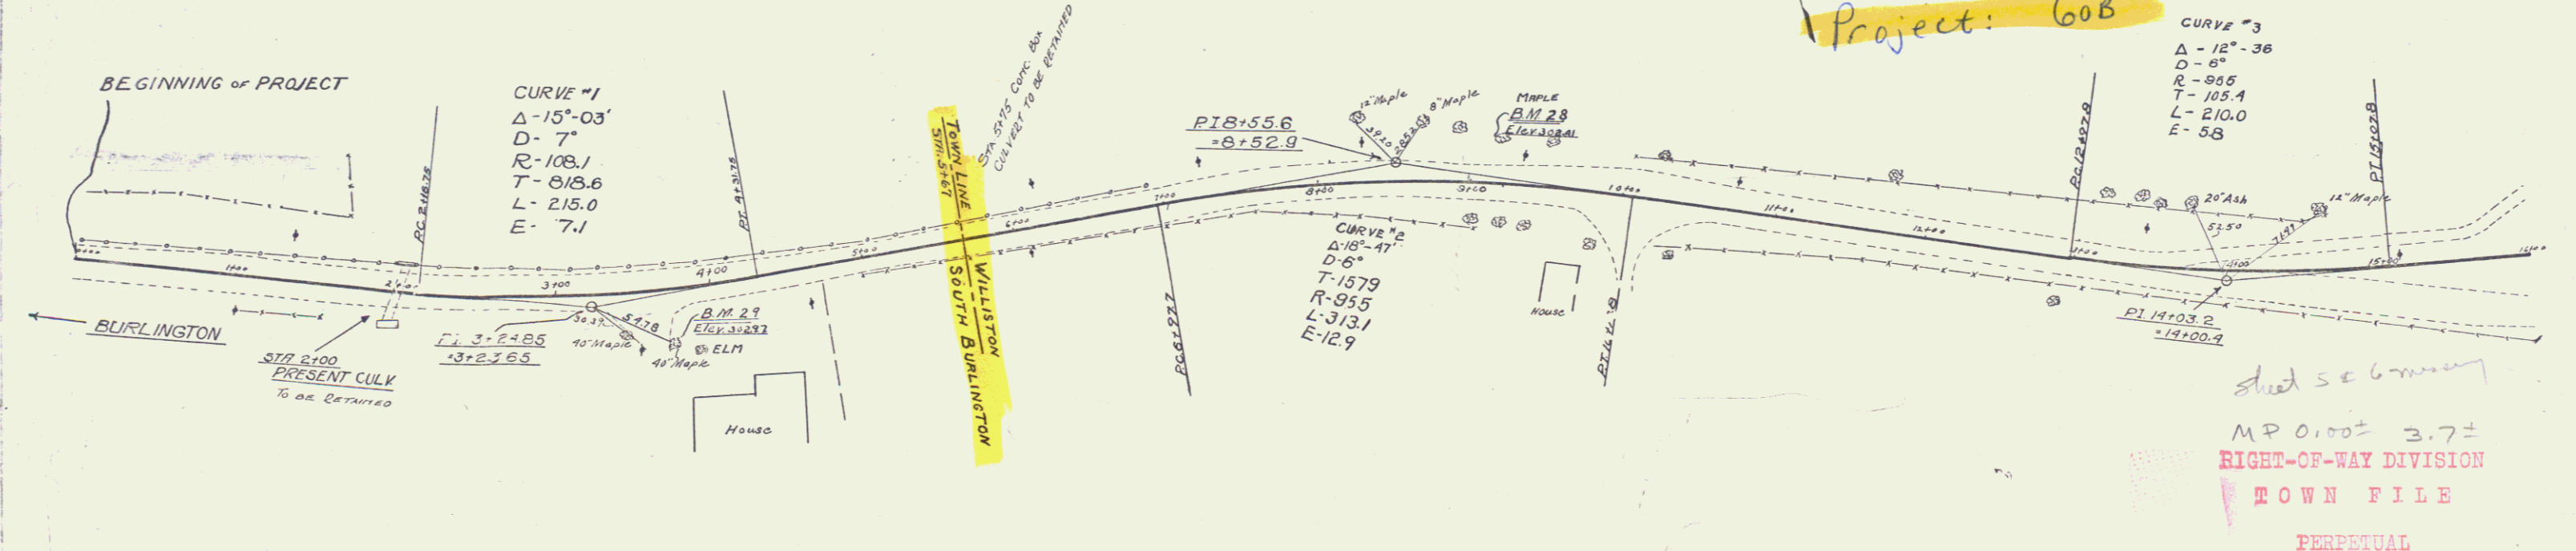

Sheet 5 of 6
 MP 0.100 ± 3.7 ±
 RIGHT-OF-WAY DIVISION
 TOWN FILE
 PERPETUAL
 Town of _____
 (To Be Returned To R.O.W. Division)

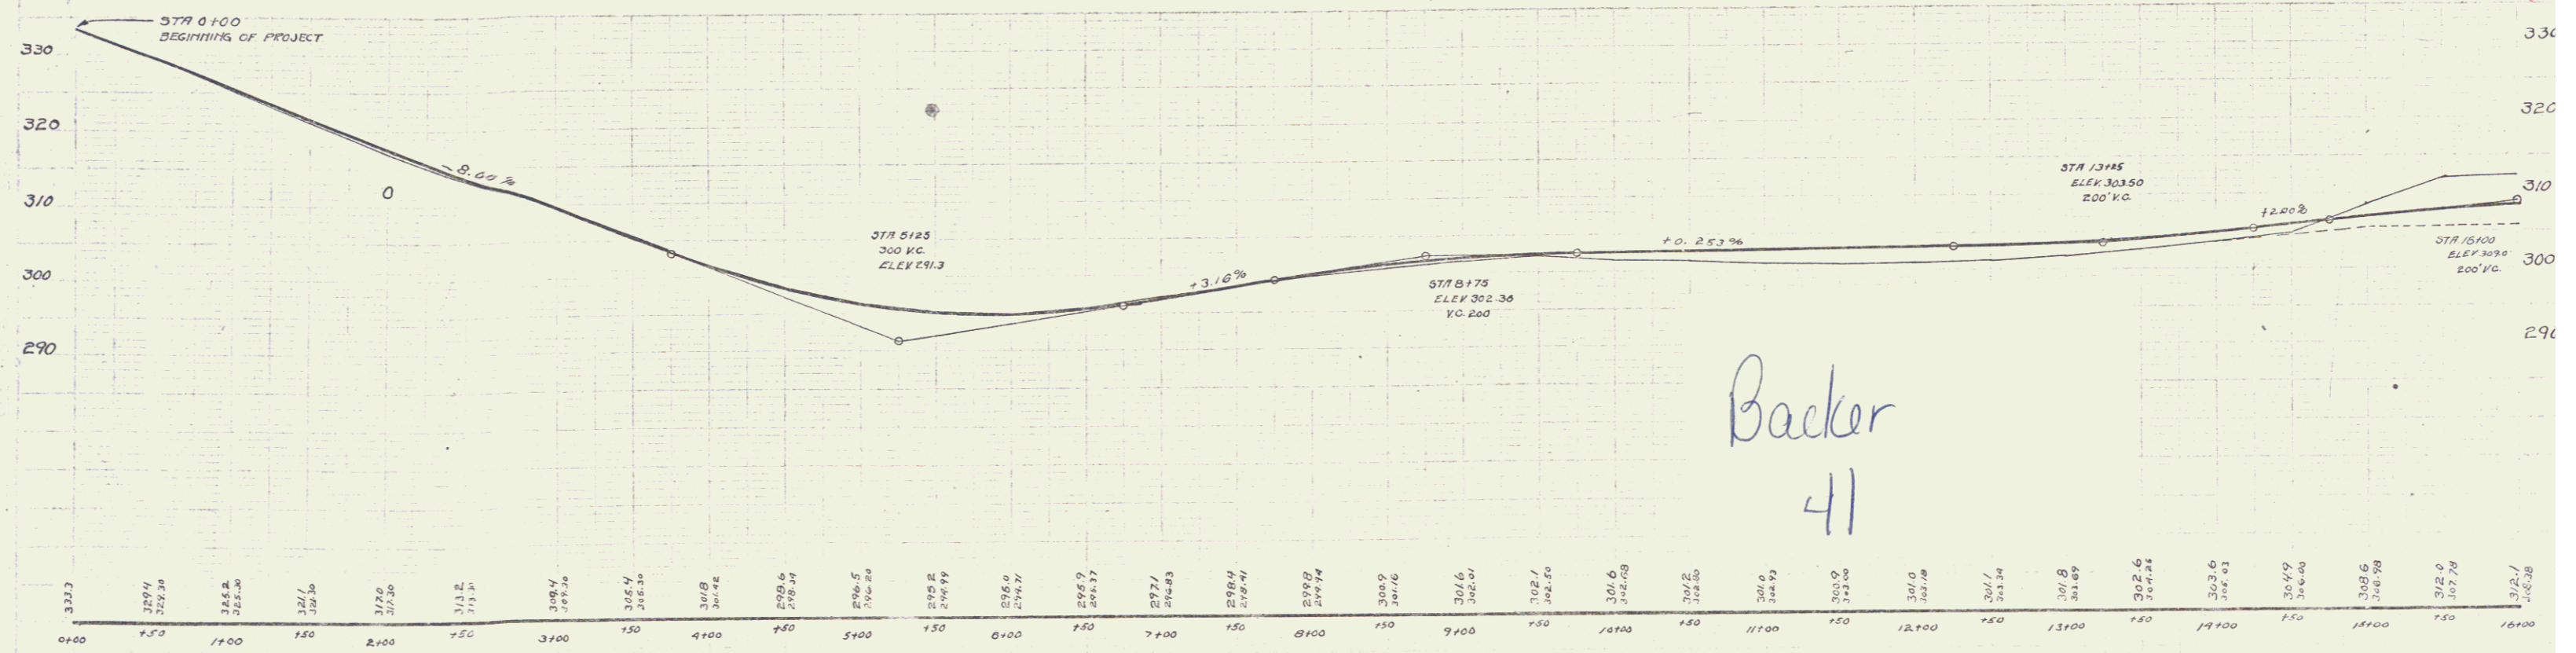

Backer
 41

B.M. #28 20' MAPLE LT. STA. 9+00 302.41
 B.M. #29 40' ELM RT. STA. 3+71 302.97

SERIES 3 608
 SHEET 3 OF 15