


10A

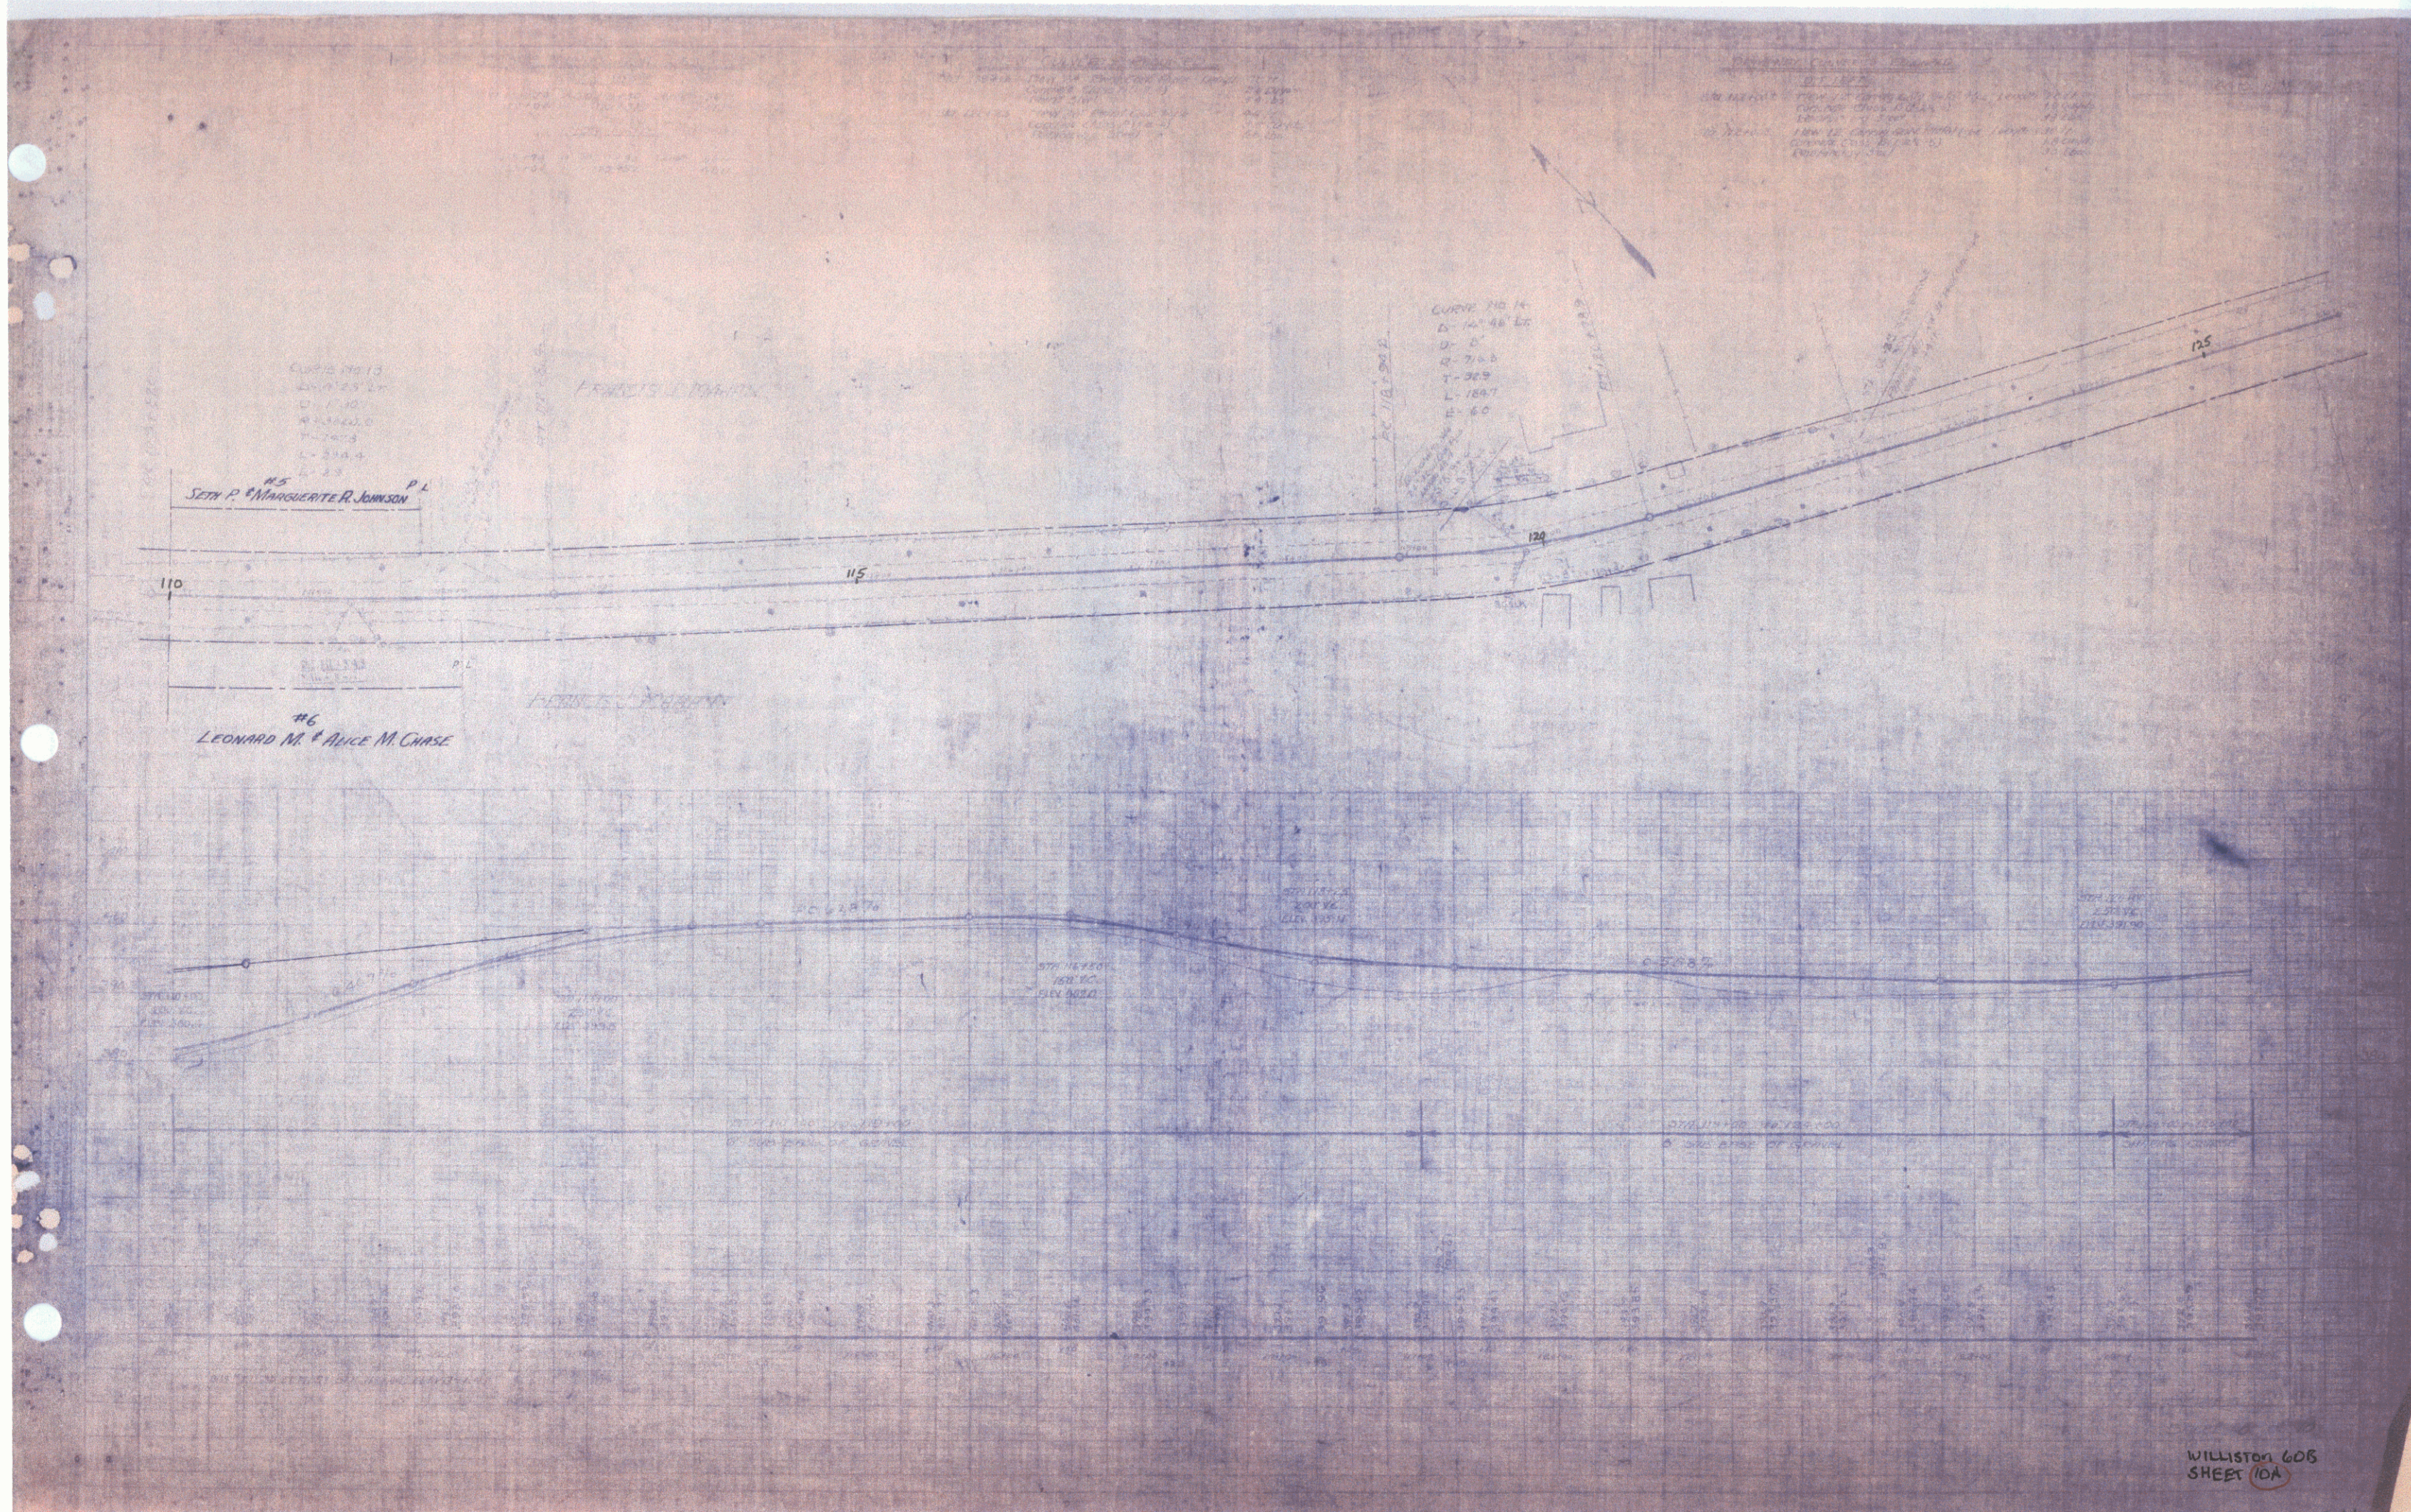

WILLISTON 608
SHEET 10A