


114

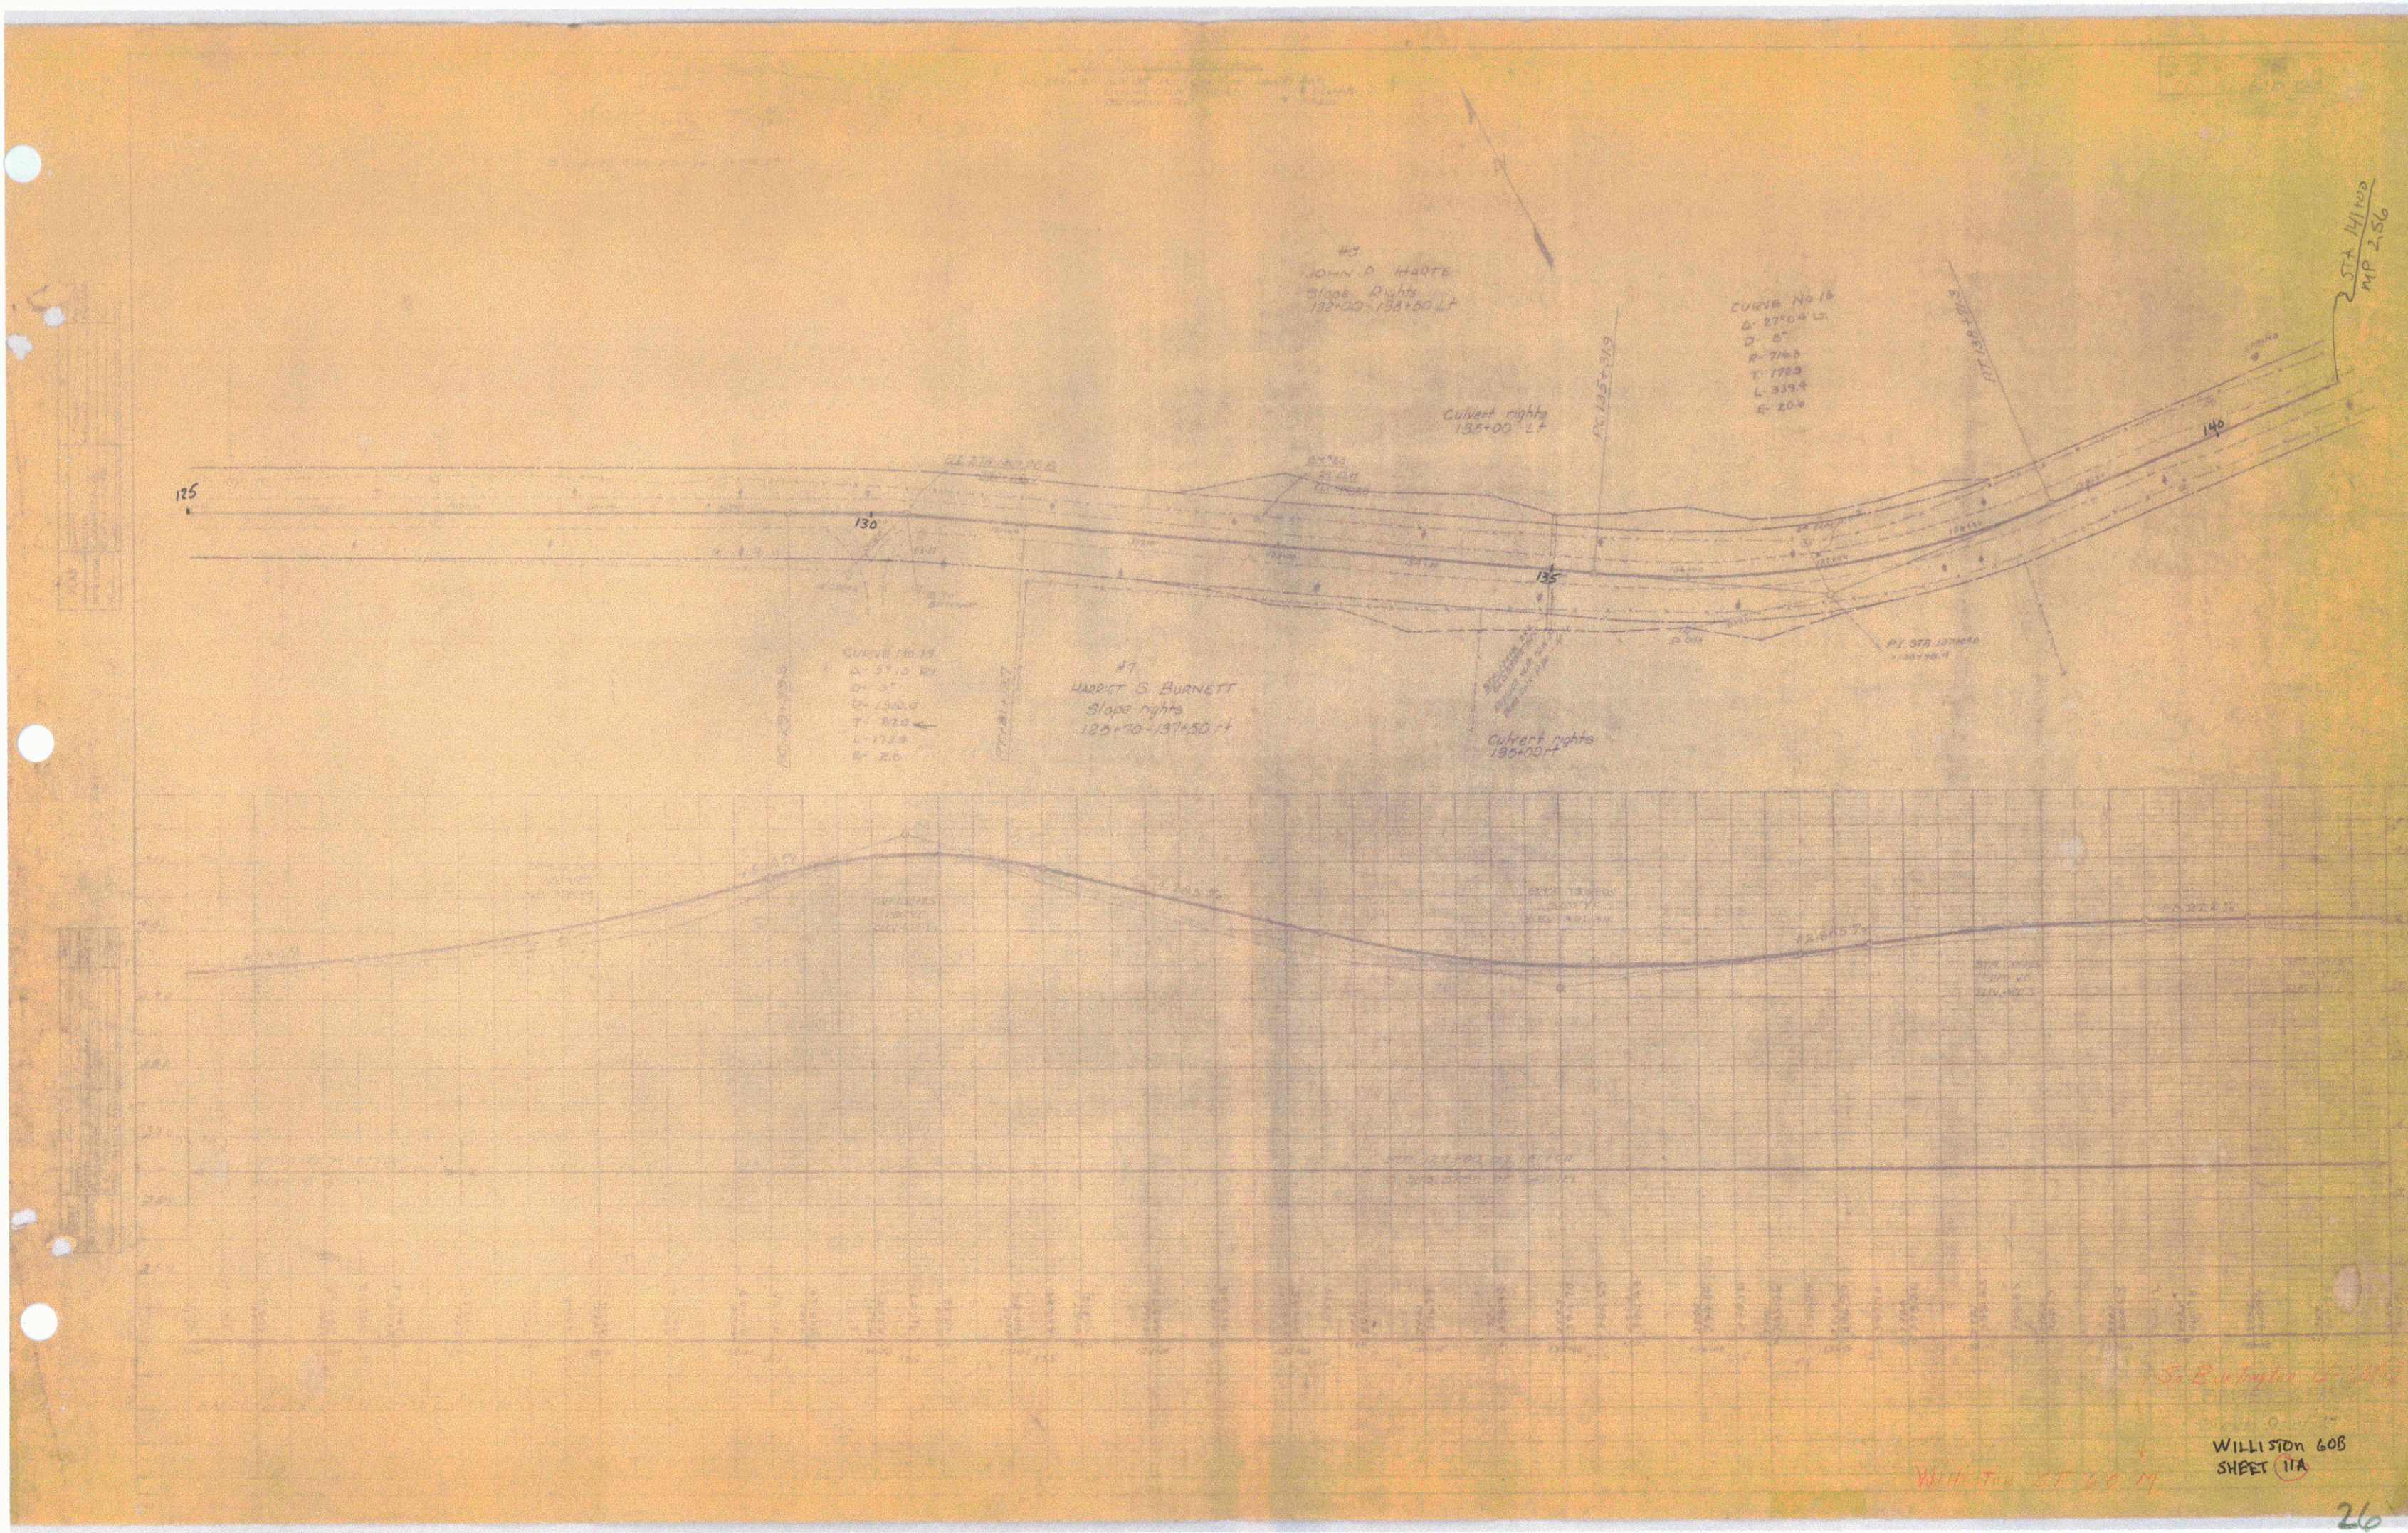

WILLISTON 608
SHEET 11A