

WOOD GUARD RAIL REQUIRED

ON LEFT
 STA 192+32 To STA 192+56 Length 24 ft
 " 193+34 " " 193+58 " 24 ft
 " 199+61 " " 199+85 " 24 ft
ON RIGHT
 STA 192+32 To STA 192+56 Length 24 ft
 " 193+34 " " 193+58 " 24 ft
 " 199+61 " " 199+85 " 24 ft



VIEWWAY CULVERTS REQUIRED

View 18' Round Conc Box Length 100 ft
 Concrete Class A (1-2-4) 1.9 Cu yds
 Reinforcing Steel 54 LBS.

NEW CULVERTS REQUIRED

Sta 192+44 New 36" Round Conc Box Length 36 ft
 Concrete Class A (1-2-4) 4.3 Cu yds
 Reinforcing Steel 58 LBS.
 Sta 193+46 New 18' Round Conc Pipe Length 32 ft
 With Drop Inlet with Grate
 Concrete Class A (1-2-4) 2.1 Cu yds
 Reinforcing Steel 101 LBS.
 Sta 199+73 New 36" Round Conc Box Length 46 ft
 Concrete Class A (1-2-4) 2.0 Cu yds
 Reinforcing Steel 136.4 LBS.

DES. NO.	STATE	PROJECT	FOUN. YEAR	SHEET NO.	SHEET
8	VT.	60-D	1928	73	4-3

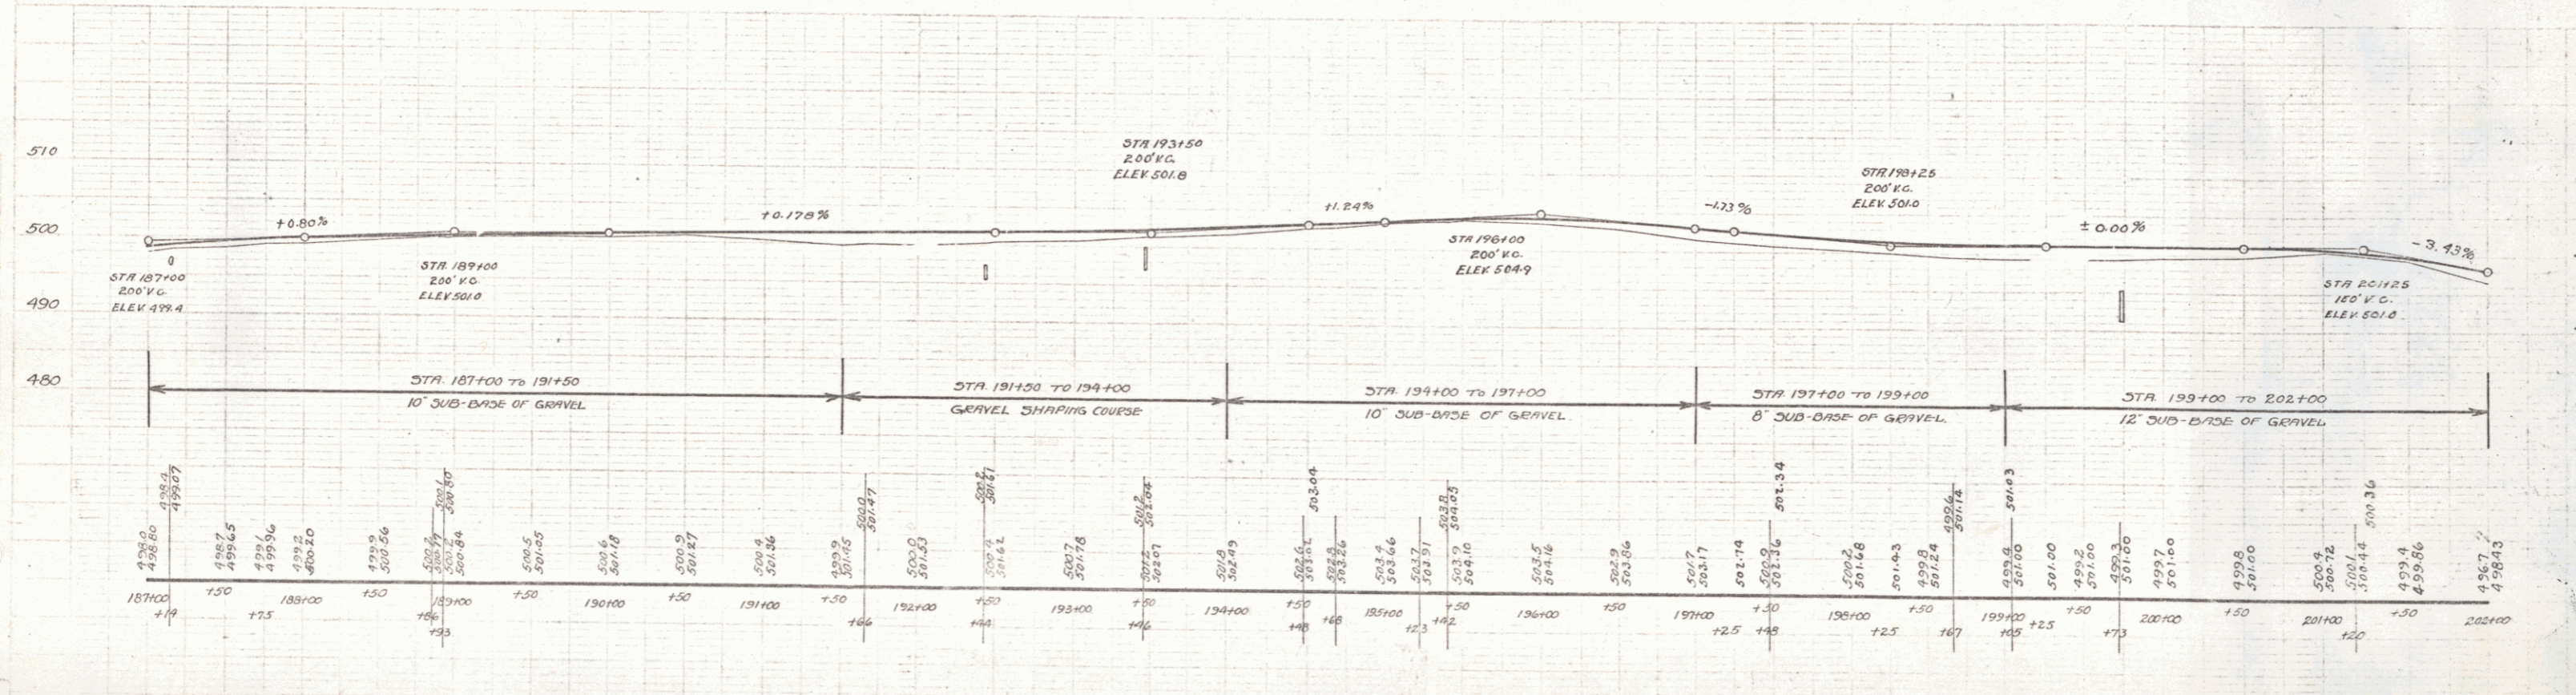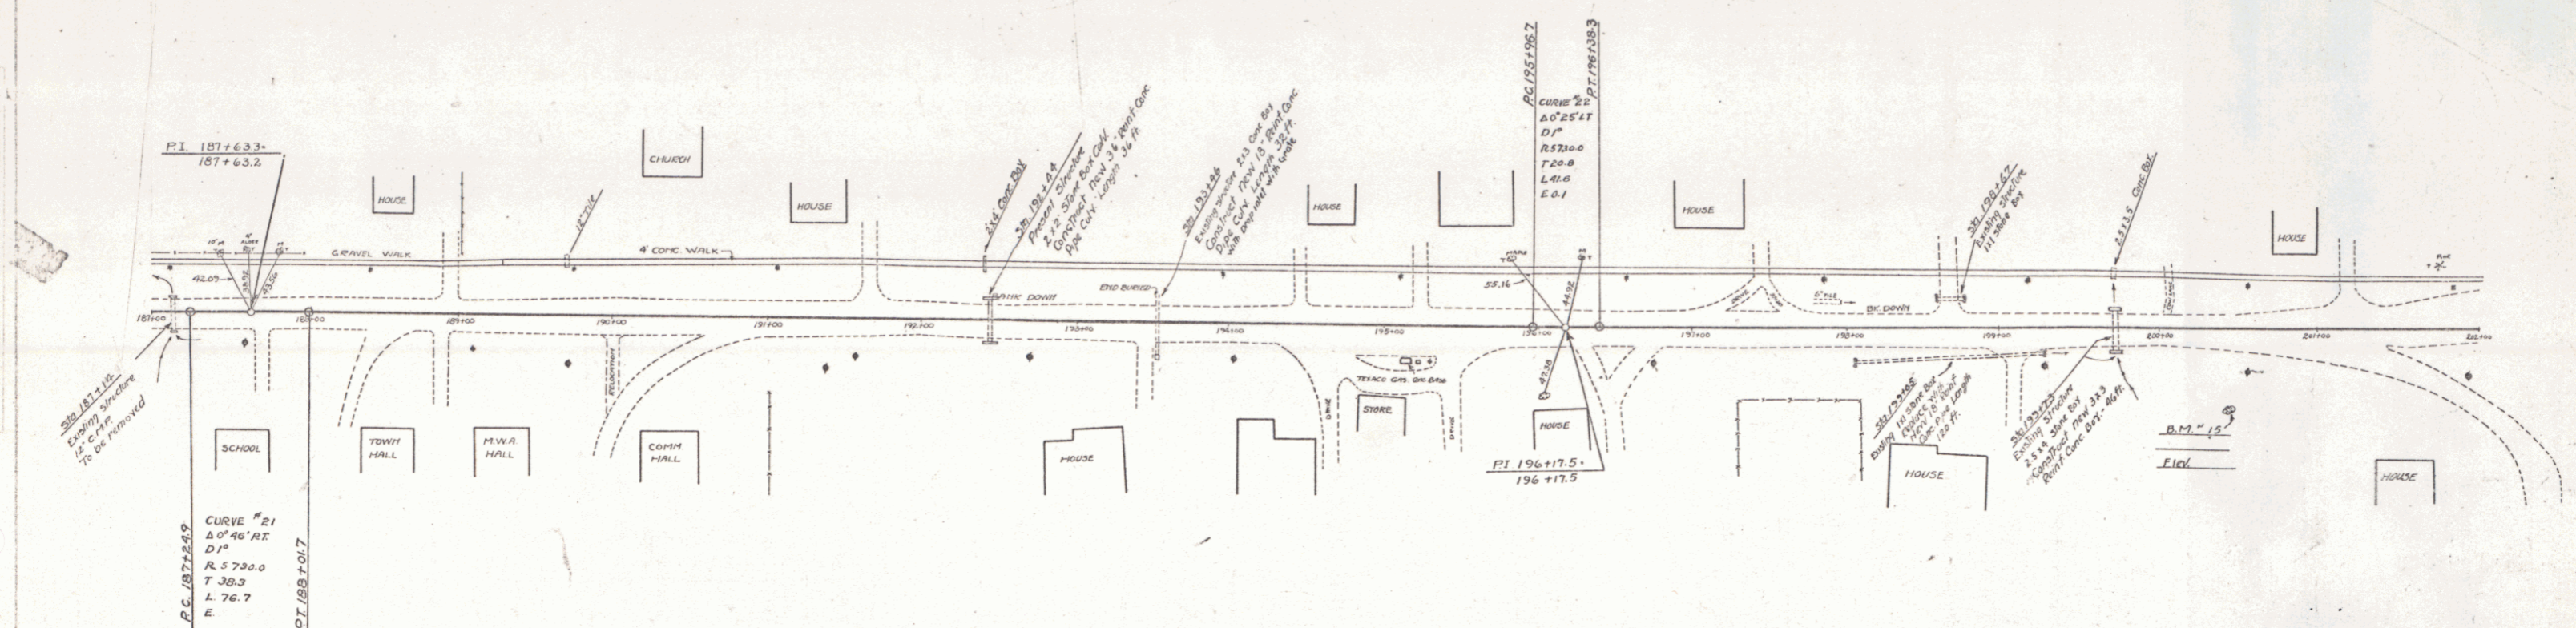

SERIES 60 D
 SHEET 73 OF 45