


Curve No. 2
 Δ 19° 40' L
 D 0' 30"
 R 114.592
 T 130.1
 L 560.0
 E 0.0

Curve No. 4
 Δ 11° 26' L
 D 0' 30"
 R 114.592
 T 130.1
 L 560.0
 E 0.0

Curve No. 5
 Δ 17° 0' L
 D 0' 30"
 R 114.592
 T 130.1
 L 560.0
 E 0.0

Curve No. 3
 Δ 27° 28' R
 D 0' 30"
 R 114.592
 T 130.1
 L 560.0
 E 0.0

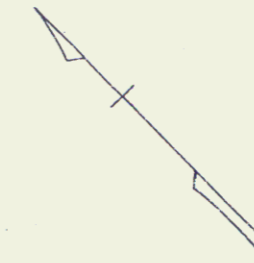

SILVER LEDGE RAILWAY CROSSING ELIMINATION TOWN OF MIDDLESEX Scale 1" = 100'		Checked by: [Signature] Designed by: [Signature] Drawn by: [Signature] Graded by: [Signature] Date: [Date]
--	--	--