

WOOD GUANO PILE REQUIRED

Station	Left	Right
483+00	24'	-
471+25	24'	-
474+00	24'	-

CABLE GUANO PILE REQUIRED



Station	Left	Right
470+00 - 471+00	-	15'
473+00 - 474+00	-	14'
474+00	-	20'

NEW POINT CONC FOR CURVES REQUIRED

Station	Dist	Loc	Conc	R	Curve	Grade
471+00	15'	40'	19cy	12cy	93"	1.2%
483+00	15'	06'	-	29cy	33"	-
471+25	15'	48'	-	17cy	33"	-
475+69	12'	20'	-	-	-	-
475+69	36'	44'	5.3	-	106"	1.2%

WOOD GUIDE POSTS REQUIRED

Station	Left	Right
483+00	-	1

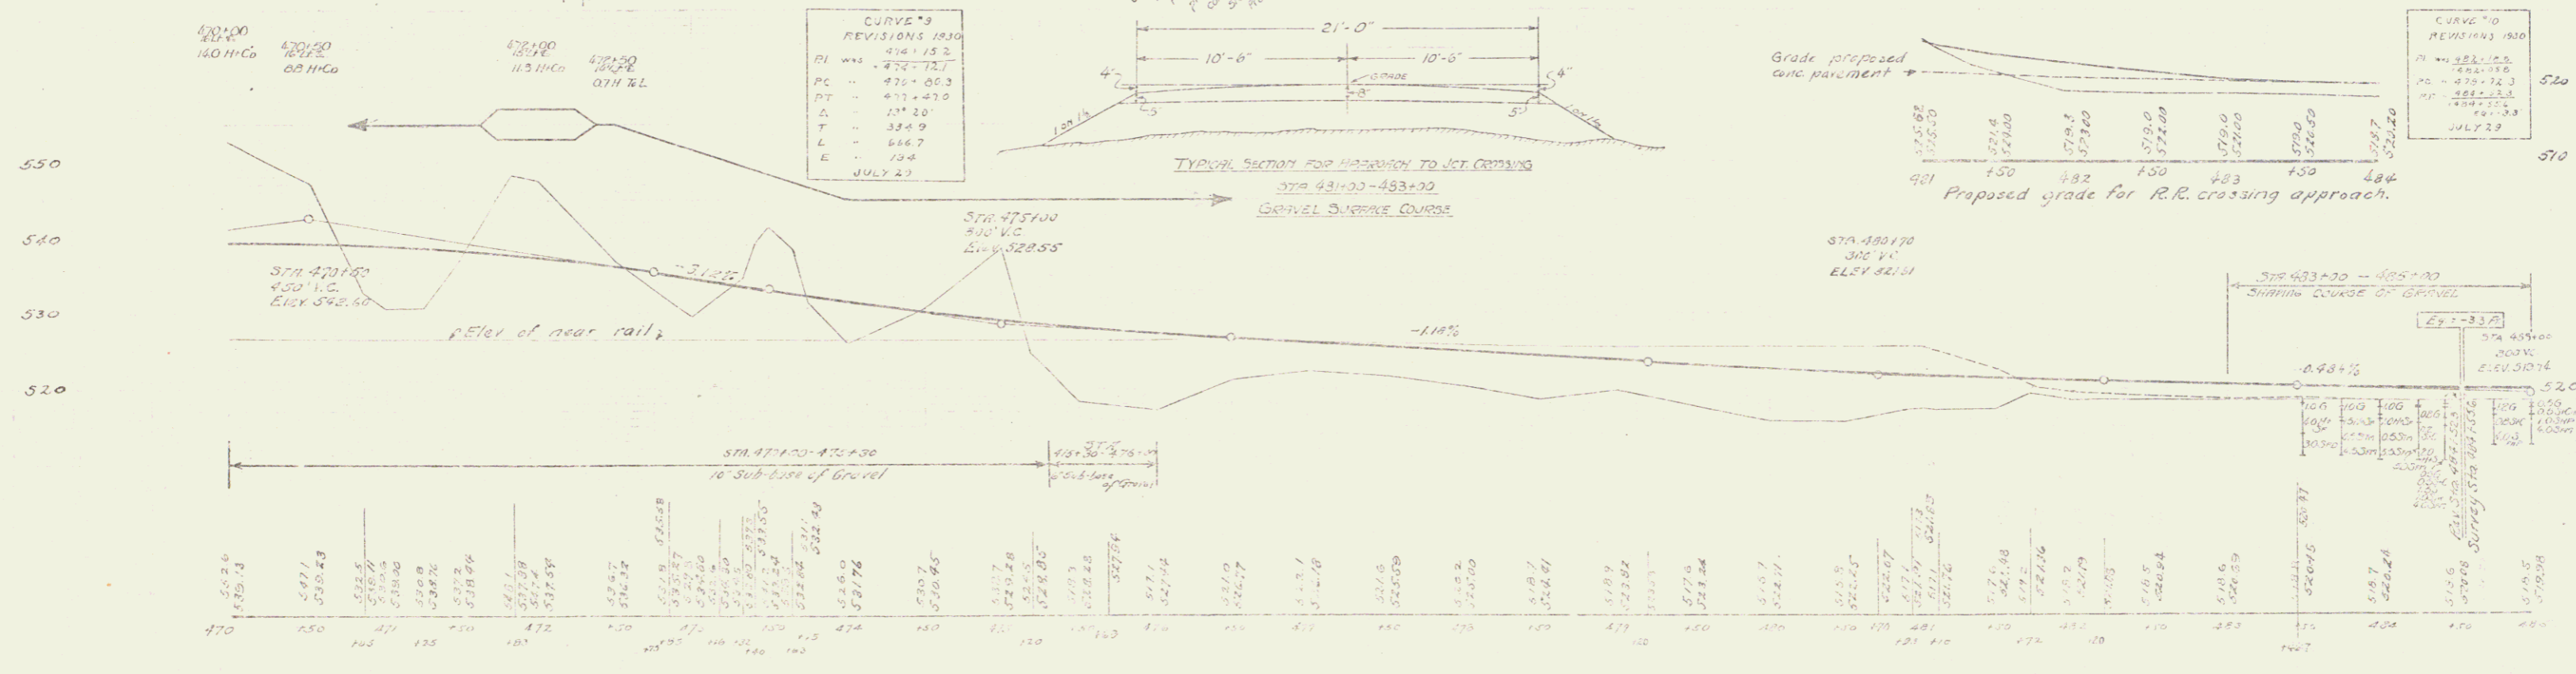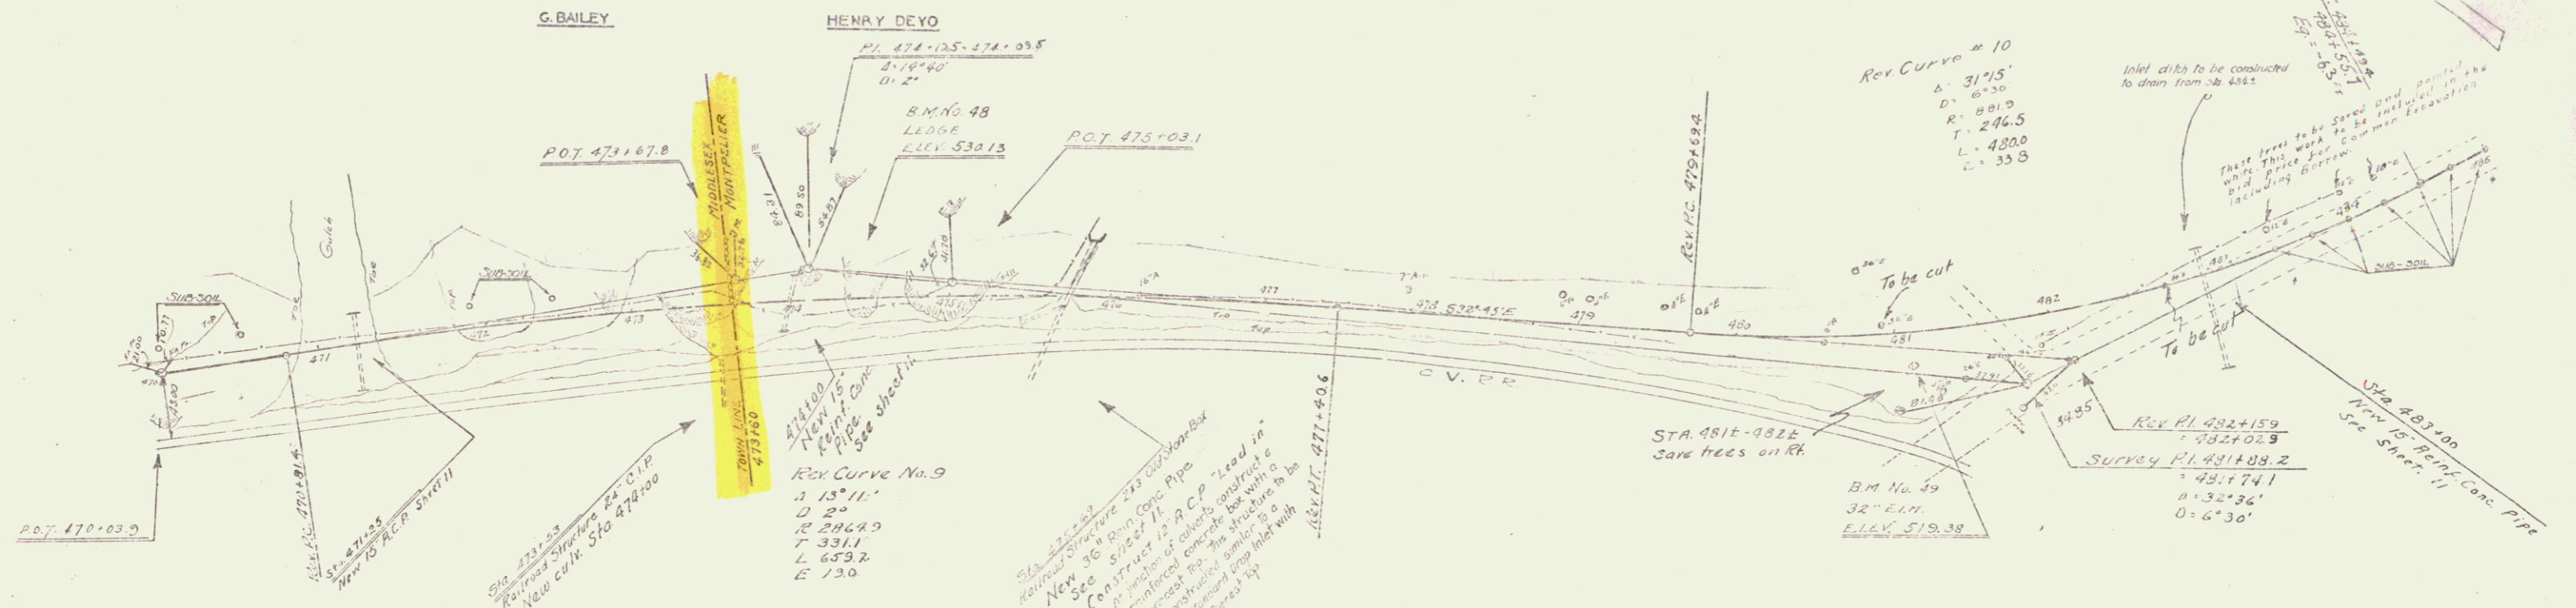

B.M. No. 48 Spot on ledge Sta 474+35 Elev 530.13  
 B.M. No. 49 Spike in end of 32\"/>