
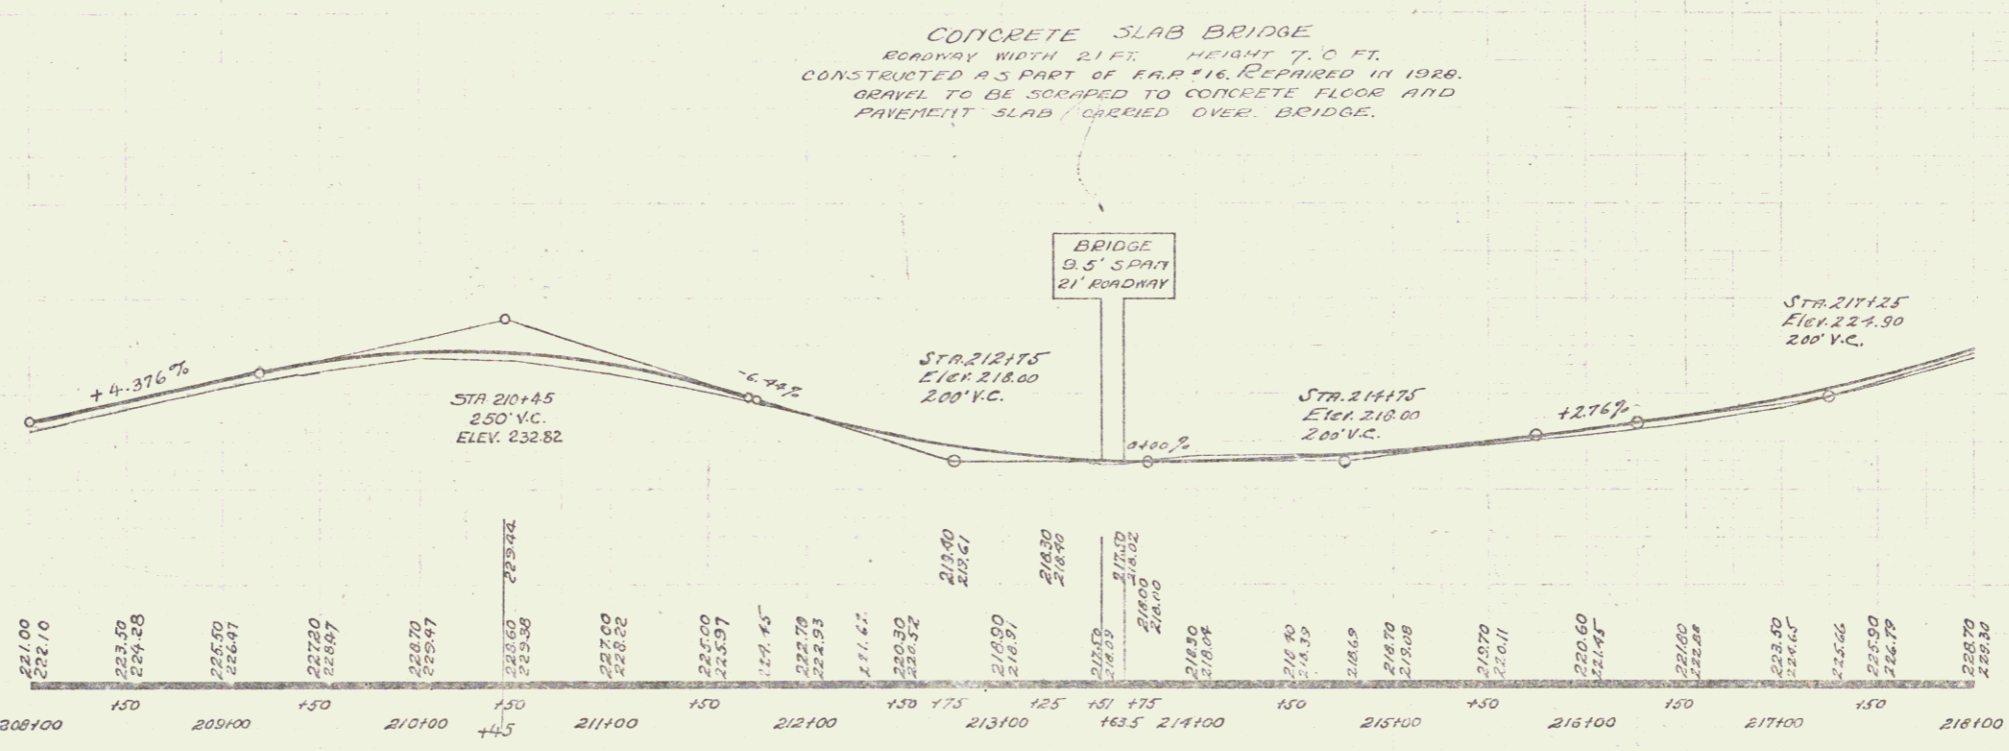


WOOD GUARD RAIL REQUIRED  
 Left  
 STA 213+27-213+57 24 FT  
 213+57-213+88 24 FT  
 Right  
 STA 213+27-213+51 24 FT  
 213+51-213+88 24 FT  
 TOTAL FOR SHEET 96 FT.

Proj. No. 1024  
 DSI No. 1024  
 State No. 1024  
 SHEET NO. 12  
 OF 17

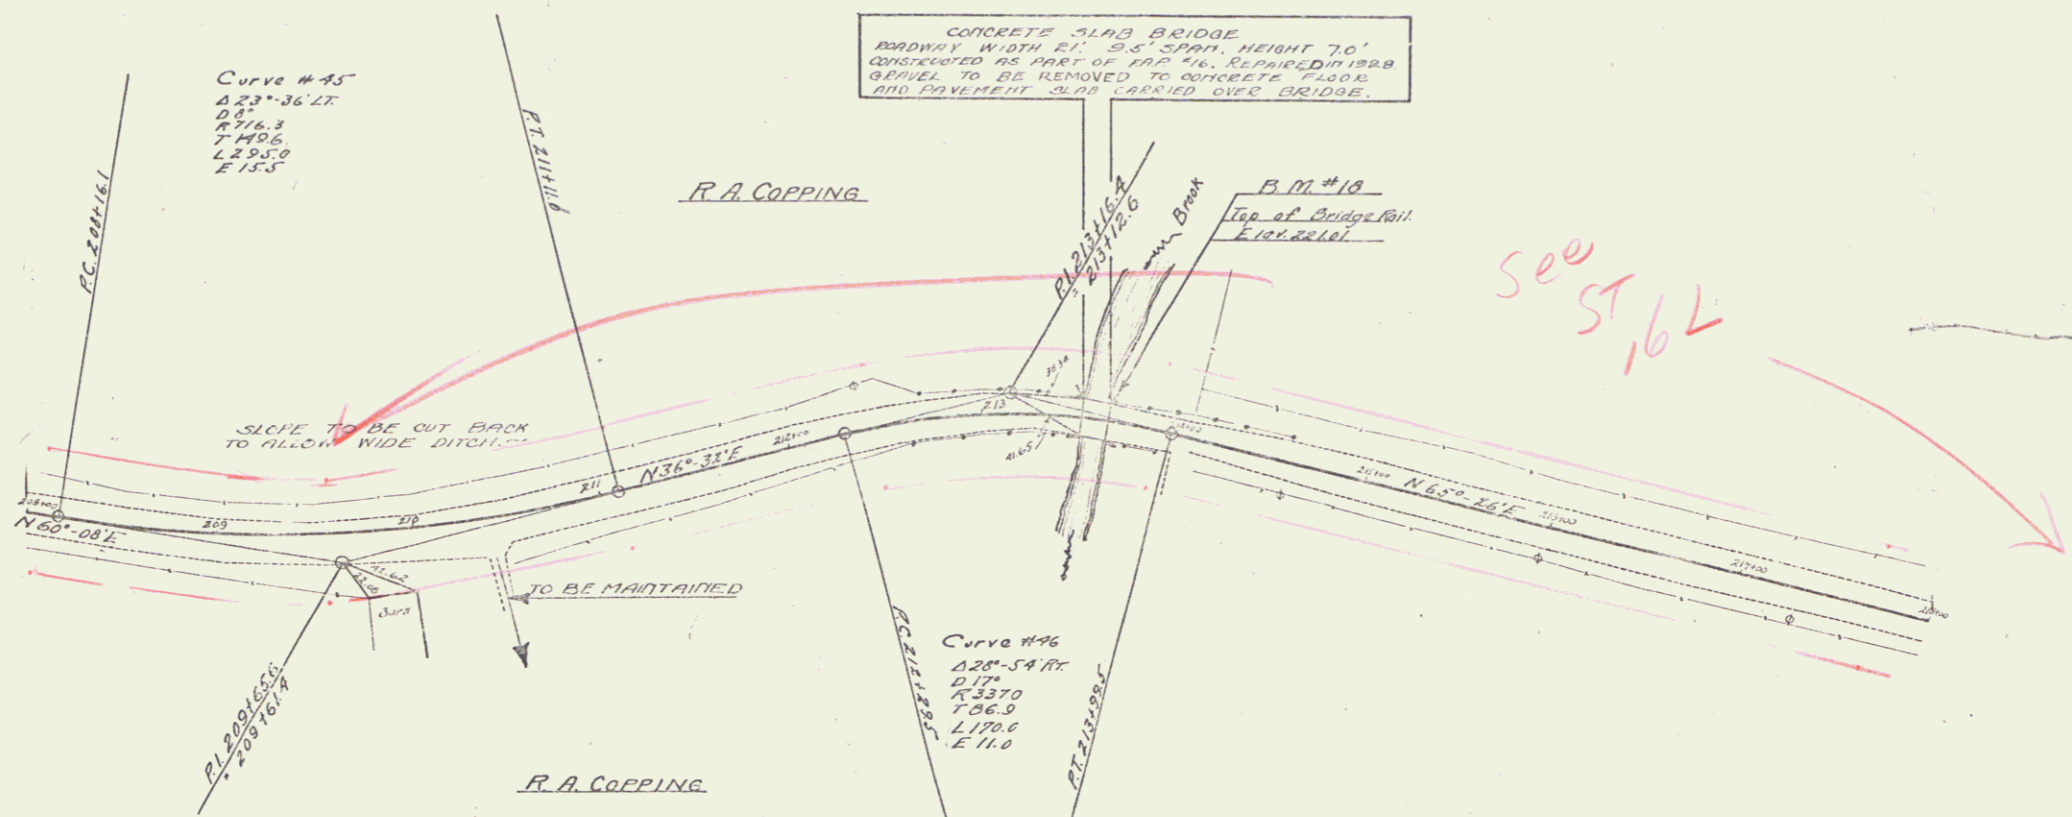

B.M. #18 Top of NE end of bridge rail Elev. 221.01

SERIES ER No. 7B  
 SHEET 12 OF 17

15