


Wind
Direction
1952
1953
1954

Wind
Dir
1952
1953
1954

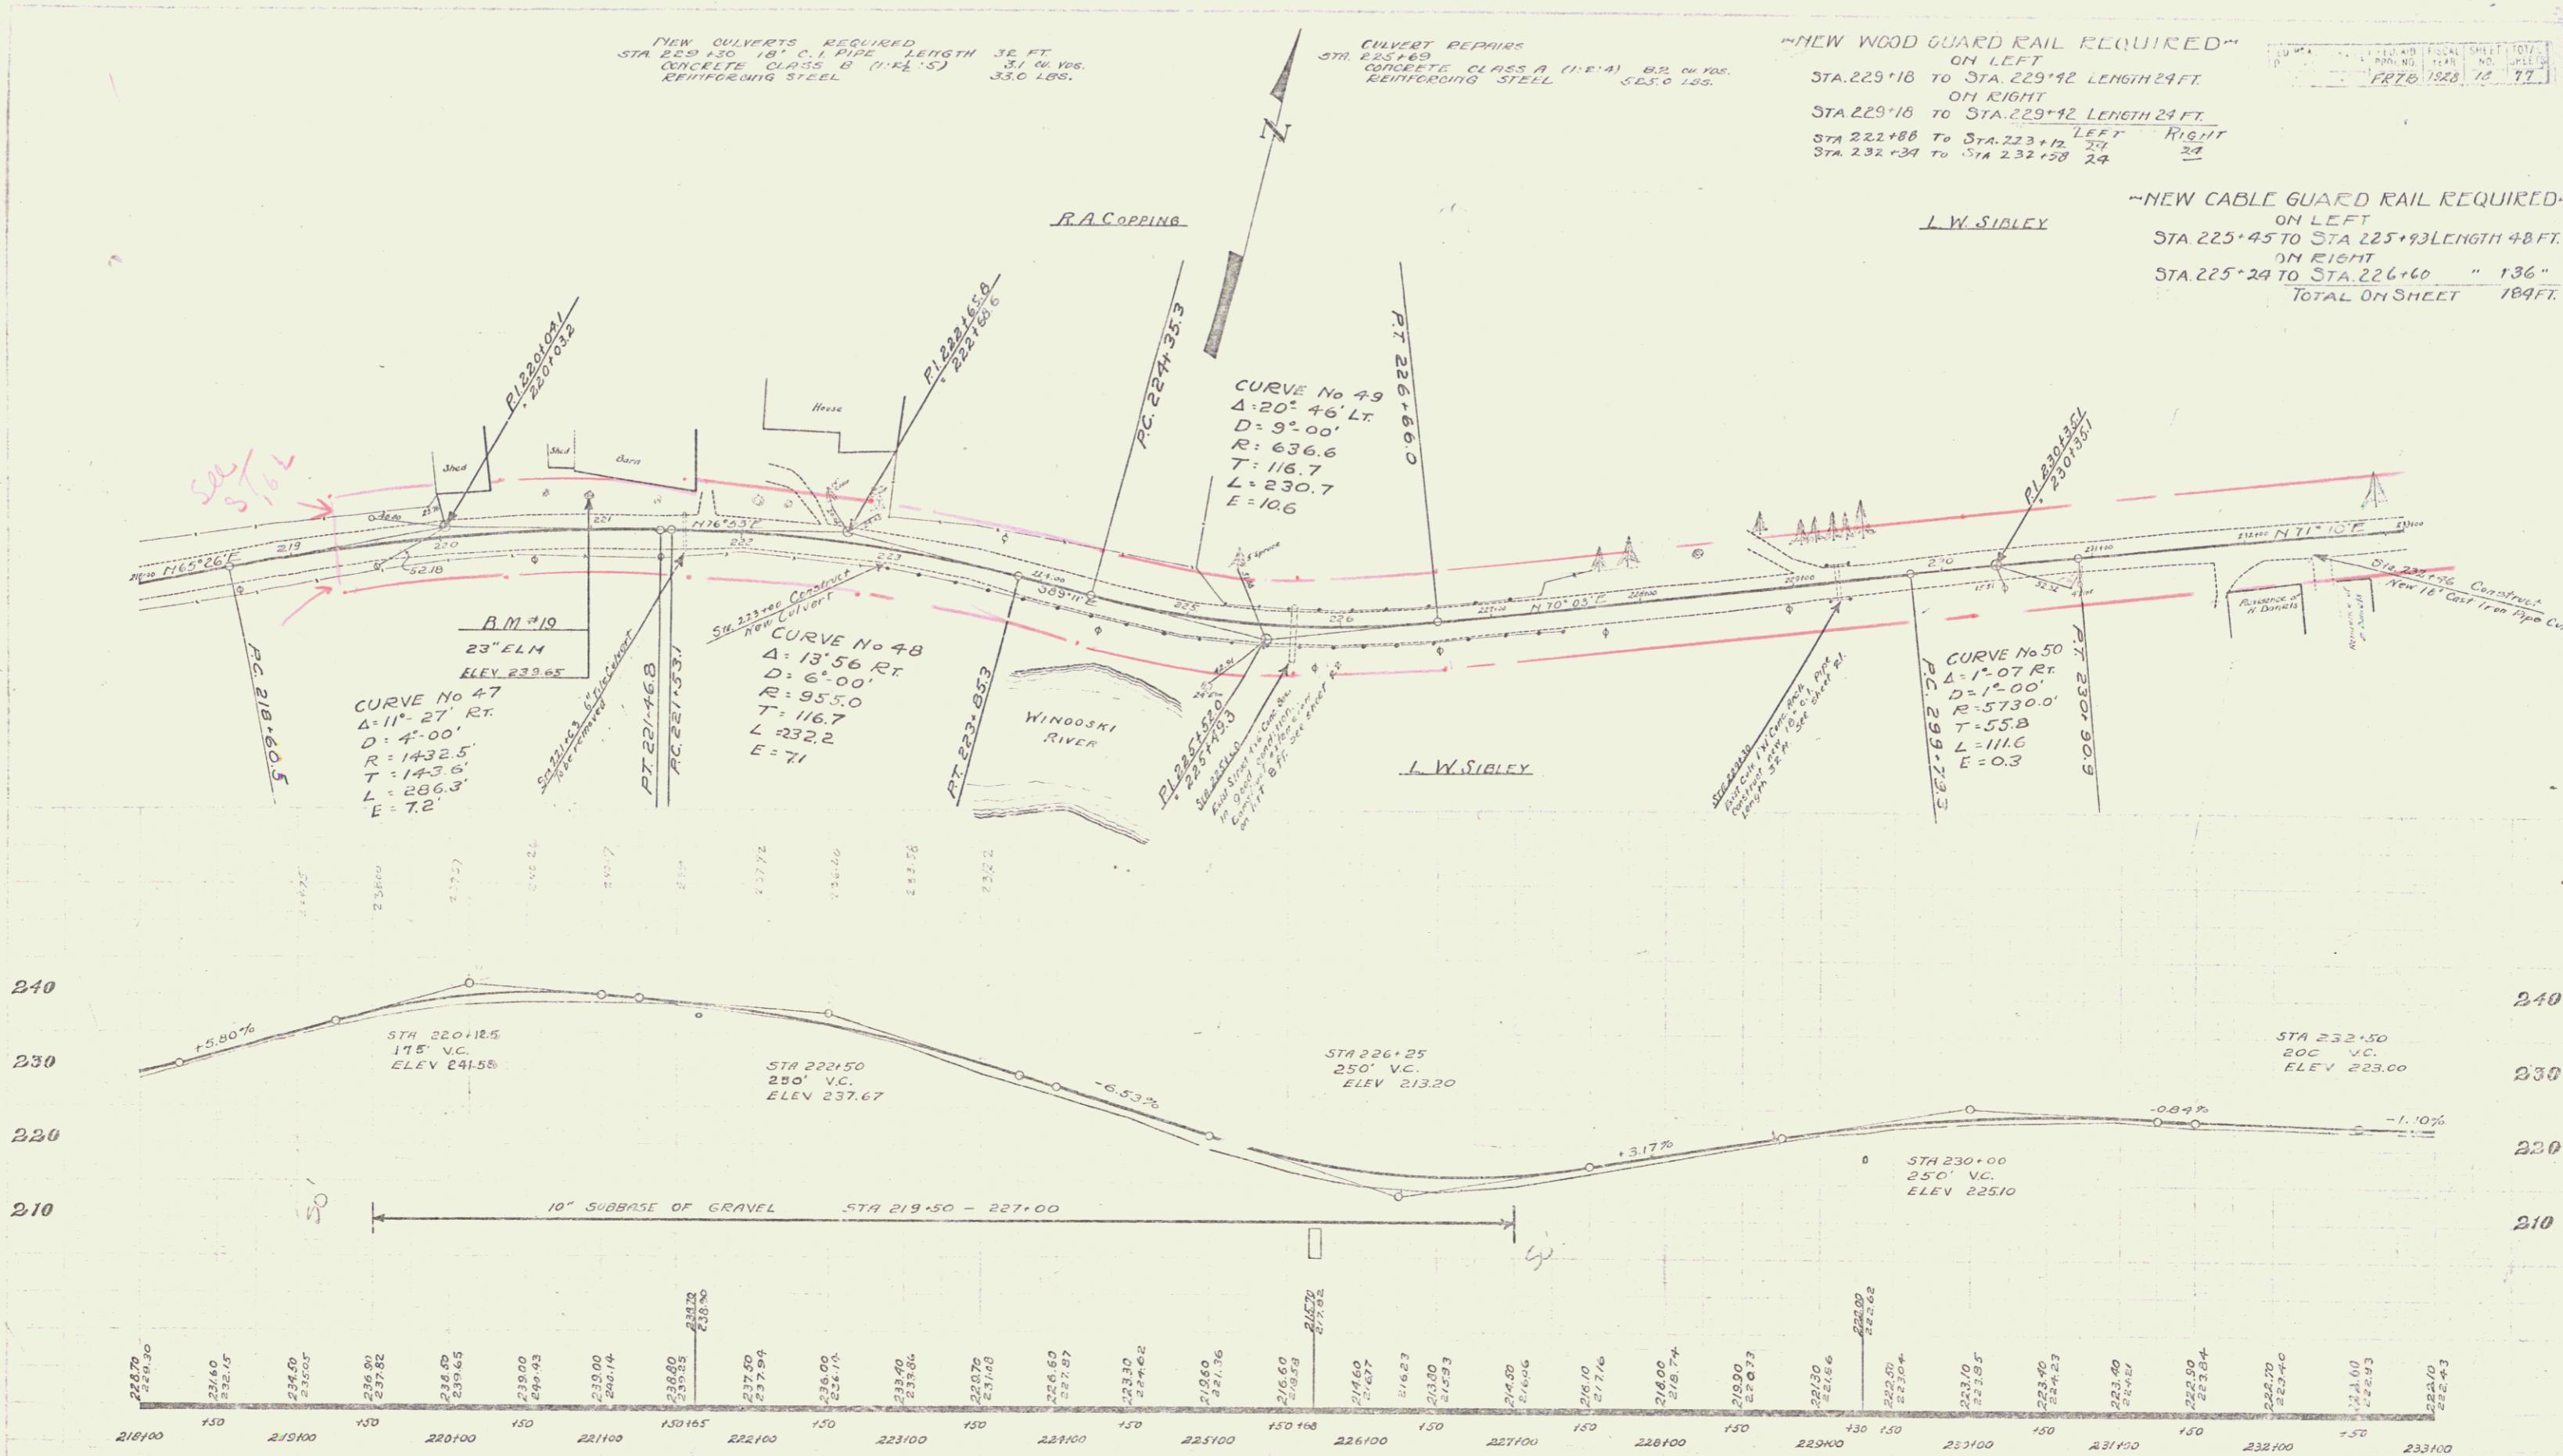

B.M.#19 Spike in roof of 23' Elm, 21.3 ft Lt. Sta 220+99, Elev 239.65'

SERIES FB No. 7B
SHEET 18 OF 77

16