


25 D ANNA A. WELCH  
 (A 3.6L) STA 1+21-9+90 SIDE LINE  
 CHANNEL RIGHTS STA 7+00-8+50 SIDE LINE  
 W.D. 8/18/55  
 REC: E.MONTPELIER BK 20 P 264  
 9/12/59

TWO CABLE GUARD RAIL WITH  
 PRESERVATIVE TREATMENT, ITEM 542  
 0+75 - 117 RT  
 3+72 - 6+98 RT  
 5+59 - 21+00 LT

TBM TOP BOLT AT  
 INLET END OF PIPE  
 ELEV. 656.34

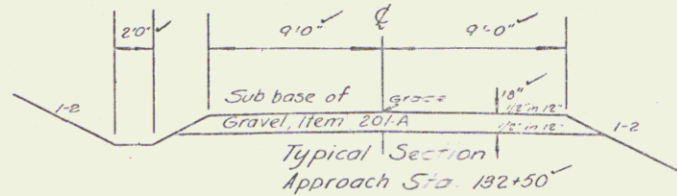

Δ 61° 30' 30" RT  
 D 15"  
 P 302.0'  
 T 227.3'  
 L 410.0'  
 E 62.7'

BERLIN - BARRE - E. MONTPELIER  
 Side Line at 132+50  
 Project No. F-028-3(2)  
 Sheet No. 17 of 171