



Parcel	Kind of Instrument	Date of Grant	Grantor	Grantee	Recorded	Remarks
A, B, C	O.C.D.	6-15-32	P.C. Lafayette	Staph. Th. 37436	6-20-32	

STANDARD UNDERDRAIN 6" P.C.G.M.P. BIT COATED  
 STATIONS: 254+23.50 - 257+20.11  
 LENGTH: 326'-11"

CEMENT RUBBLE MASONRY RETAINING WALL  
 STATIONS: 254+80 - 257+20.11  
 VOLUME: 144.9 C.Y.  
 131.9 C.Y.

GROUTED COBBLE GUTTER  
 STATIONS: 254+80 - 257+20.11  
 WIDTH: 4'-0"  
 AREA: 136.37

97-E 1932 4 4.5

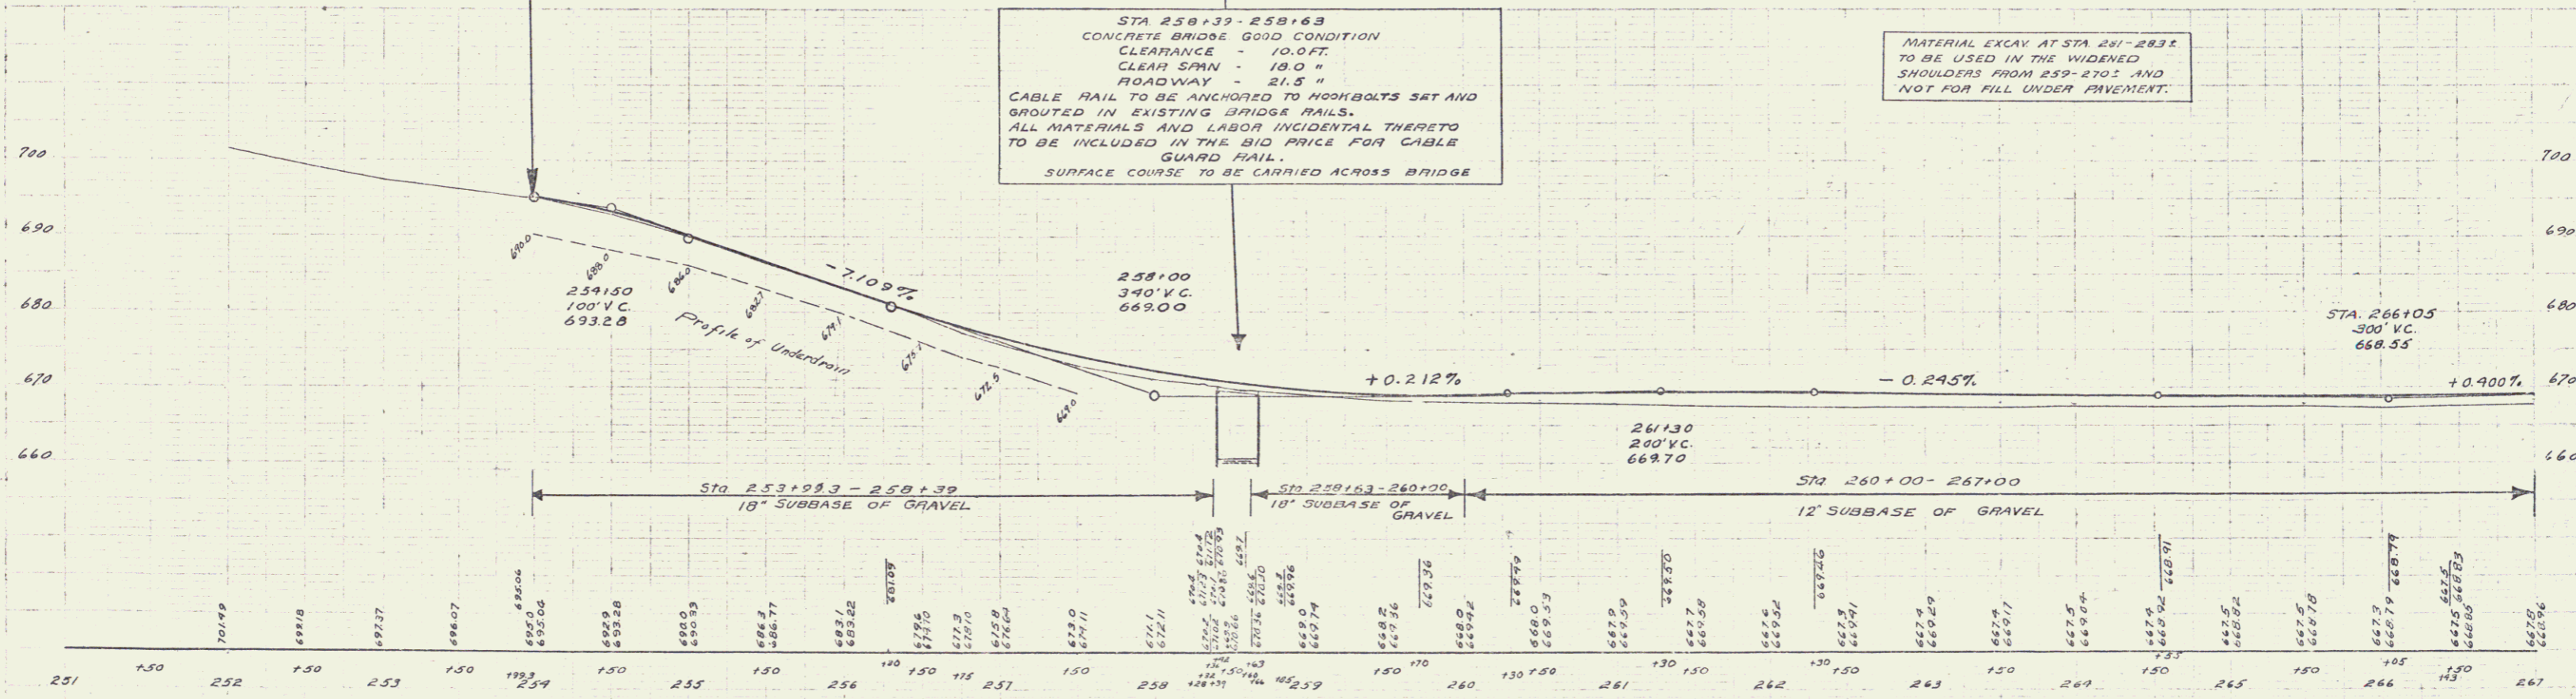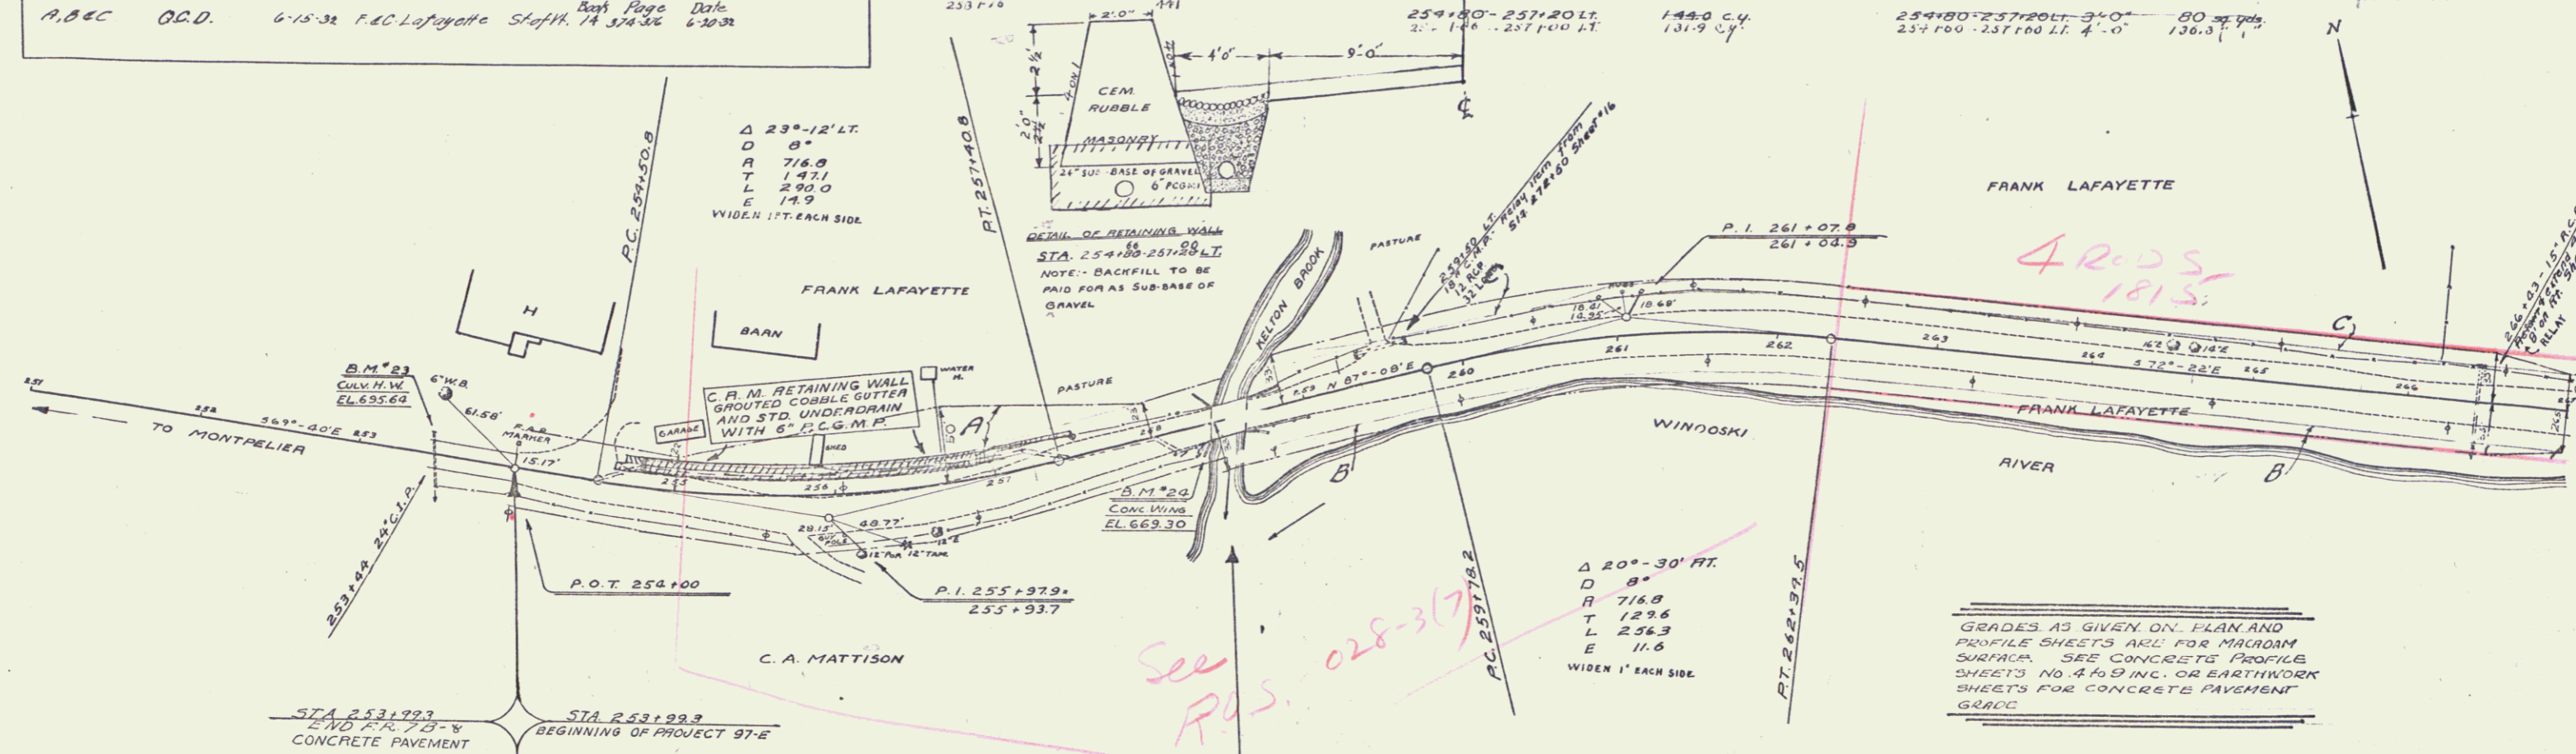

B.M. #22 PAINT SPOT ON CONC. GAS PUMP FDN. ELEV. 701.66  
 B.M. #23 PAINT SPOT ON CONC. CULV. H.W. 14.2 FT. LT. STA. 253+44. ELEV. 695.64  
 B.M. #24 PAINT SPOT ON CONC. WING OF BRIDGE 13.5 FT. RT. STA. 250+29. ELEV. 669.30

SERIES F- No 97-E  
 SHEET 4 OF 4.5