
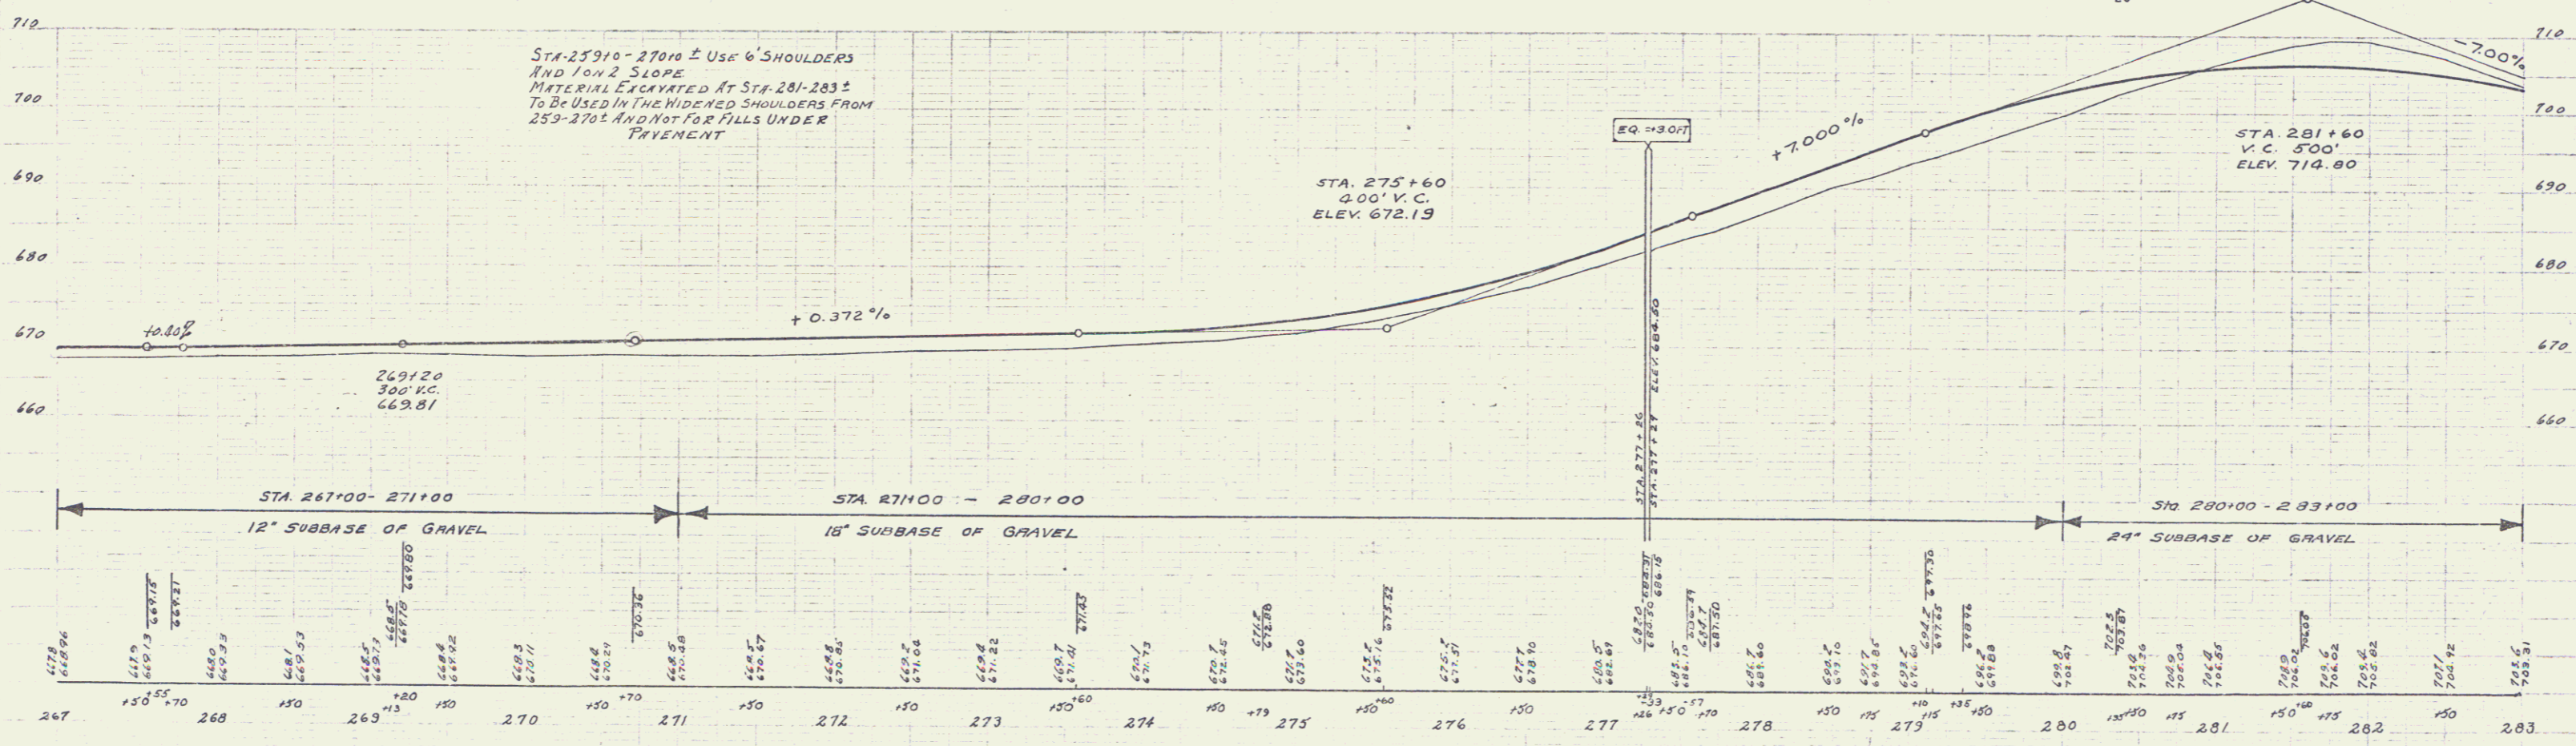


Parcel	Kind of Instrument	Date of Instrument	Grantor	Grantee	Recorded Book Page Date	Remarks
D	Q.C.D.	6-15-32	F.C. Lafayette	Staf. H. W.	373-374 6-15-32	
D	"	6-14-32	D.M. Taylor	"	373-374 6-14-32	

CEMENT RUBBLE MASONRY RETAINING WALL
 Station - Station Volume
 279+75 - 283+10 LT. 200 cu. yd

GROUTED COBBLE GUTTER
 Station - Station Width Area
 279+75 - 283+10 LT. 3'-0" 149 sq. yds.

DATE 9-7-1932
 SHEET 5 OF 5

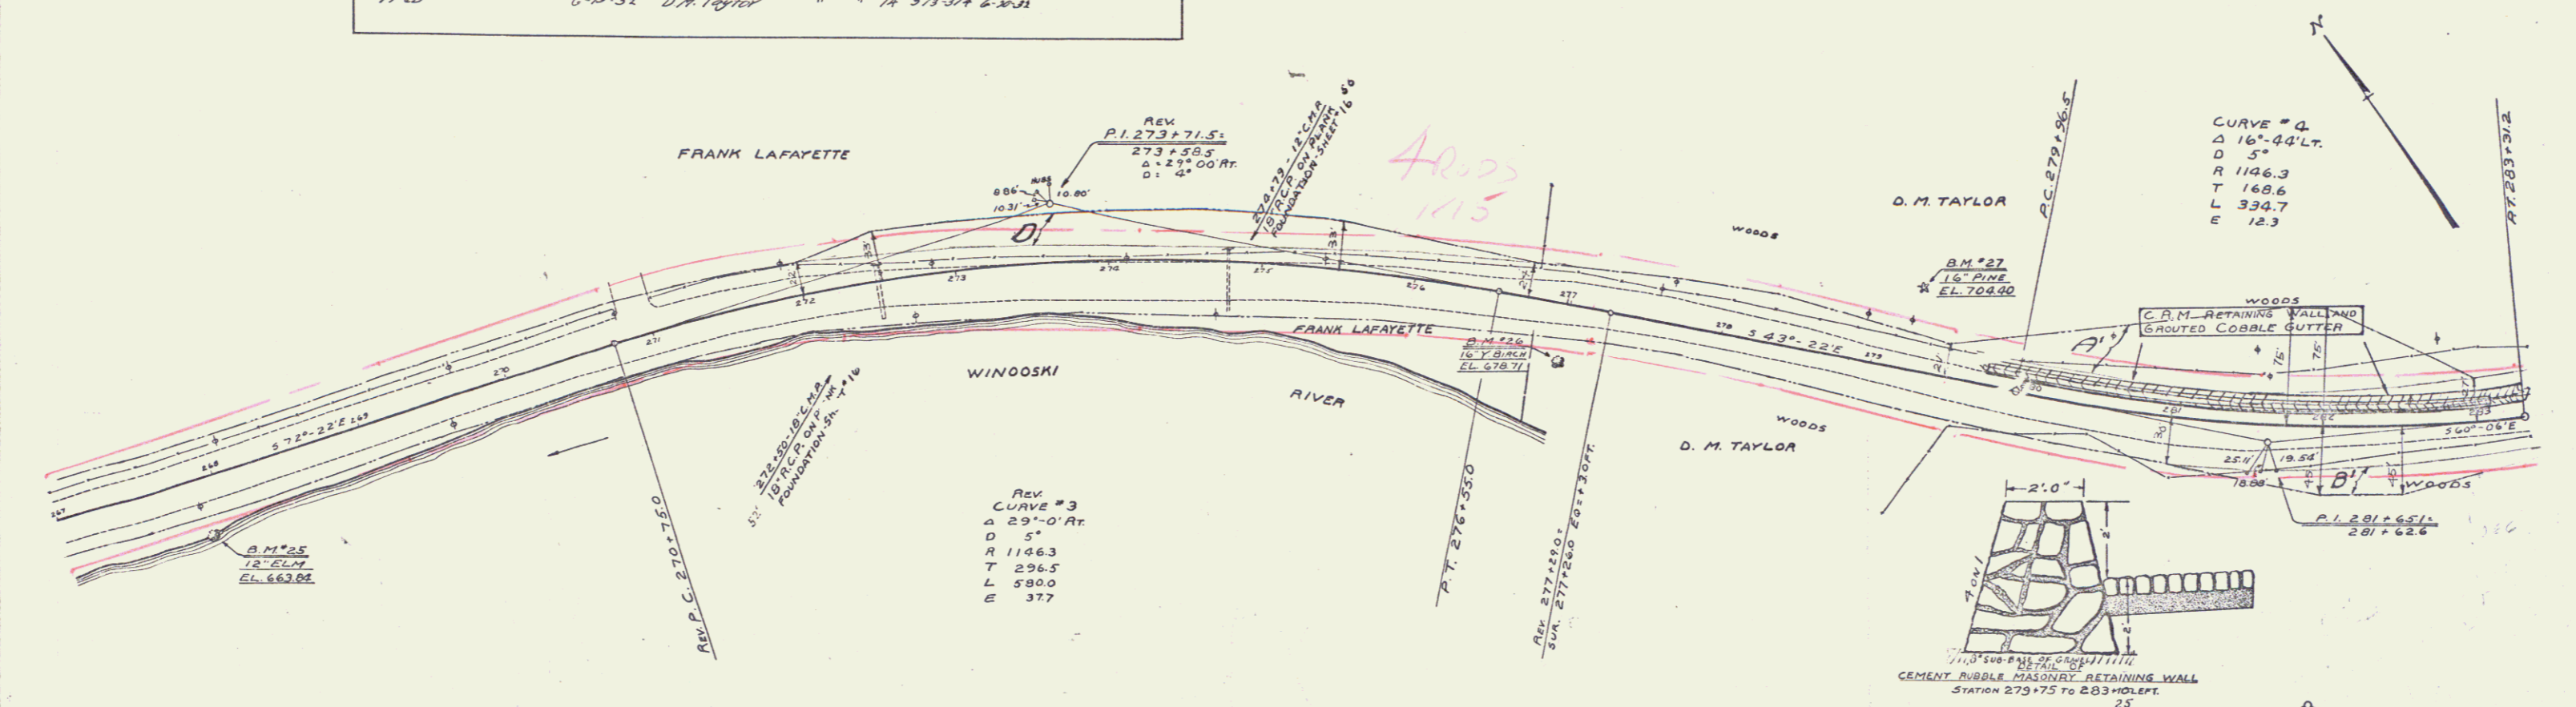

B.M. #25 SPIKE IN ROOT 12" ELM 37.5 FT. AT STA. 267+00 ELEV. 663.84
 B.M. #26 SPIKE IN ROOT 16" Y. BIRCH 36 FT. AT STA. 276+30 ELEV. 679.71
 B.M. #27 SPIKE IN ROOT 16" PINE 33 FT. LT. STA. 279+26.0 ELEV. 704.40

SERIES F. No. 97-E
 SHEET 5 OF 5