


STATION 318+81.4 = 16+50 OF PROJECT 97-C
 BEGINNING OF GOVERNMENT PARTICIPATION
 AND PROJECT 97-E.

REVISIONS
 MAY 10, 1932.
 STA 320+50 LT. 12' P.C. LENS 54 FT.
 ORIGINALLY CALLED "STATION"
 NO LONGER REQUIRED.
 LENS 92' FT. TO BE CONSTRUCTED
 INSTEAD AT STA. 321+75.
 NOT CONSTRUCTED

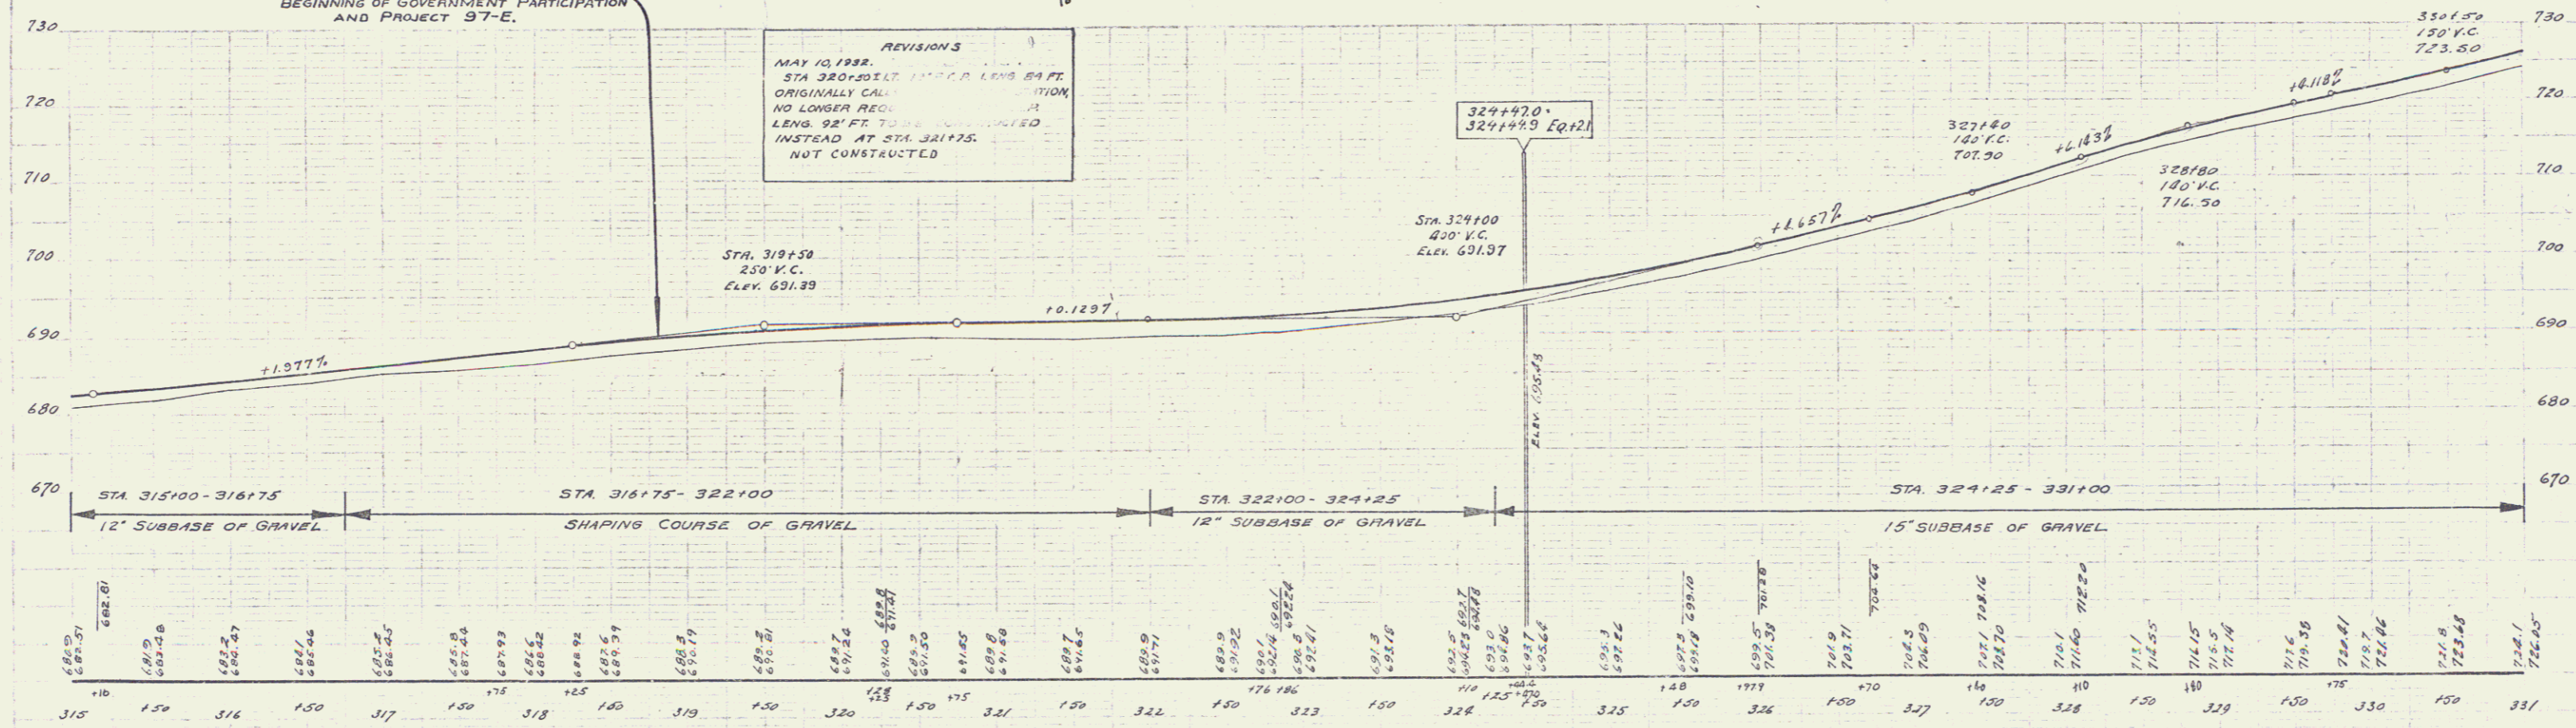

STA 315+00 - 316+75 STA 316+75 - 322+00 STA 322+00 - 324+25 STA 324+25 - 331+00

12" SUBBASE OF GRAVEL SHAPING COURSE OF GRAVEL 12" SUBBASE OF GRAVEL 15" SUBBASE OF GRAVEL

682.01	681.51	681.01	205.51
--------	--------	