
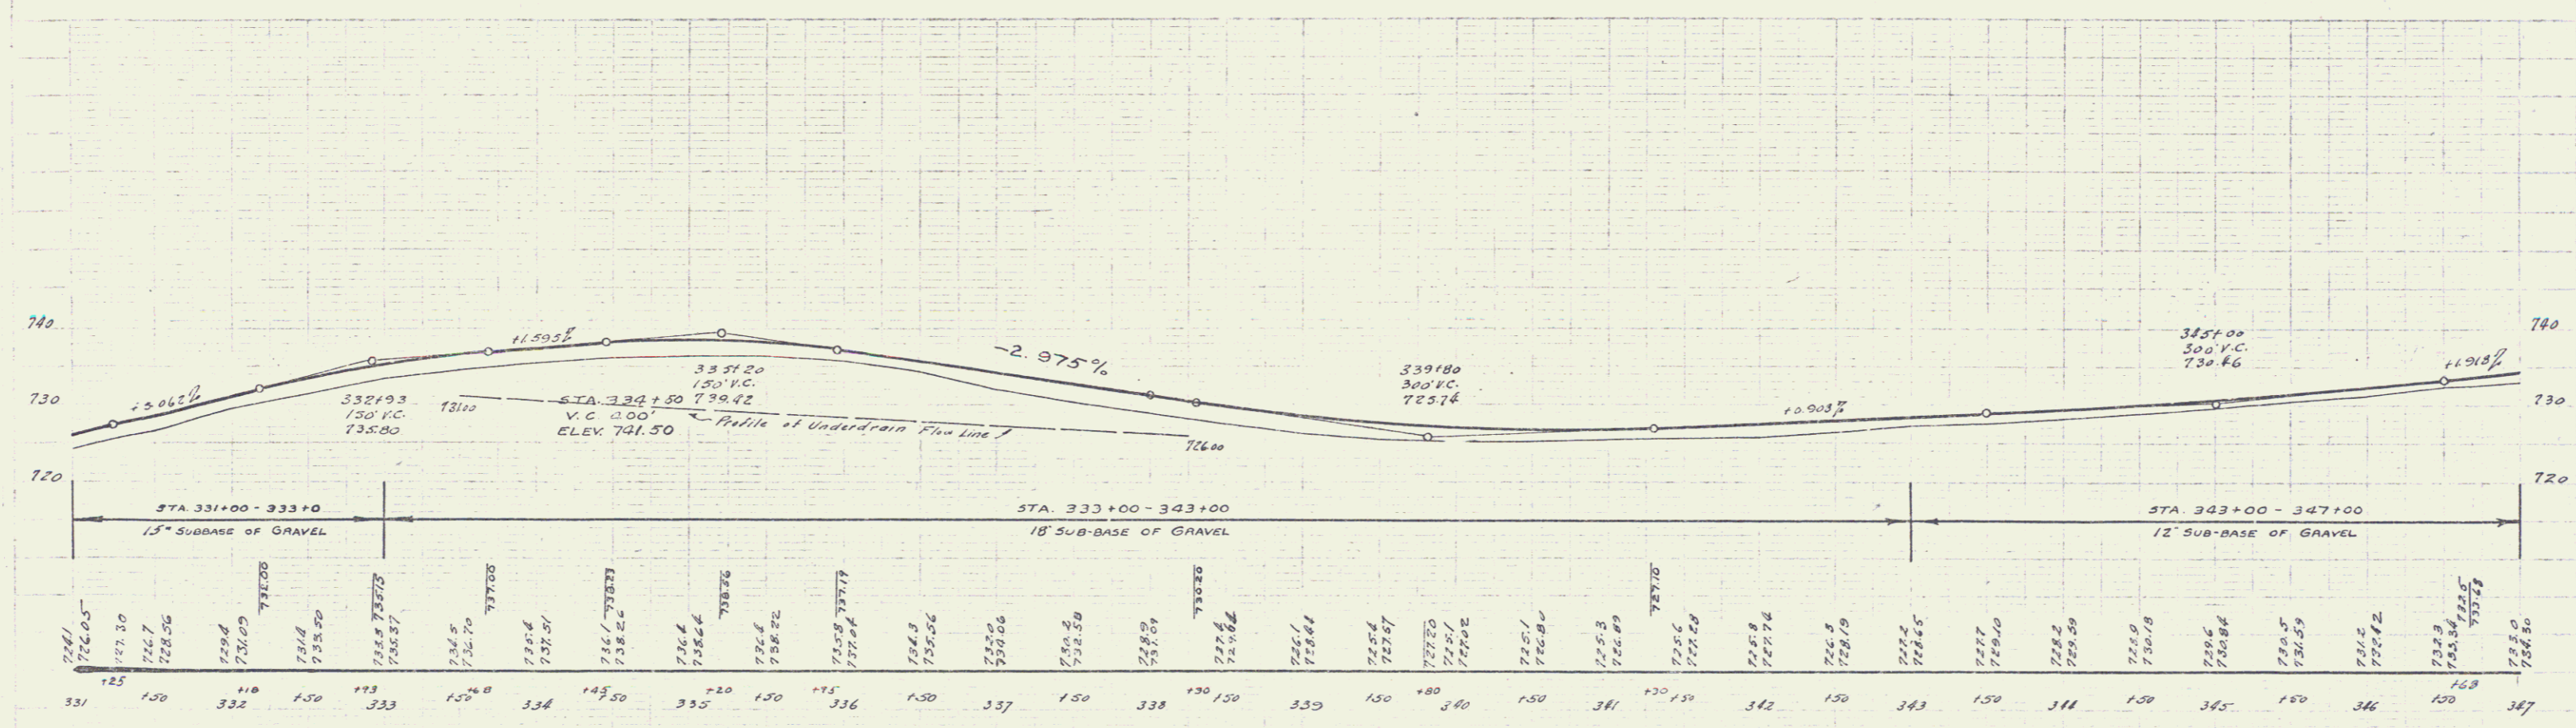


STANDARD UNDERDRAIN WITH 6 P.C.G.M.P. BIT COATED

STA.	TO STA.	LENGTH
333+50	338+25	475'
		469'

97-E 1932 9 65

Parcel	Kind of Instrument	Date of Instrument	Grantor	Grantee	Recorded	Remarks
Ch. #1872	Q.C.D.	6-15-32	M.C. & F.M. Cutler	Staff	14-320-571	6-30-32, Ch. 56, 58, 59, 60, 99, 100

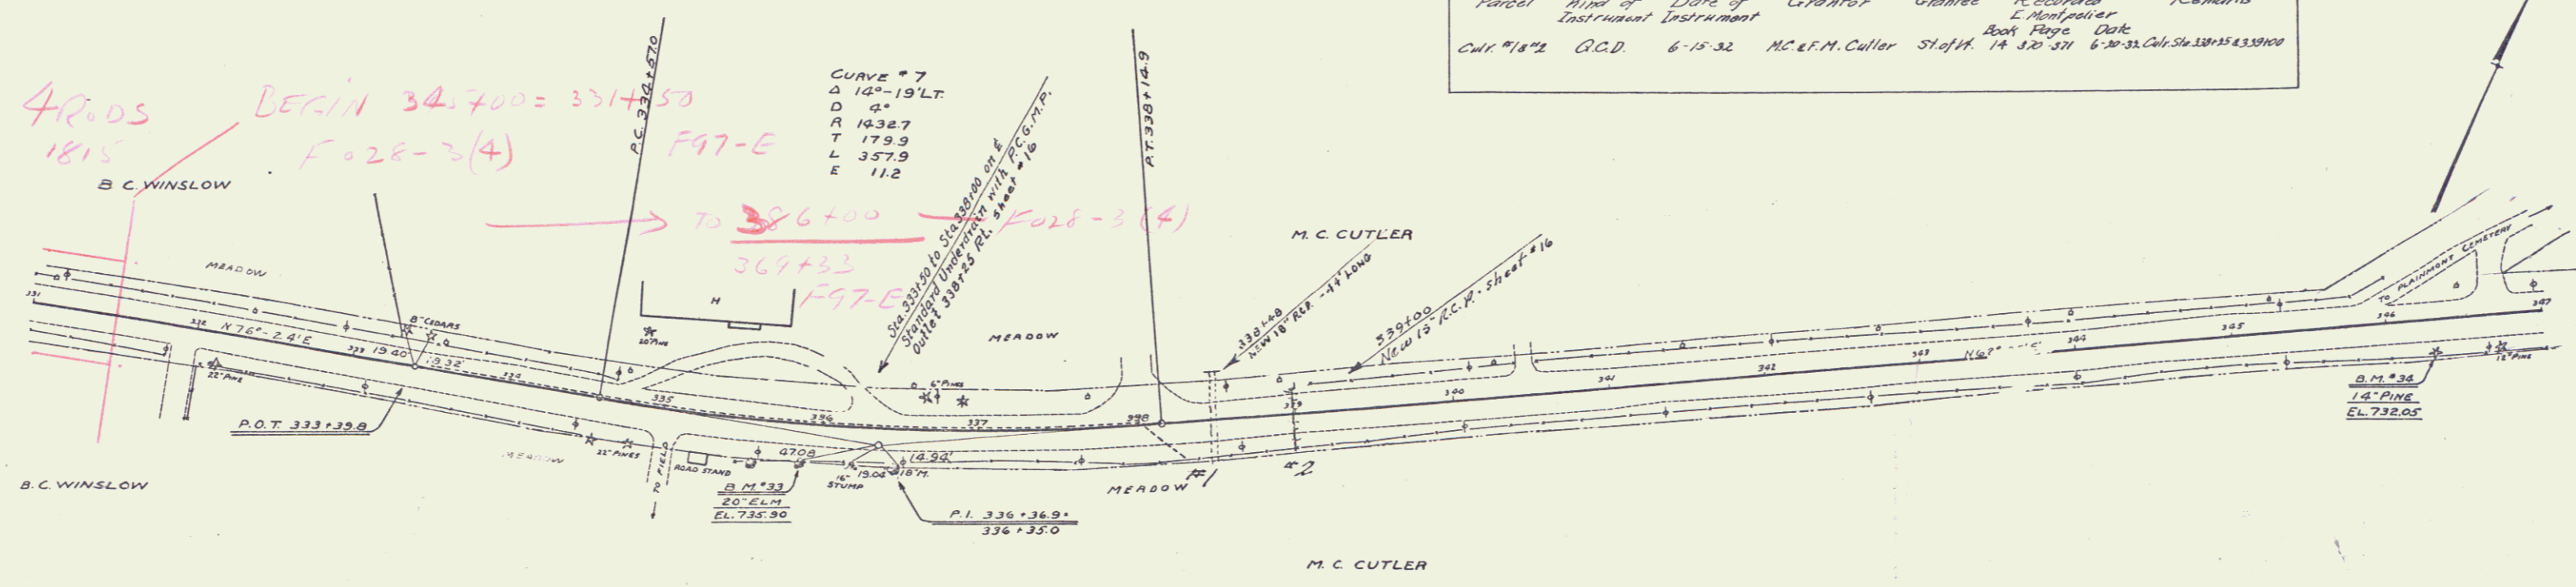

B.M. #33 SPIKE IN ROOT 20' ELM 22 FT. RT. STA 335+90 ELEV 735.90  
 B.M. #34 SPIKE IN ROOT 14' PINE 14 FT. RT. STA 346+30 ELEV 732.05

SERIES F-AG 97-E  
 SHEET 15 OF 15

7