
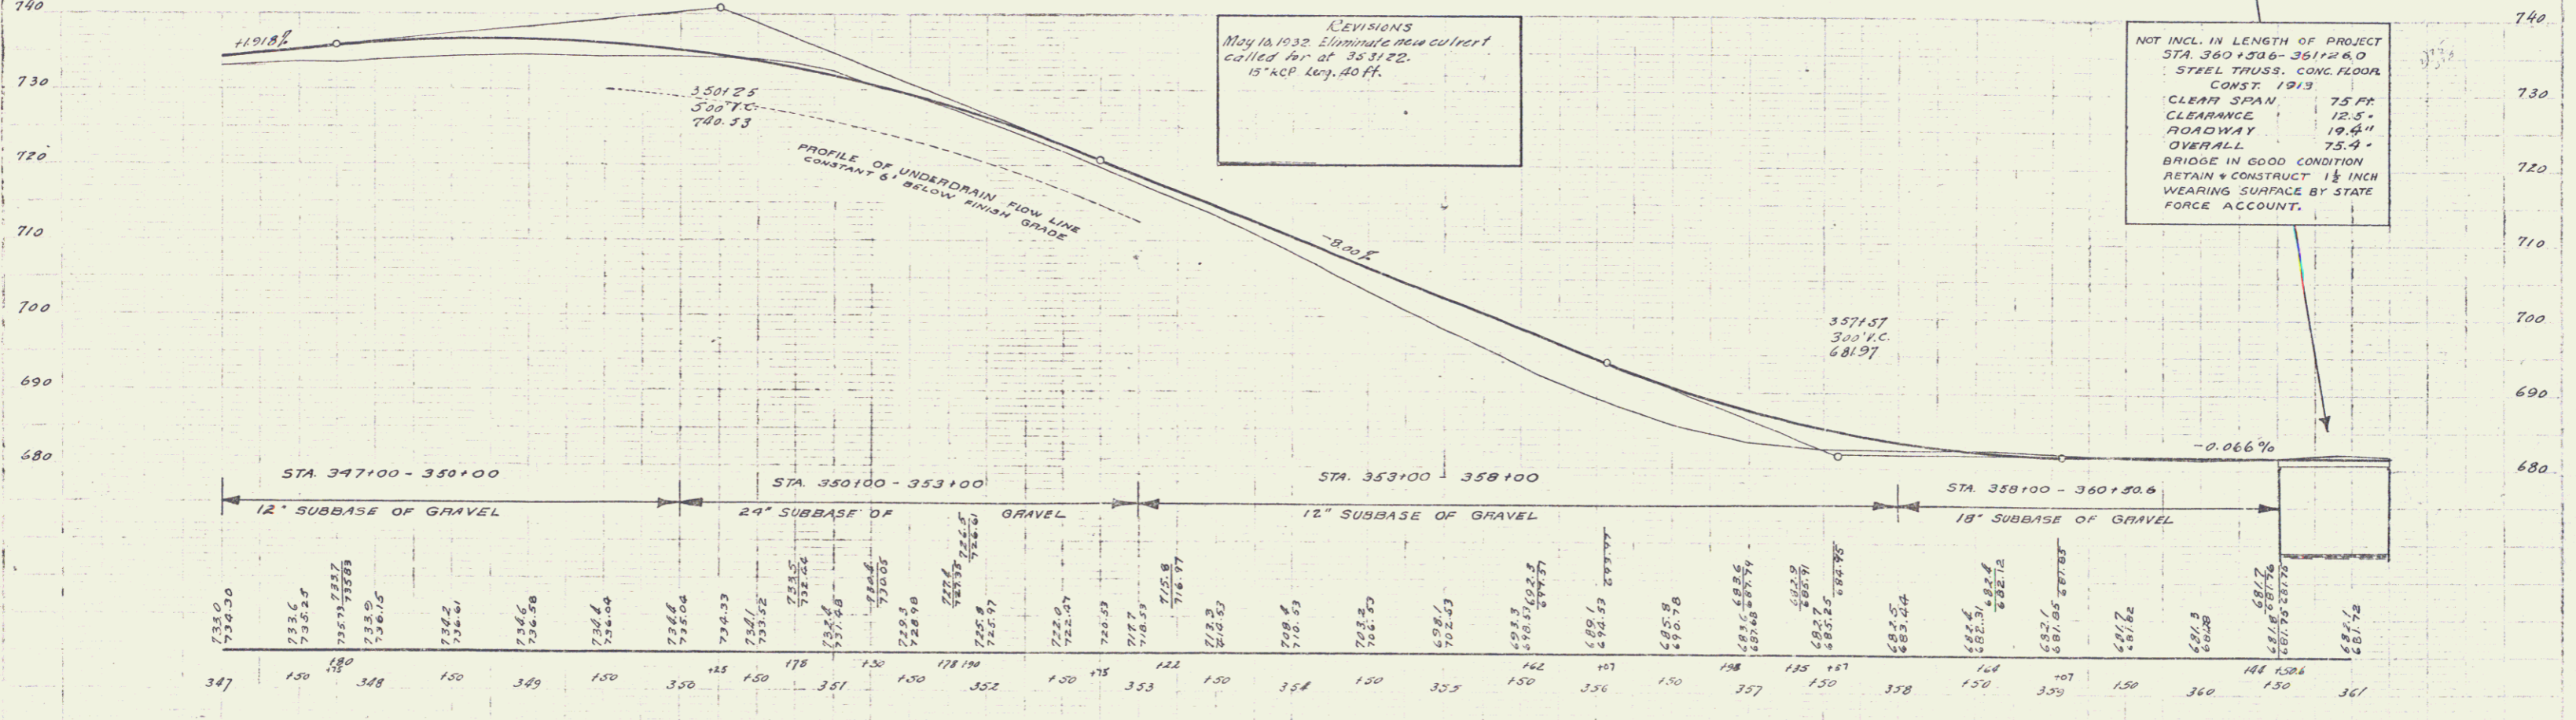


Parcel	Kind of Instrument	Date	Grantor	Grantee	Recorded Book Page	Remarks
A, C&B #3	Q.C.D.	6-15-32	NO. 47N Cutler	Staff	18 570-571	6-20-32 Dr. Outlet 353100
A #8	"	6-20-32	FR & S. Coburn	"	14 363-370	6-20-32
A #8	"	6-20-32	FR & S. Coburn	"	13 340-341	6-20-32 Plainfield

STANDARD UNDERDRAIN WITH 6" P.C.G.M.P. BIT COATED	
STATIONS	LENGTH
347+50 - 353+00 E	330'
349+51 - 352+75 E	338'

97-E 1932 10 46

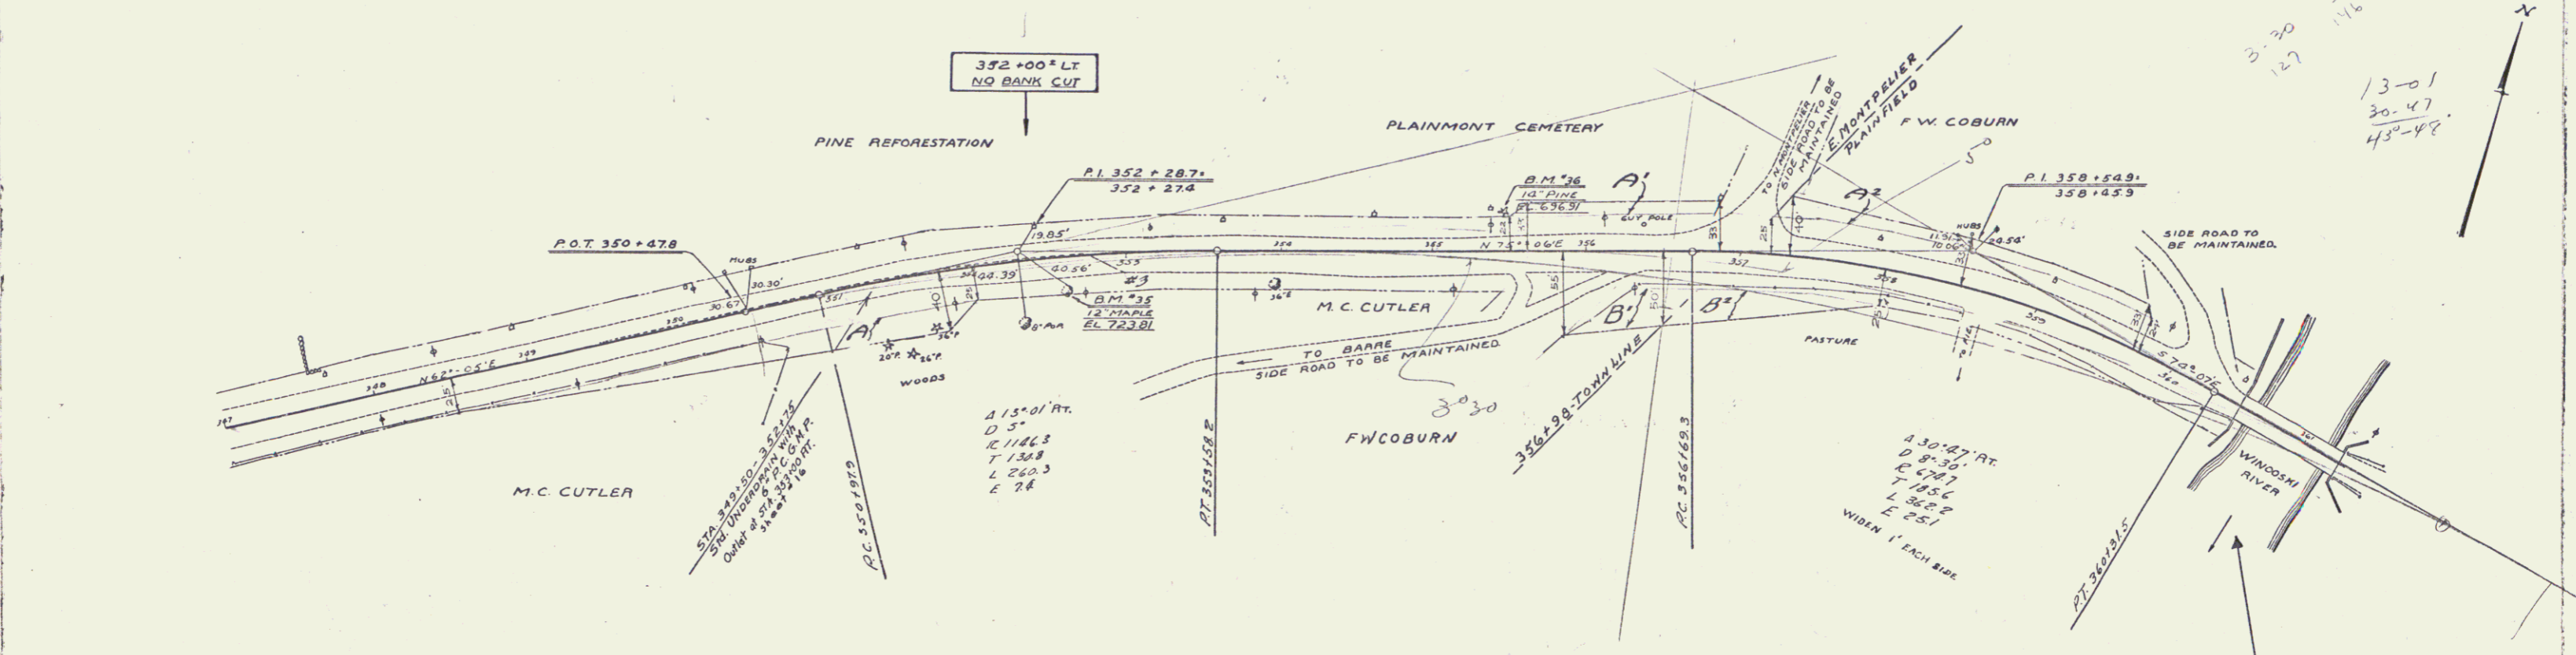

B.M. # 35 SPIKE IN TRUNK 12" MAPLE 19 FT. AT STA. 352+59 ELEV. 723.01
 B.M. # 36 SPIKE IN ROOT 10" PINE 23 FT. LT. STA. 353+46 ELEV. 696.91

SERIES F-10 97-E
 SHEET 10 OF 45

8