
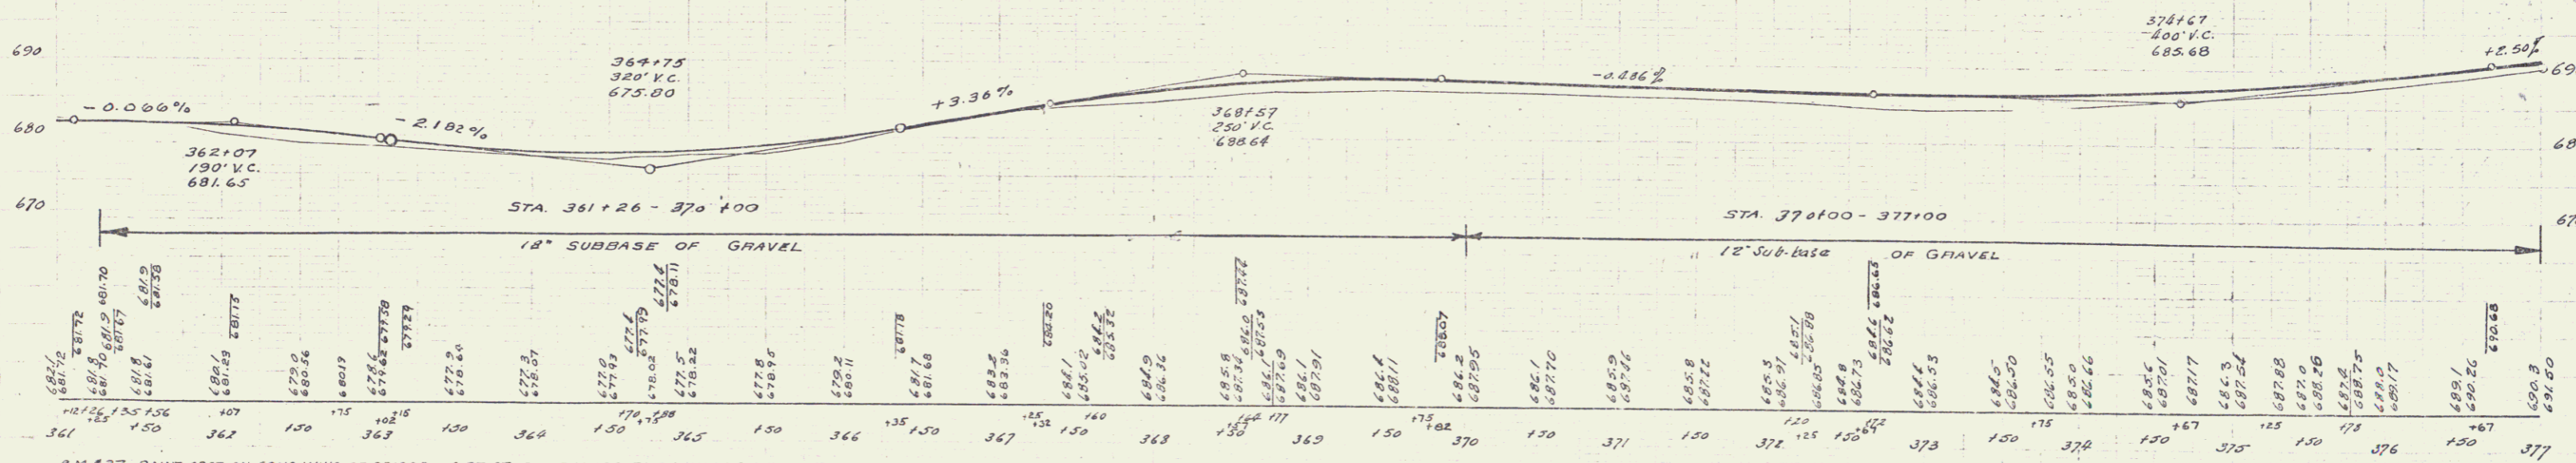


Parcel	Kind of Instrument	Date of Grant	Grantor	Grantee	Recorded Platfield Date	Remarks
C140	C.C.D.	6-10-32	FR. & S. COBURN	STOFFA	13 Jan 34	67302

97-E 1932 11 45

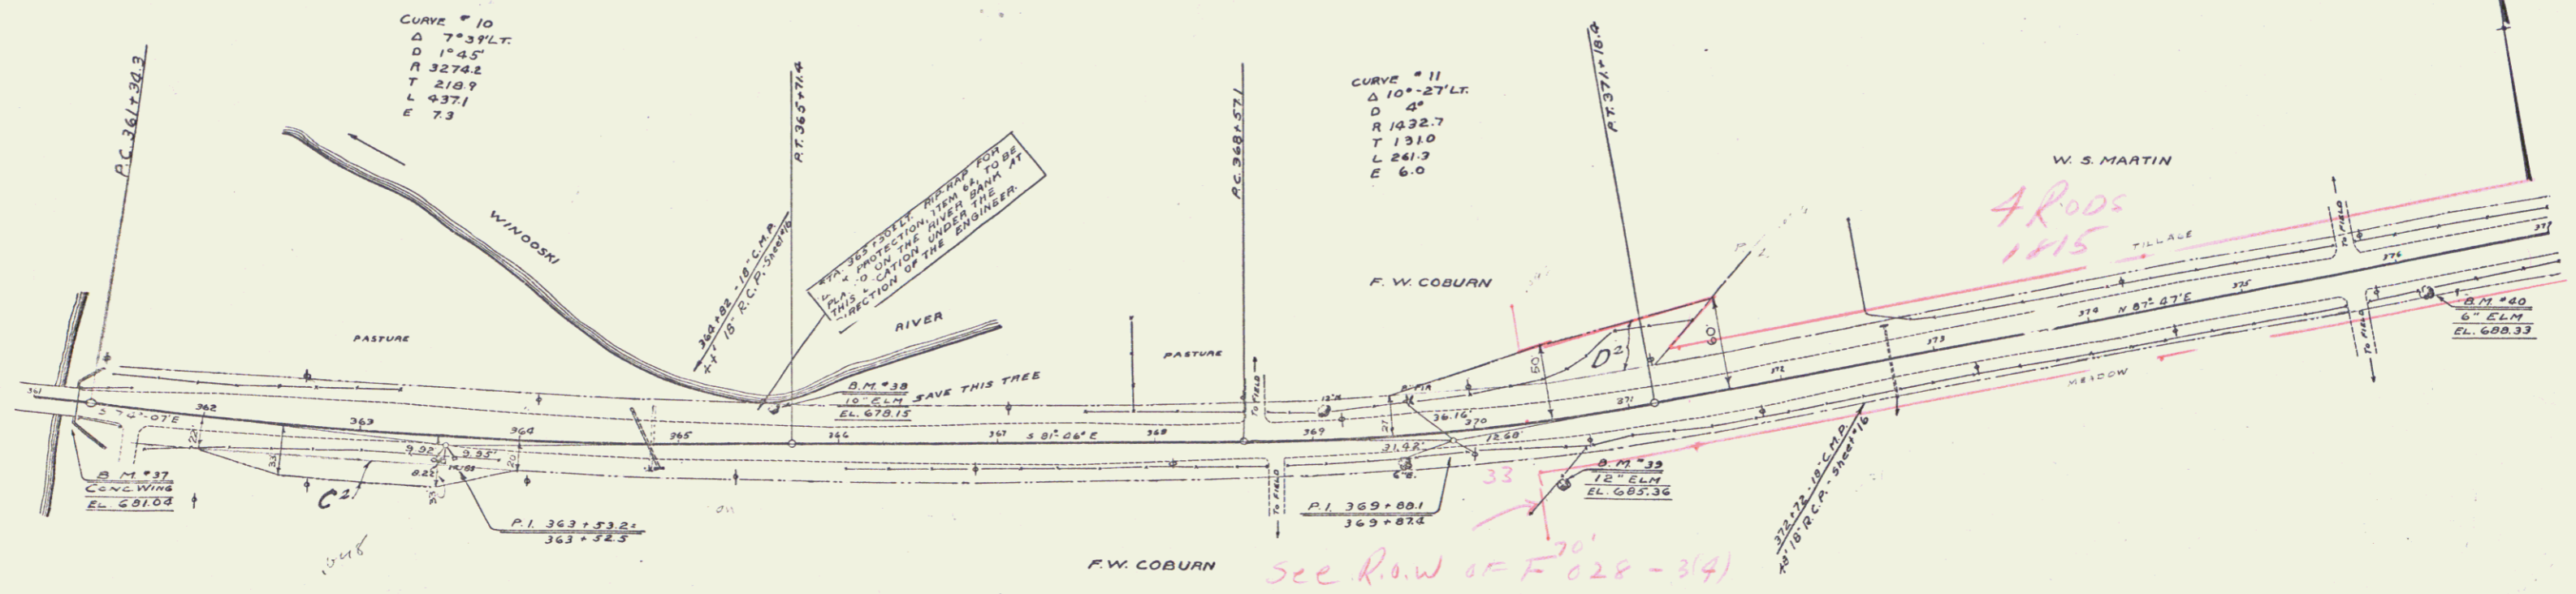

B.M. #37 PAINT SPOT ON CONC WING OF BRIDGE 14 FT AT STA. 361+26 ELEV. 681.04  
 B.M. #38 SPIKE IN ROOT 10" ELM 22 FT LT. STA. 365+40 ELEV. 678.15  
 B.M. #39 SPIKE IN ROOT 12" ELM 30 FT AT STA. 370+53 ELEV. 685.36  
 B.M. #40 SPIKE IN TRUNK 6" ELM 19.5 FT AT STA. 376+170 ELEV. 688.33

SERIES F-No 97E  
 SHEET 7 of 45

9