
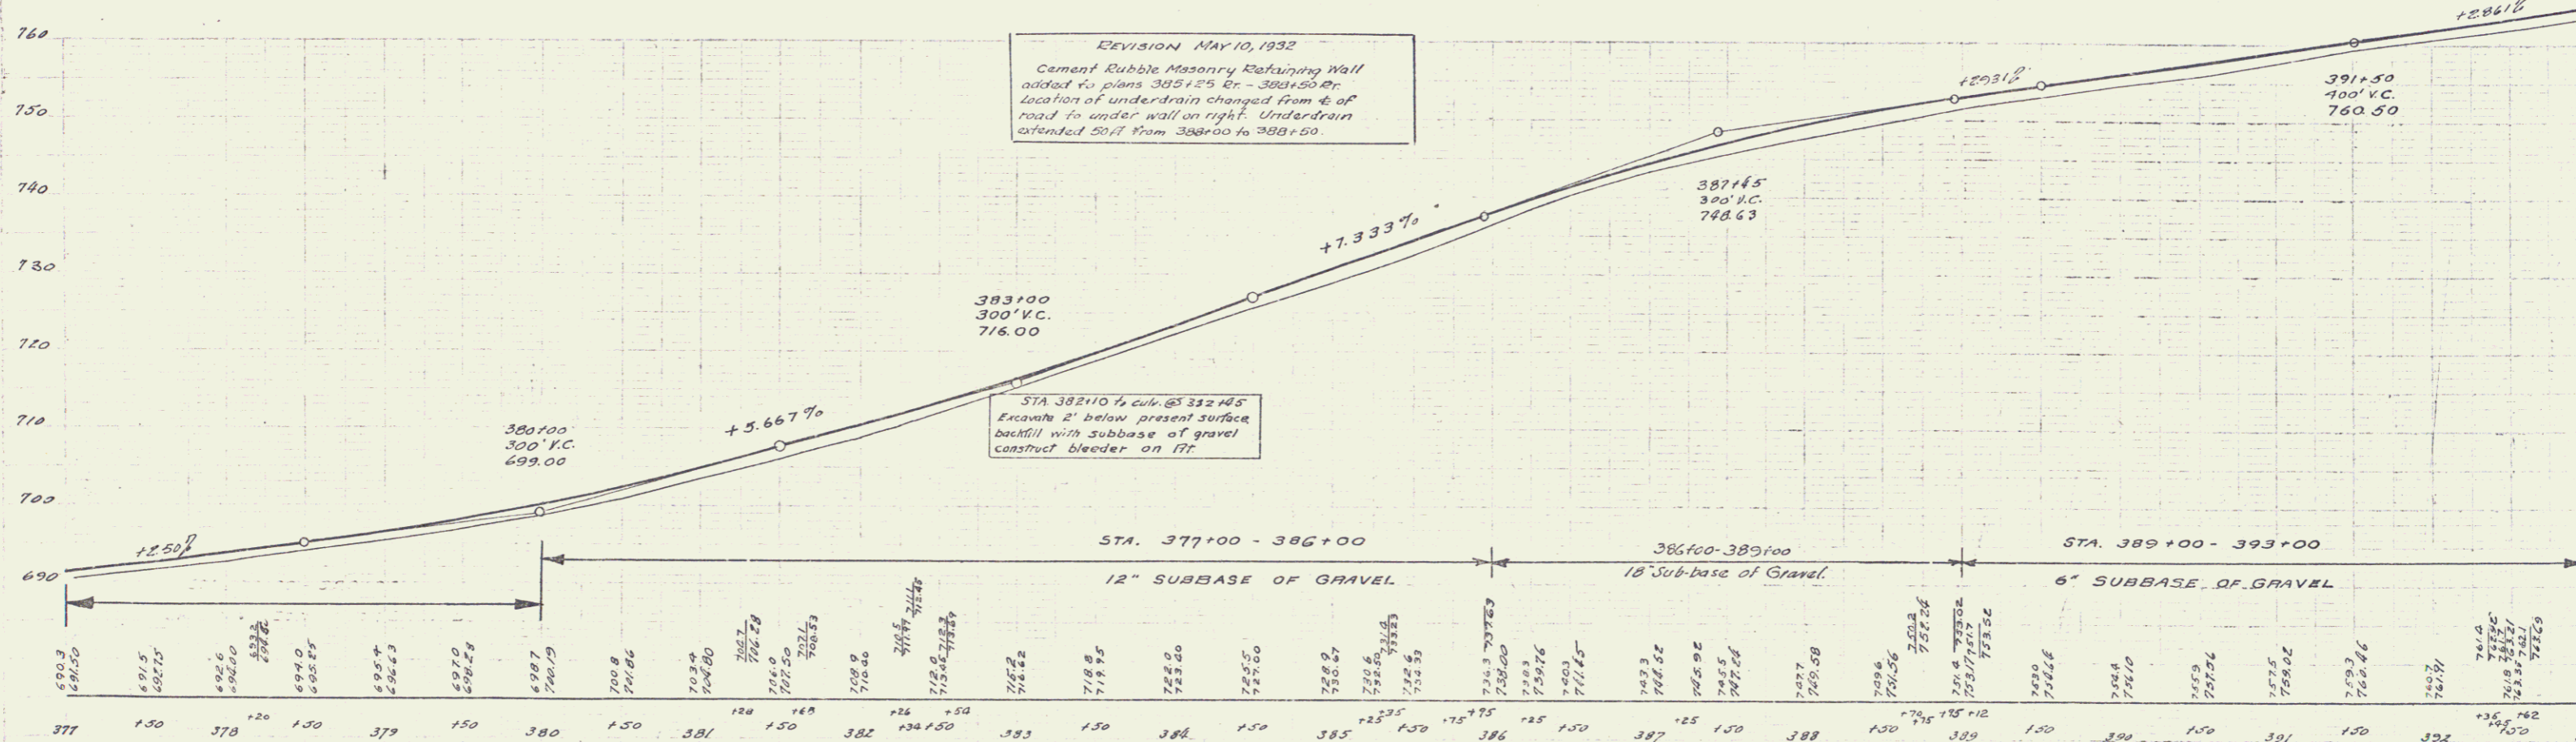


CEMENT CONC. GUTTER
 STATIONS WIDTH CONC. A STEEL
 387+17-387+37.4 4.0 3.0 CY

GROUTED COBBLE GUTTER
 STATIONS WIDTH AREA
 385+20-388+50 RT 3.0' 118.7 SQ. YD

97-E 1932 12 45

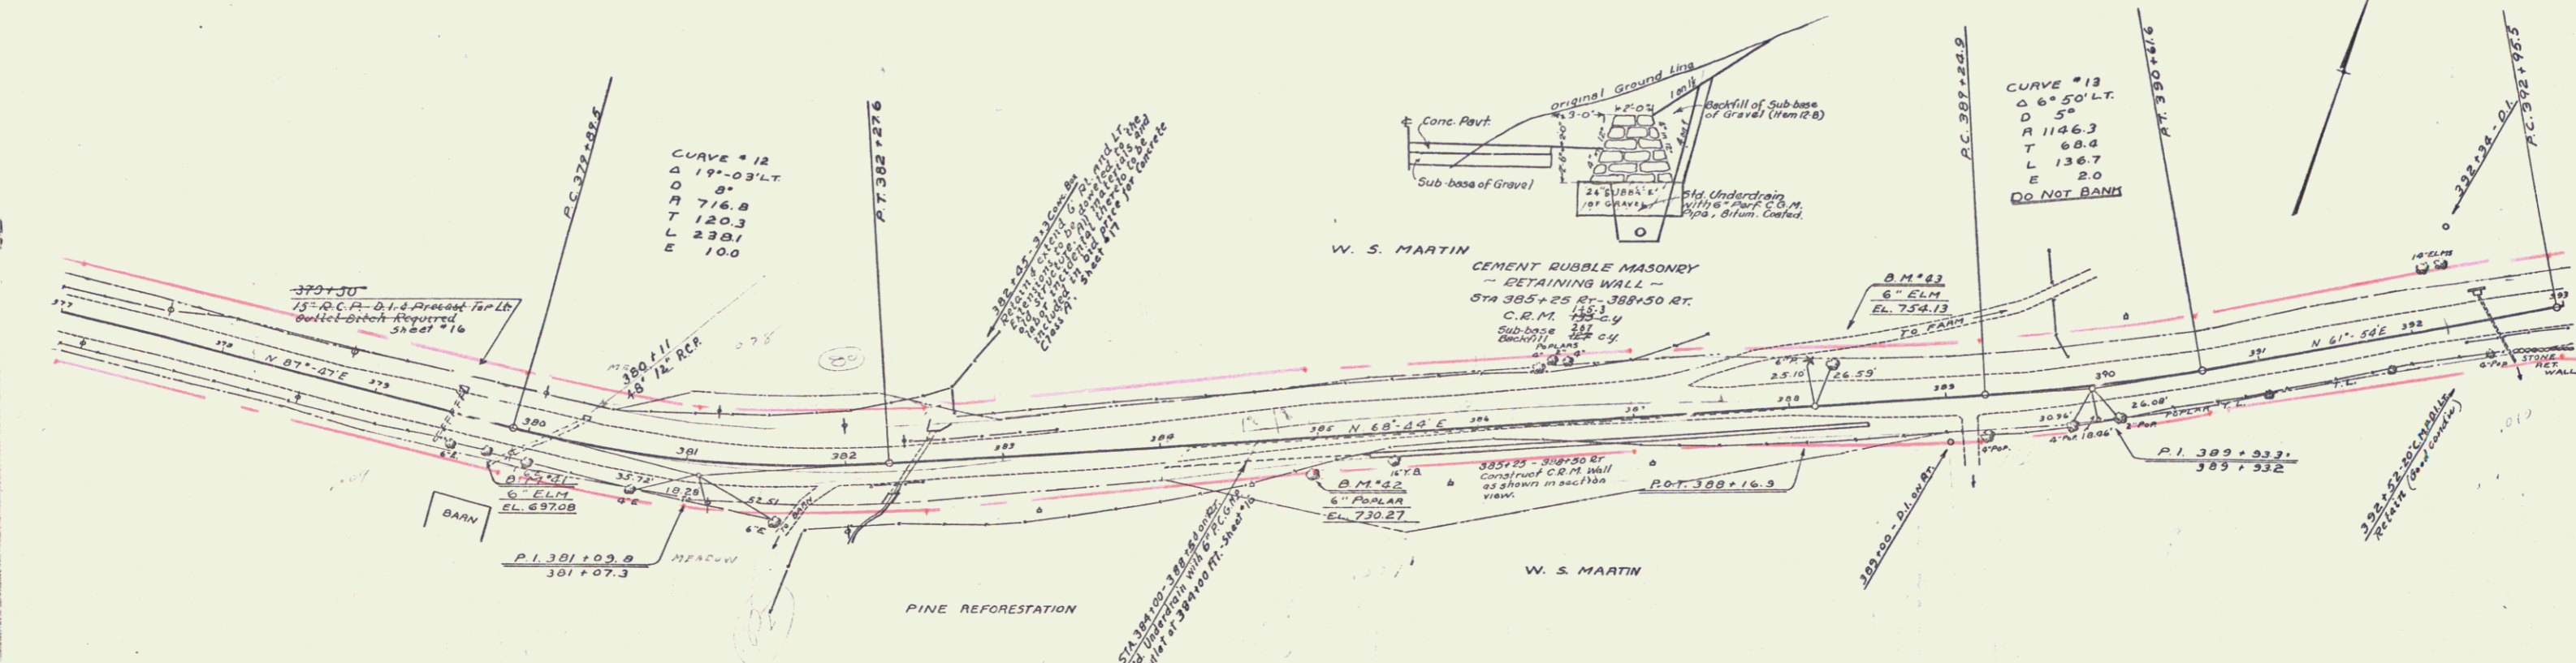

B.M. #41 SPIKE IN TRUNK 6" ELM 17.5 FT AT STA 379+70 ELEV 697.08
 B.M. #42 SPIKE IN TRUNK 6" POPLAR 21 FT AT STA 384+94 ELEV 730.27
 B.M. #43 SPIKE IN ROOT 6" ELM 20.5 FT LT STA 388+28 ELEV 750.13

SERIES F-NO 97-E
 SHEET 12 OF 45

10